

Thursday, July 17, 2025, 8:30 AM
BUENA PARK CITY HALL - MAIN CONFERENCE ROOM
6650 BEACH BLVD
BUENA PARK, CA 90621-2905

ZONING ADMINISTRATOR
AGENDA

8:30 a.m.

Members of the public who wish to discuss an item should fill out a speaker identification card and hand it to the secretary. When the item is announced by the Zoning Administrator, speakers should come forward, and upon recognition by the Zoning Administrator, state their names and addresses.

Members of the public may also submit their comments in writing for the Zoning Administrator by sending them to the Community and Economic Development Department at bpplancomments@buenapark.com. Please submit all comments by 8:00 a.m. on Thursday, July 17, 2025. Please contact the Planning Division at (714) 562-3620 for any questions.

All actions by the Zoning Administrator are final unless an appeal to the City Council is filed with the City Clerk within ten (10) working days of the decision.

Appeal period ends on August 5, 2025.

1. GENERAL

1.A. CALL TO ORDER

2. PUBLIC HEARING

2.A. SITE PLAN NO. SP-25-8

A request to construct a 328 square-foot single-story addition to the rear (south) elevation of an existing 980 square-foot single-story, single-family dwelling at 5866 Panama Dr. The addition will bring the total size of the single-family dwelling to 1,308 square feet with a total of three (3) bedrooms, two (2) bathrooms, and a 446 square-foot attached two-car garage.

The property owner is Yuri Salmeron, 5866 Panama Dr., Buena Park, CA 90620. The applicant is Allan Cabrera, 2402 W. Almond Avenue, Orange, CA 92868.

The project is Categorically Exempt, pursuant to Section 15301 (Existing Facilities) Class 1 of the State California Environmental Quality Act (CEQA) Guidelines.

— RECOMMENDED ACTION: Adopt Resolution with Conditions of Approval approving Site Plan No. SP-25-8.

2.B. SITE PLAN NO. SP-25-9

A request to construct a 353 square-foot single-story addition to the rear (east) elevation of an existing 824 square-foot single-story, single-family dwelling at 5962 Rand Street. The proposed project will result in a 1,177 square-foot single-story, single-family dwelling with three (3) bedrooms, two (2) bathrooms, and a 360 square-foot detached two-car garage.

The property owners/applicants are Irais L. and Sandra J. Verduzco, 5962 Rand Street, Buena Park, CA 90621.

The project is Categorically Exempt, pursuant to Section 15301 (Existing Facilities) Class 1 of the State California Environmental Quality Act (CEQA) Guidelines.

— RECOMMENDED ACTION: Adopt Resolution with Conditions of Approval approving Site Plan No. SP-25-9.

3. ADJOURNMENT

3.A. Adjournment

This agenda contains a brief general description of each item to be considered. Supporting documents are available for review and copying at City Hall or at www.buenapark.com. Supplementary materials distributed to the Zoning Administrator less than 72 hours before the meeting are posted to the City's website at www.buenapark.com and copies are available for public inspection beginning the next regular business day. This governing body is prohibited from discussing or taking action on any item which is not included in this agenda; however, may ask clarifying questions, ask staff to follow-up, or provide other direction. The order of business as it appears on this agenda may be modified by the governing body.

In compliance with the Americans with Disabilities Act, if you need accommodations to participate in this meeting, contact the City Clerk's Office at (714) 562-3750 or the California Relay Service at 711. Notification at least 48 hours prior to the meeting will enable the City to make arrangements to assure accessibility.

I, Ruth Santos, City of Buena Park, do hereby certify, under penalty of perjury under the laws of the State of California that a full and correct copy of this agenda was posted pursuant to Government Code Section 54950 et. seq., at Buena Park City Hall, 6650 Beach Blvd., and uploaded to the City of Buena Park website www.buenapark.com.

Ruth Santos
Sr. Administrative Assistant

Date Posted: July 10, 2025



Zoning Administrator Agenda Report

SITE PLAN NO. SP-25-8

PREPARED BY	PRESENTED BY
MOISES LOMELI, PLANNING TECHNICIAN	MOISES LOMELI, PLANNING TECHNICIAN
REVIEWED AND APPROVED BY	DIRECTOR APPROVAL
HARALD LUNA, PLANNING MANAGER	MATT FOULKES, DIRECTOR OF COMMUNITY AND ECONOMIC DEVELOPMENT

RECOMMENDED ACTION

1) Conduct a public hearing; and 2) thereafter, based on the analysis provided in this agenda report and facts and findings provided in the attached Resolution, Staff recommends that the Zoning Administrator adopt the attached Resolution approving Site Plan Review No. SP-25-8 and find that the project is Categorically Exempt, per Section 15301 (Existing Facilities) Class 1 of the California Environmental Quality Act (CEQA) Guidelines based on the findings of fact and conditions provided herein.

PROPERTY INFORMATION:

Address / Assessor Parcel Number (APN):	5866 Panama Drive 263-225-11
Lot Area:	6,000 square feet
Street Frontage:	60 feet
Zoning District:	RS-6 (One-Family Residential Zone)
General Plan Designation:	Low Density Residential
Existing Development:	980 square-foot single-story, single-family dwelling with an attached 446 square-foot two-car garage

SURROUNDING LAND USE CHARACTERISTICS:

	GENERAL PLAN	ZONING	EXISTING LAND USE
North	Low Density Residential	RS-6 (One-Family Residential)	Single-family dwelling
South	Low Density Residential	RS-6 (One-Family Residential)	Single-family dwelling
East	Low Density Residential	RS-6 (One-Family Residential)	Single-family dwelling
West	Low Density Residential	RS-6 (One-Family Residential)	Single-family dwelling

APPLICATION ANALYSIS:

Project Description:

The Applicant is requesting to construct a 328 square-foot single-story addition to the rear (south) elevation of an existing 980 square-foot single-story, single-family. The addition will bring the total size of the single-family dwelling to 1,308 square feet with a total of three (3) bedrooms, two (2) bathrooms, and a 446 square-foot attached two-car garage.

Development Standards Analysis:

Development Standards	Required	Proposed
Lot Coverage:	40% maximum	29.5%
Rear Yard Coverage:	30% maximum	0%
Setbacks:	Front: 20 ft. minimum Side: 5 ft. minimum (not abutting a street) Rear: 25 ft. minimum	Front: 20 ft. 6 in. Side: East 5 ft. West 5 ft. Rear: 30 ft. 2in.
Parking:	2-car garage	2-car attached garage 446 square feet
Front Yard Landscape:	30% minimum	57.9%

Discussion:

Section 19.128.040 (Site Plan Review) of the City of Buena Park Municipal Code (BPMC) requires Zoning Administrator review and approval of any addition or conversion of non-habitable areas into habitable area that causes the total residential floor area to exceed 1,100 square feet, via the Site Plan Review process.

The goal of the Site Plan Review process is to ensure that the project meets all development standards of the zoning district, and is in “reasonable harmony with the architectural character of the area” and not “detrimental to the existing and intended character” of the surrounding neighborhood. This process furthers the General Plan Policy LU-7.1 to “maintain and enhance the character of single-family residential neighborhoods.”

The proposed expansion complies with all development standards for single-family residences within the RS-6 (One-Family Residential) zone such as setbacks, height, lot coverage, and parking.

Guidelines for Single-Family Residential Additions:

The proposed architectural design of the addition to the existing single-story single-family dwelling will be consistent with the character of the existing single-family residence and residential neighborhood. The request complies with the Guidelines for Single-Family Residential Additions adopted by City Council for promoting high-quality additions compatible with adjacent properties, as listed below.

Roofs: New roofs shall blend with existing rooflines and be of unified materials.

The roof design and rooflines of the addition will consist of a gable-roof design. The roof materials of the additions to the single-family dwelling will be comprised of composition shingle roof to match the roof of the existing dwelling.

Enhanced Exteriors: Elevations to include superior finished, materials, and colors.

The proposed addition area provides a stucco finish to match the existing house that will be painted to match. The front (north) elevation of the single-family dwelling features a combination of brick planters, white vinyl trim on the windows, and a decorative roof eave wood fascia on the garage. Additional proposed enhancements include a four (4)-inch stucco foam trim around the doors and windows of the front elevation and a decorative light fixture.

Balconies: Balconies shall include appropriate design and/or location for screening or obscuring the balcony to minimize the loss of privacy for neighboring properties.

The proposed project does not include balconies.

Windows: Windows shall include decorative treatment and windows located on the same elevation shall be consistent in design, style, and materials.

The proposed vinyl framed windows will be consistent in style, design, operation, and materials throughout the residence. Additionally, the windows and doors will feature a decorative stucco trim to further enhance the elevations of the home.

Landscape: Sufficient size and quantities shall be installed to provide screening and to protect the privacy of adjacent properties.

The proposed expansion is setback at the required distances to protect privacy of adjacent properties. The applicant has proposed, and as conditioned, to provide an approximately 2-foot wide by 21-foot-long landscape planter area adjacent to the east side of the driveway and within the front yard area. No additional landscaping is required.

After reviewing the applicant's request and plans, staff visited the property and reviewed the site and building configuration as well as layout of the surrounding properties, and has determined that the site can accommodate the proposed expansion of the existing single-story single-family dwelling. When completed, the materials and color scheme of the proposed expansion of the single-story single-family dwelling will blend with the overall architectural character of the surrounding area; therefore, preserving the residential integrity of the existing residential neighborhood and will not impose any adverse impacts on adjacent properties.

ENVIRONMENTAL ASSESSMENT:

The project is Categorically Exempt, pursuant to Section 15301 (Existing Facilities) Class 1 of the State California Environmental Quality Act (CEQA) Guidelines, because the project consists of the addition of floor area to an existing single-family residence.

PUBLIC HEARING NOTIFICATION:

Notice of public hearing was posted at the Buena Park City Hall, the Buena Park Library, and Ehlers Event Center on July 7, 2025; and eight (8) notices were mailed to adjacent property owners of the subject property on July 7, 2025. As of the date of publication of this report, the City has not received any inquiries or letters regarding the proposed action.

Reviewed and Approved by: Harald Luna, Planning Manager

Attachments

[PROPOSED ZONING ADMINISTRATOR SP 25-8 RESOLUTION FOR SITE PLAN NO. SP-25-8.pdf](#)

[SP-25-8 DEVELOPMENT PLANS stamped RECEIVED JUL 2 2025 PLANNING DIV.pdf](#)

[SP-25-8 VICINITY MAP.pdf](#)

RESOLUTION NO.
SITE PLAN NO. SP-25-8

A RESOLUTION OF THE ZONING ADMINISTRATOR OF THE CITY OF BUENA PARK APPROVING A SITE PLAN REQUEST TO ALLOW FOR THE DEVELOPMENT OF A 328 SQUARE-FOOT SINGLE-STORY ADDITION TO THE REAR (SOUTH) ELEVATION OF AN EXISTING 980 SQUARE-FOOT SINGLE-STORY SINGLE-FAMILY DWELLING, LOCATED AT 5866 PANAMA DRIVE, WITHIN THE RS-6 (ONE-FAMILY RESIDENTIAL) ZONE, WITH FINDINGS

A. Recitals.

(i) Allan Cabrera, the applicant, 2402 W. Almond Avenue, Orange, CA 92868, on behalf of Yuri Salmeron, the property owner for 5866 Panama Drive, Buena Park, CA 90620, have filed an application for the issuance of Site Plan No. SP-25-8 to construct a 328 square-foot single-story addition to the rear (south) elevation of an existing 980 square-foot single-story, single-family dwelling located at 5866 Panama Drive. The proposed project will result in a 1,308 square-foot single-story, single-family dwelling with three (3) bedrooms, two (2) bathrooms, and a 446 square-foot attached two-car garage on a property at 5866 Panama Drive, Buena Park, CA 90620 (APN: 263-225-11) in the County of Orange. Hereinafter in this Resolution, the subject Site Plan request is referred to as the "Application."

(ii) On July 17, 2025, the Zoning Administrator conducted a hearing on the application and concluded said hearing prior to the adoption of this Resolution.

(iii) All legal prerequisites to the adoption of this Resolution have occurred.

B. Resolution.

NOW THEREFORE, it is found, determined, and resolved by the Zoning Administrator of the City of Buena Park as follows:

1. The Zoning Administrator hereby specifically finds that all the facts set forth in Recitals, Part A, of this Resolution are true and correct.

2. Based upon substantial evidence presented to the Zoning Administrator during the above-referenced hearing, including written staff reports, verbal testimony, and development plans dated "RECEIVED JULY 2 2025 PLANNING DIV", the Zoning Administrator hereby specifically finds as follows:

a. **FINDING:** The proposed development meets all applicable requirements of this Title and other laws.

FACT: The proposed addition to the single-family dwelling complies with all applicable requirements of the General Plan and Zoning Ordinance including lot coverage, setbacks, floor plan, parking, and building materials, as conditioned. The architectural design, materials, finishes and color

scheme will blend with the overall character and color palette of the single-family dwellings from the surrounding area.

- b. **FINDING:** The site arrangement and improvements will not be detrimental to the existing and intended character of the area as defined by the General Plan, any applicable specific plans, and this Title.

FACT: The site arrangement and improvements will not be detrimental to the existing and intended character of the residential neighborhood since the proposed addition to the single-family dwelling comply with the General Plan and the Zoning Ordinance. The design of the proposed addition to the single-family dwelling meets all applicable standards and criteria and will maintain the residential character of the neighborhood.

- c. **FINDING:** Property values will be conserved.

FACT: The proposed addition will not negatively impact the property in question nor will it negatively impact surrounding properties since all improvements meet the Buena Park Municipal Code requirements as well as the Guidelines for Single-Family Residential Additions adopted by City Council for the purpose of promoting high-quality additions compatible with adjacent properties.

- d. **FINDING:** Effective and satisfactory methods are provided to protect nearby structures and activities from noise, vibration, and other adverse environmental effects generated by the subject development.

FACT: The proposed addition will not create any detrimental effects on the environment since the area was planned for residential developments, and the project site will retain the development of a single-family residence.

- e. **FINDING:** The exterior architectural design is in reasonable harmony with the architectural character of the area.

FACT: The exterior architectural design is in reasonable harmony with the architectural character of the surrounding area. All building materials, colors and finishes will match the existing house, as conditioned.

- f. **FINDING:** The arrangement and design for pedestrian and vehicular traffic will minimize congestion and protect pedestrian and vehicular safety.

FACT: The arrangement and design for pedestrian and vehicular traffic will continue to minimize congestion and protect pedestrian and vehicular safety for the subject property as well as surrounding properties. No changes are proposed to the existing pedestrian or vehicular access to and from the property.

3. The Zoning Administrator hereby finds and determines that the project identified above in this Resolution is Categorically Exempt from the requirements of the California

Environmental Quality Act (CEQA) of 1970, as amended, and the Guidelines promulgated thereunder pursuant to Class 1 Section 15301 (Existing Facilities) of Division 6 of Title 14 of the California Code of Regulations.

4. Based upon the findings and conclusions set forth in paragraphs 1, 2, and 3 above, this Zoning Administrator hereby approves the application subject to the plans dated "RECEIVED JULY 2 2025 PLANNING DIV." as modified herein and the following reasonable conditions set forth in paragraph 5 of this Resolution.

5. The following conditions are deemed necessary to protect the public health, safety, and general welfare and are reasonable and proper in accordance with the purpose and intent of the Buena Park City Code.

BUILDING DIVISION:

1. The project shall comply with the California Building Codes as adopted and amended by the City of Buena Park Municipal Code Title 15.
2. After the public hearing appeal period ends, applicant shall submit three (3) sets of construction plans to the Building Division for plan check in order to obtain required building permits.

PLANNING DIVISION:

1. This approval shall permit the construction of a 328 square-foot single-story addition to the rear (south) elevation of an existing 980 square-foot single-story single-family dwelling with an attached 446 square-foot two-car garage in substantial compliance with the plans dated "RECEIVED JUL 2 2025 PLANNING DIV" and as conditioned herein.
2. The applicant and/or property owner shall ensure that a copy of the Zoning Administrator Resolution, including all conditions of approval, be reproduced on the first pages of construction drawings and shall be distributed to all design professionals, contractors, and subcontractors participating in the construction phase of the project.
3. Plans submitted for plan check shall include the remodel and addition to the single-family residence, generally consistent with the submitted plans. Specifications and samples of the following shall be submitted to the Planning Division for approval prior to issuance of building permits:
 - a. Paint colors for stucco
 - b. Roofing material consisting of composition shingles
 - c. Door and window trims
4. The applicant shall require a separate fence/wall permit approval by the Planning Division for any proposed fences/walls to be located within the property.
5. Any fencing shown on plans shall comply with the Buena Park Municipal Code (BPMC) Chapter 19.328 (Development Standards – Fences, Walls, Hedges, and Berms) of the City of Buena Park Zoning Ordinance and shall require separate approval by the Planning Division, as necessary.

6. Any proposed driveway modification shall require separate Planning Division review and shall comply with Section 19.336.040 (Residential Driveway Standards) of the Buena Park Municipal Code.
7. The applicant shall demonstrate that proposed building materials, and other architectural/site features are rated for appropriate durability and longevity. Final plans shall incorporate all changes as conditioned herein and shall recognize all easements or deed restrictions pertaining to the subject property. Any appreciable modification shall require the prior approval of the Planning Division.
8. All on-site landscaping, including the front yard and parkway areas, which are damaged during construction shall be revitalized upon completion of construction, as necessary, prior to final building permits. All landscaping, including the parkway, shall be maintained in a healthy, green, pruned, growing condition.
9. Any installation of artificial turf shall require a separate Planning Division review and shall comply with BPMC Section 19.332.010 (Landscape Provisions for Residential Uses).
10. A minimum two (2') foot wide landscape planter shall be installed within the required front yard area adjacent to the east side of the driveway. The new landscape planter shall include six (6) 5-gallon minimum size plants with weed barrier and decorative ground cover. The plants located within the vision clearance area shall be maintained at a height of 2 feet tall maximum at all times.
11. No roof-mounted mechanical equipment shall be permitted unless such equipment is not visible from adjacent and surrounding properties and streets from a height of five (5) feet above ground level. The installation and screening of air conditioning and similar equipment shall comply with existing design criteria and BPMC Section 19.340.020 (Visual Screening of Mechanical Equipment).
12. Interior access to all rooms/areas of the single-family dwelling shall be maintained at all times as a condition of use. No sections shall be partitioned off and provided solely with exterior access. In addition, no secondary kitchen or other cooking facilities shall be provided.
13. The construction authorized by the Site Plan shall be started within one (1) year of the expiration of the appeal period and thereafter diligently advanced until completion of the project.
14. This approval may be revoked for any violation of noncompliance with any of these conditions in accordance with BPMC Section 19.132.030 (Revocation) of the Zoning Ordinance.
15. Prior to final inspection, these conditions and all improvements shall be completed to the satisfaction of the City.
16. The project and/or use authorized by this approval shall at all times comply with all applicable local, state, and federal ordinances, statutes, standards, codes, laws, policies, and regulations.

17. The applicant and/or property owner shall sign an Affidavit of Acceptance of all conditions of approval and return it to the Planning Division within thirty (30) days after the effective date of this approval or prior to the issuance of a building permit or certificate of occupancy, whichever may occur first.
18. The applicant shall indemnify, defend, and hold harmless the City, its officers, agents, and employees from any claims and losses whatsoever occurring or resulting to any and all persons, firms, or corporations furnishing or supplying work, services, materials, or supplies in connection with the performance of the use permitted hereby or the exercise of the rights granted herein, any and all claims, lawsuits or actions arising from the granting of or exercise of the rights permitted by this approval and from any and all claims and losses occurring or resulting to any person, firm, or corporation, or property damage, injury, or death arising out of or connected with the performance of the use permitted hereby. Applicant's obligation to indemnify, defend, and hold harmless the City as stated hereinabove shall include, but not be limited to, paying all fees and costs incurred by legal counsel of the City's choice in representing the City in connection with any such claims, losses, lawsuits, or actions, and any award of such damages, judgments, verdicts, court costs or attorneys' fees in any such lawsuit or action.

PASSED AND ADOPTED this 17th day of July 2025.

Eddie Fenton
Zoning Administrator

ATTEST:

Harald Luna, Planning Manager


Resolution No.
Site Plan No. SP-25-8
July 17, 2025

AFFIDAVIT OF ACCEPTANCE:

I/ We do hereby accept all of the conditions contained in this document and all other conditions imposed by Site Plan No. SP-25-8 and do agree that I/We shall conform with and abide by all such conditions.

Date: _____

Printed Name and Signature
Owner/Applicant

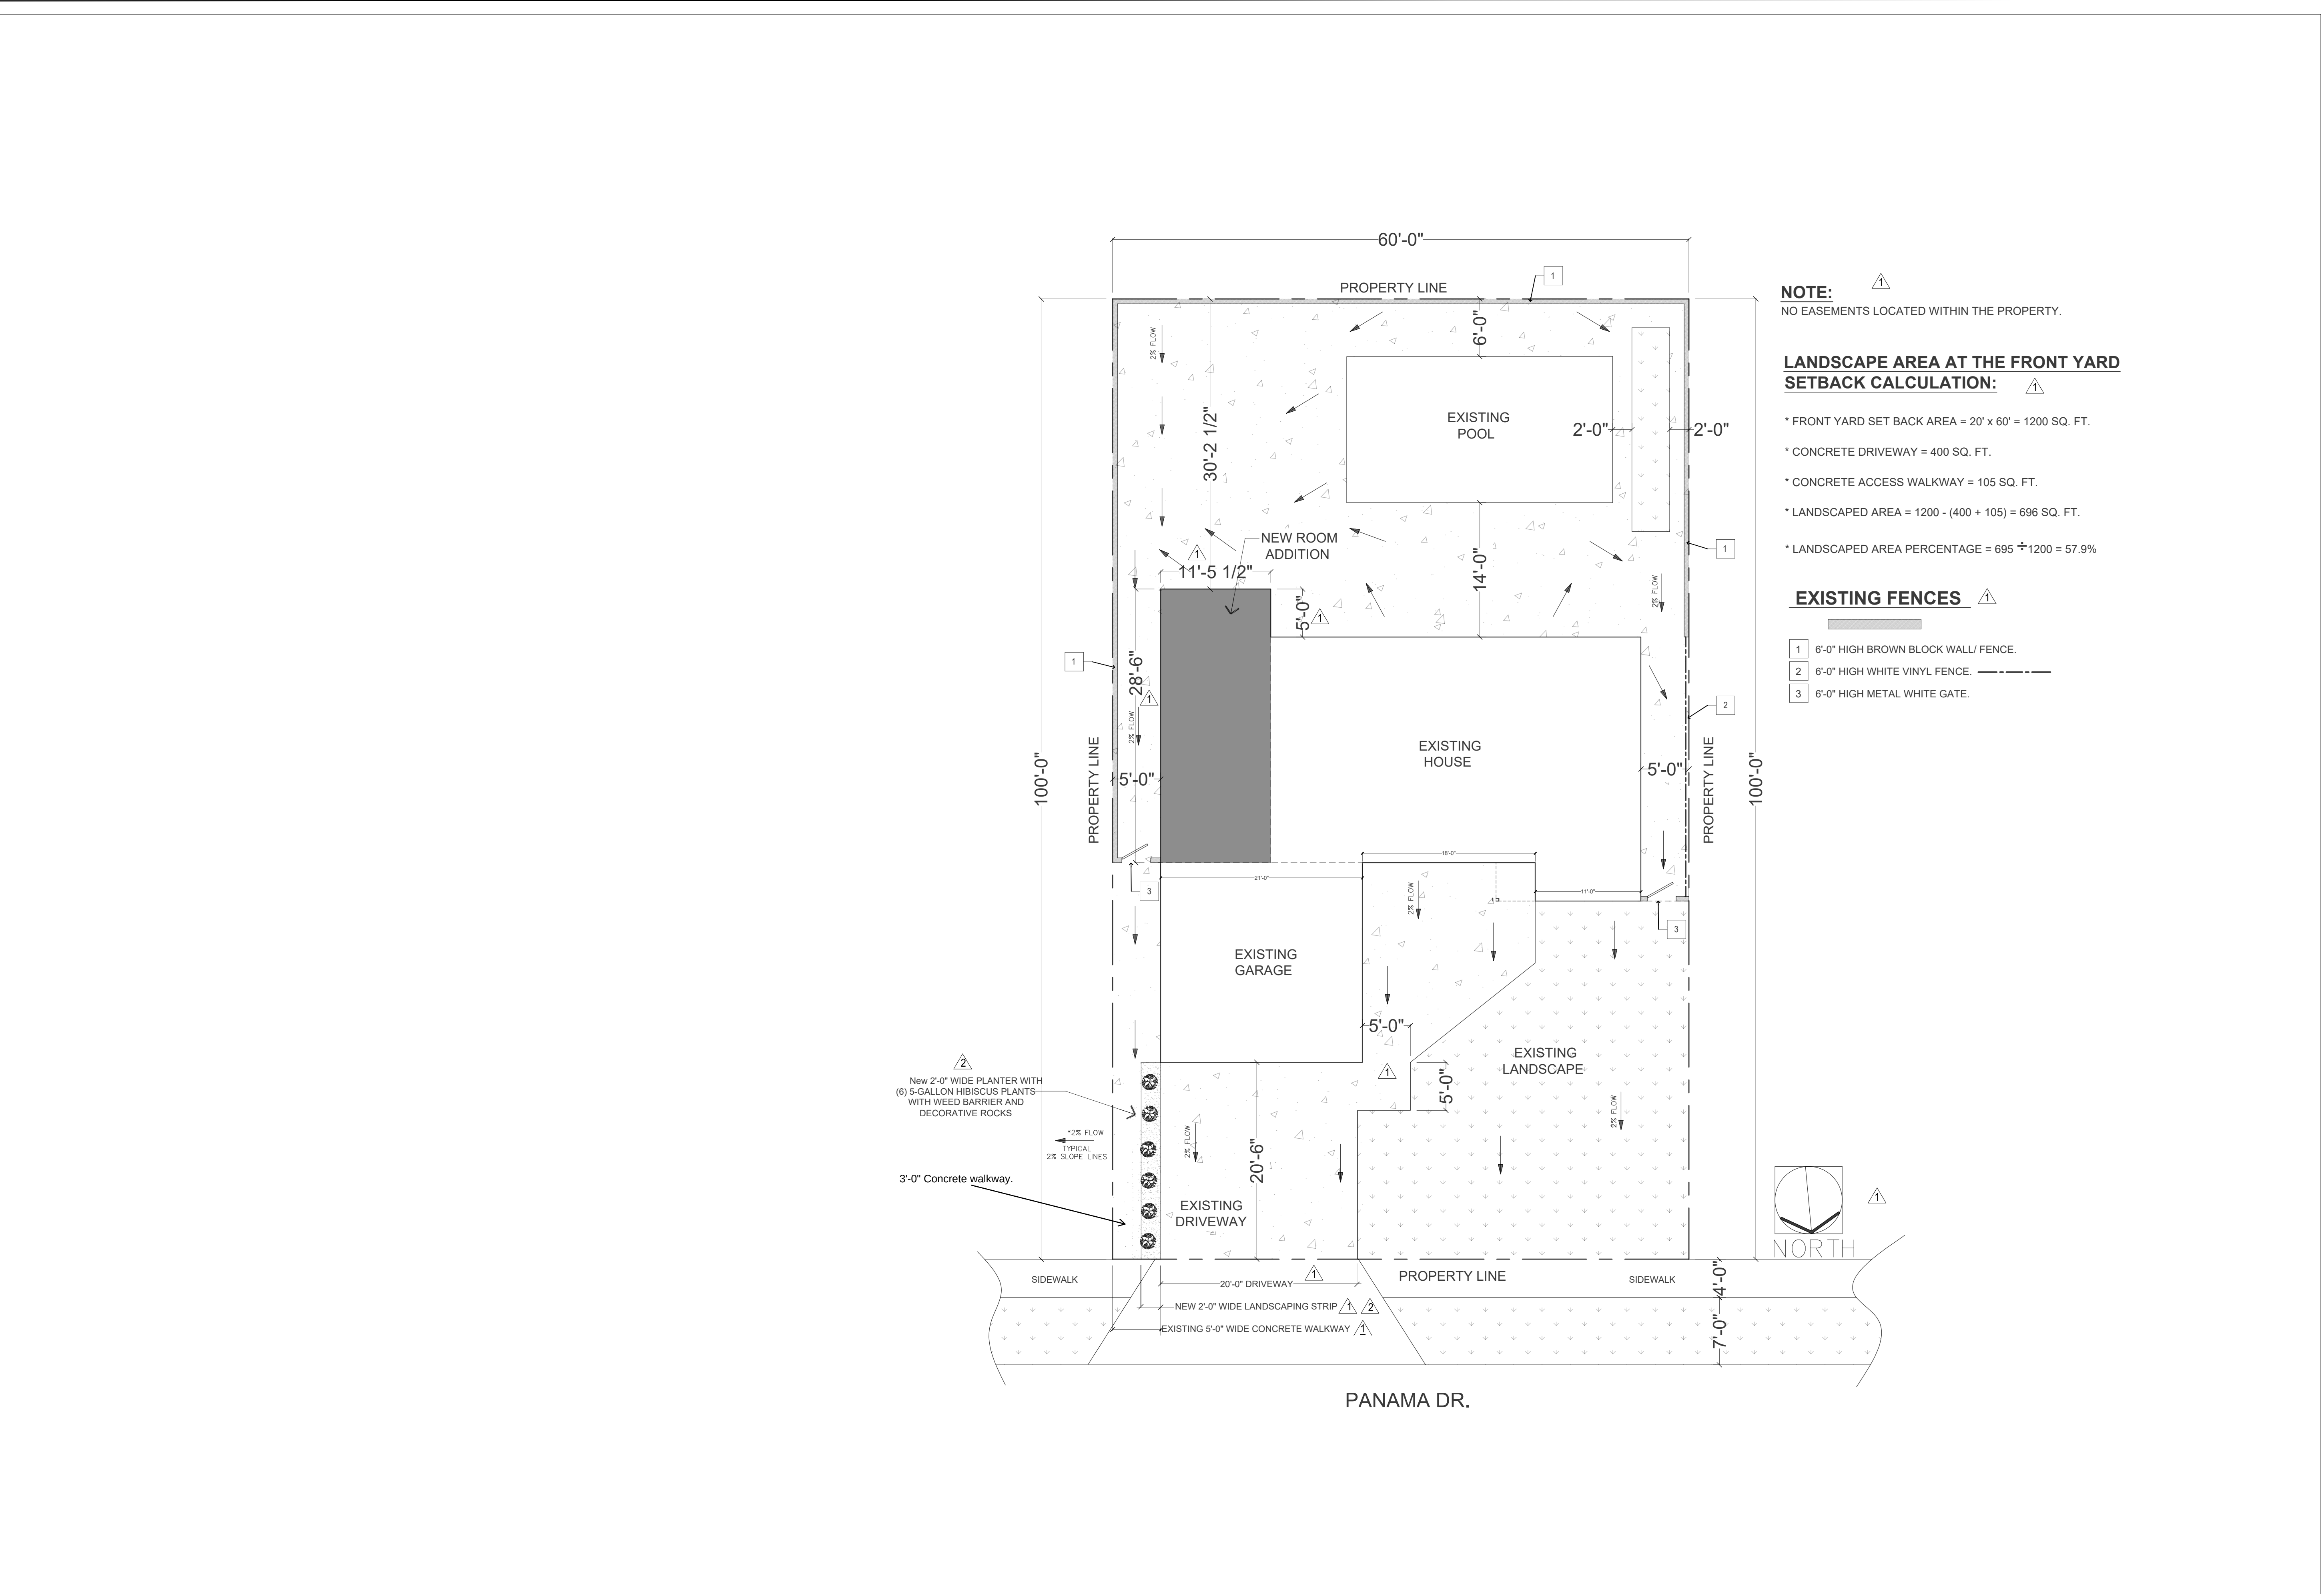

REVISIONS	DATE
1st PLAN CHECK	9/29/23
2nd PLAN CHECK	6/11/25

BASIL AMMARI P.E.
202 AMBLING DR.
BREA, CA 92821
TEL: 714-332-0087


PROPOSED ADDITION FOR:
YURI SALMERON
5866 PANAMA DR.
BUENA PARK, CA 90620

SITE PLAN



BASIL AMMARI


DRAWN BY DR
CONSULTANT / DESIGNER SIGNATURE
DATE 6/11/2025
SCALE 1/8" = 1'-0"
JOB NO.
SHEET A2

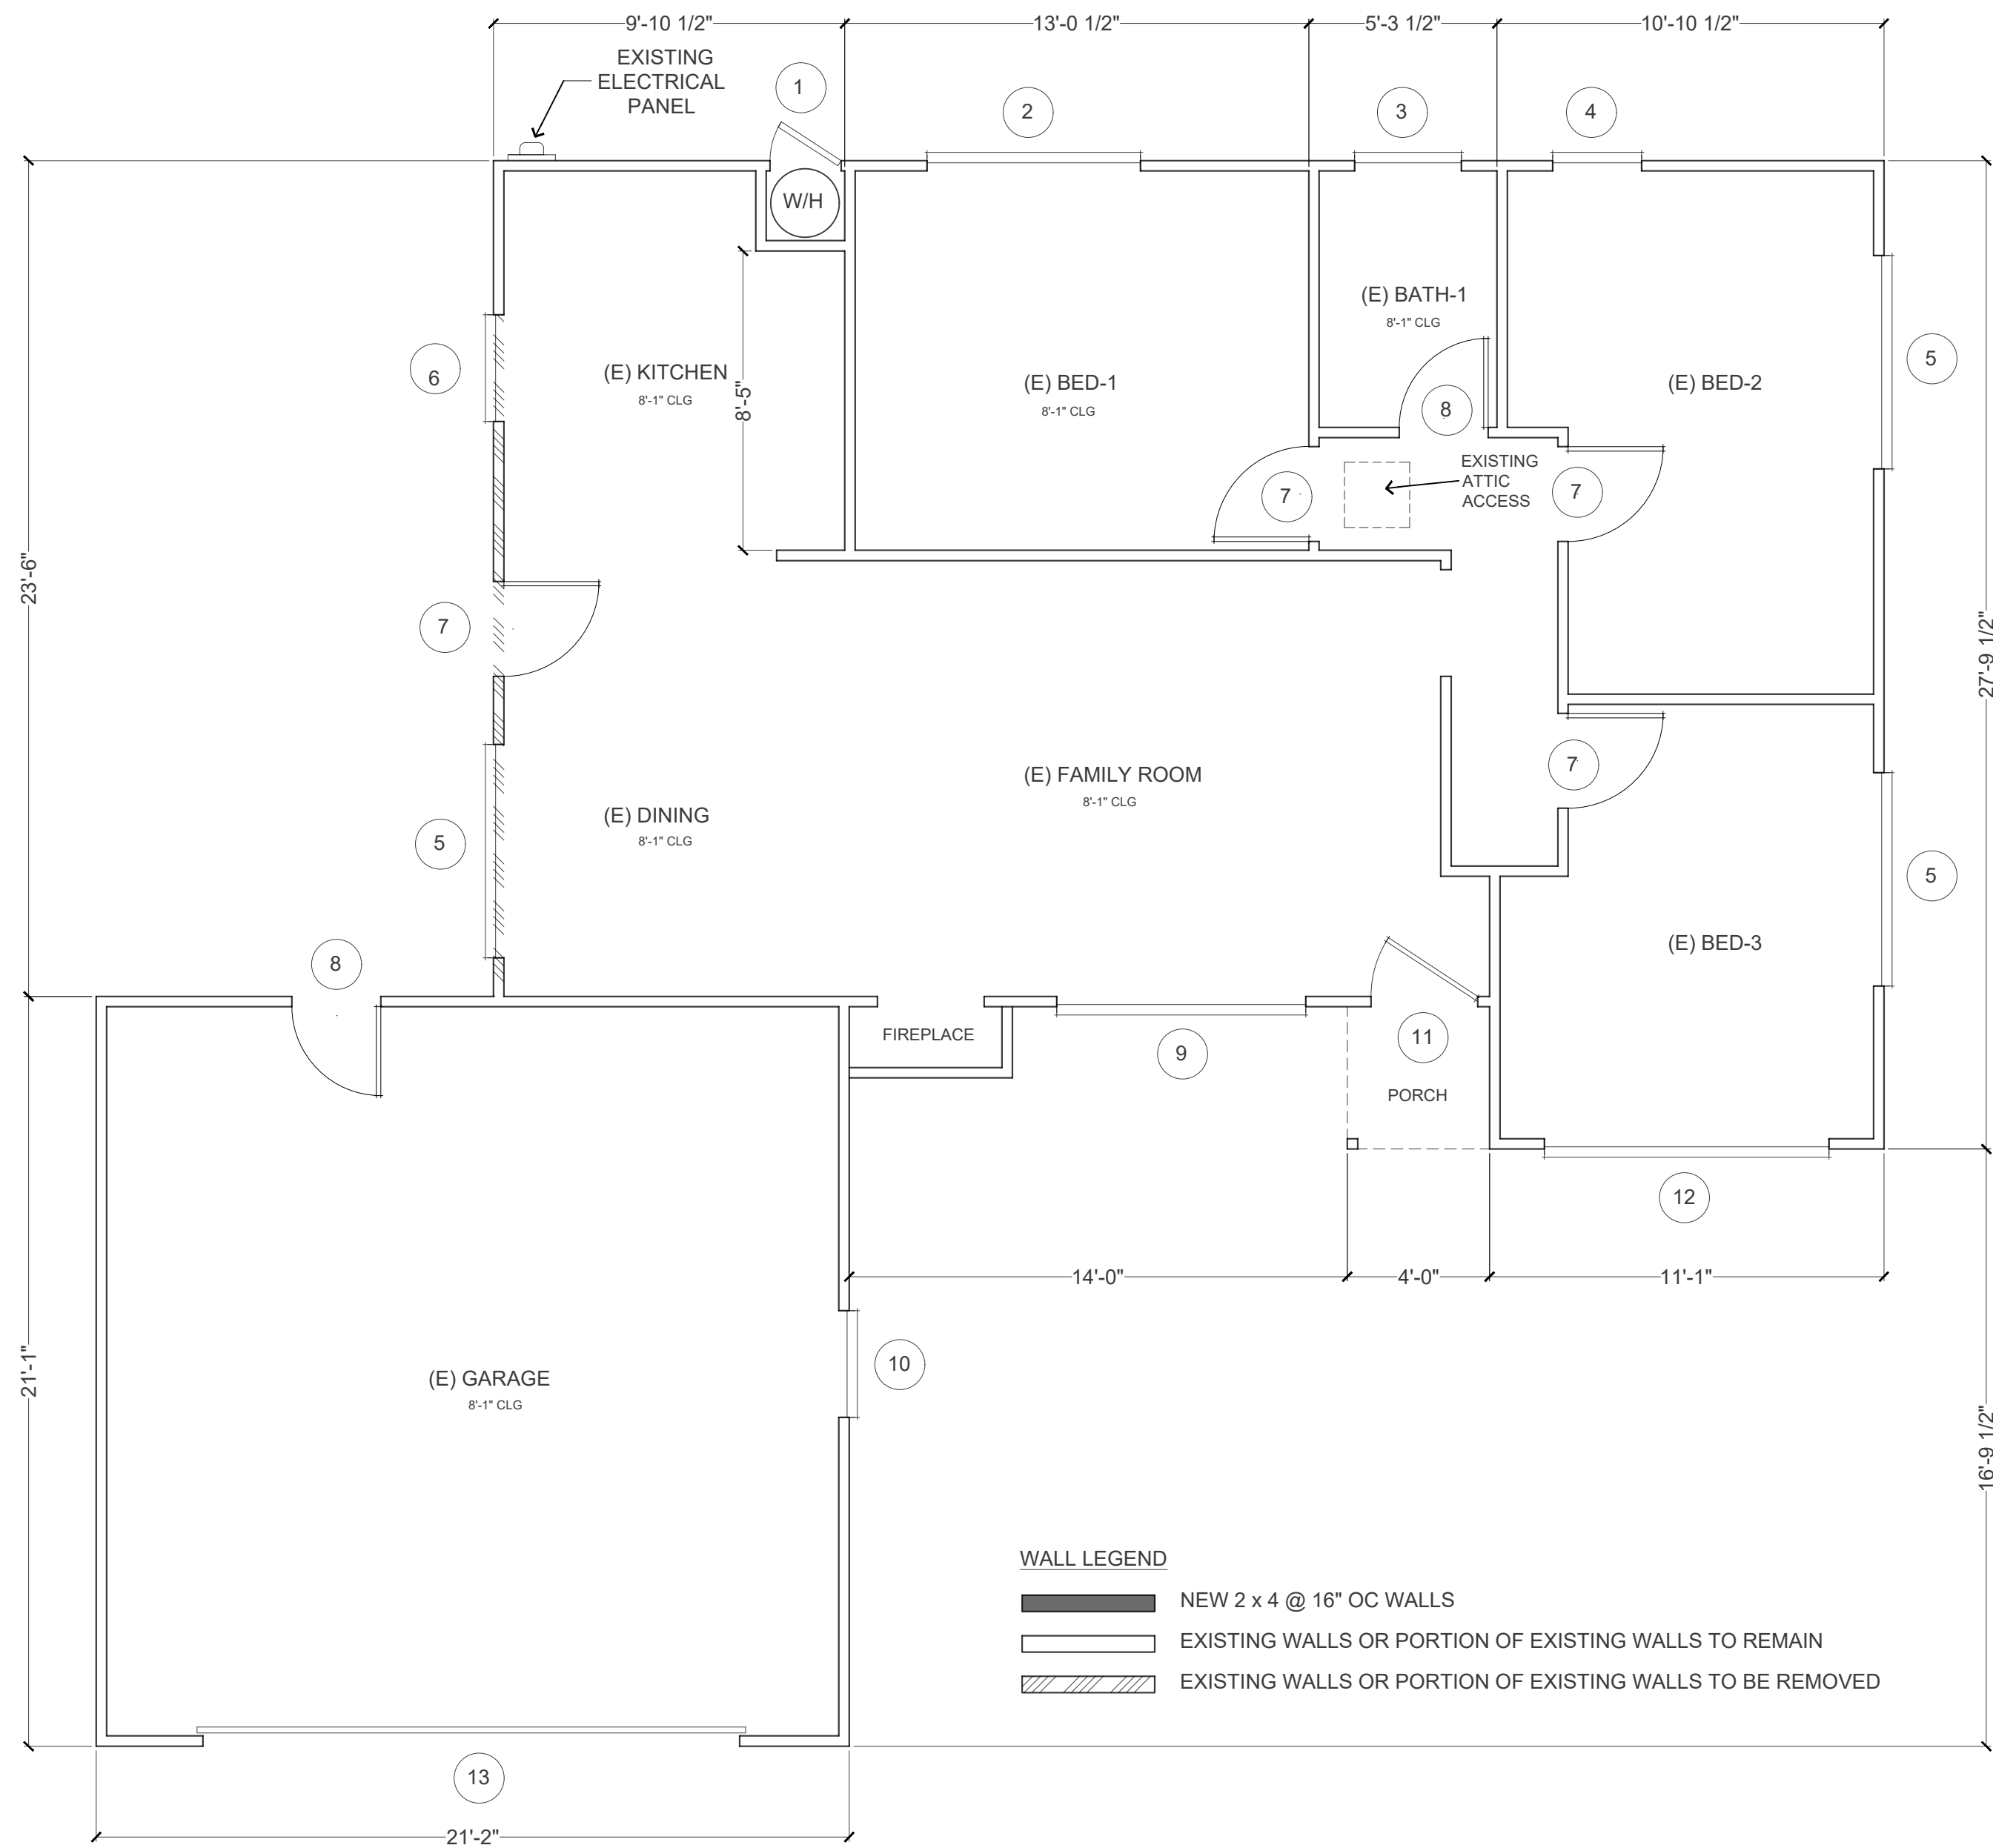

EXISTING FLOOR PLAN 1/4"=1'-0"

EXISTING WINDOW & DOOR SCHEDULE

- 1 2'-0" x 6'-8" WOOD DOOR.
- 2 6'-0" x 3'-0" VINYL SLIDING WINDOW.
- 3 3'-0" x 9" VINYL SLIDING WINDOW.
- 4 2'-6" x 4'-0" VINYL SINGLE HUNG WINDOW.
- 5 6'-0" x 4'-0" VINYL SLIDING WINDOW.
- 6 3'-0" x 3'-0" VINYL SLIDING WINDOW.
- 7 2'-8" x 6'-8" WOOD DOOR.
- 8 2'-6" x 6'-8" WOOD DOOR.
- 9 7'-0" x 4'-6" VINYL SLIDING WINDOW.
- 10 3'-0" x 3'-0" VINYL FIXED GLASS WINDOW.
- 11 3'-0" x 6'-8" WOOD DOOR.
- 12 8'-0" x 3'-6" VINYL SLIDING WINDOW.
- 13 GARAGE DOOR

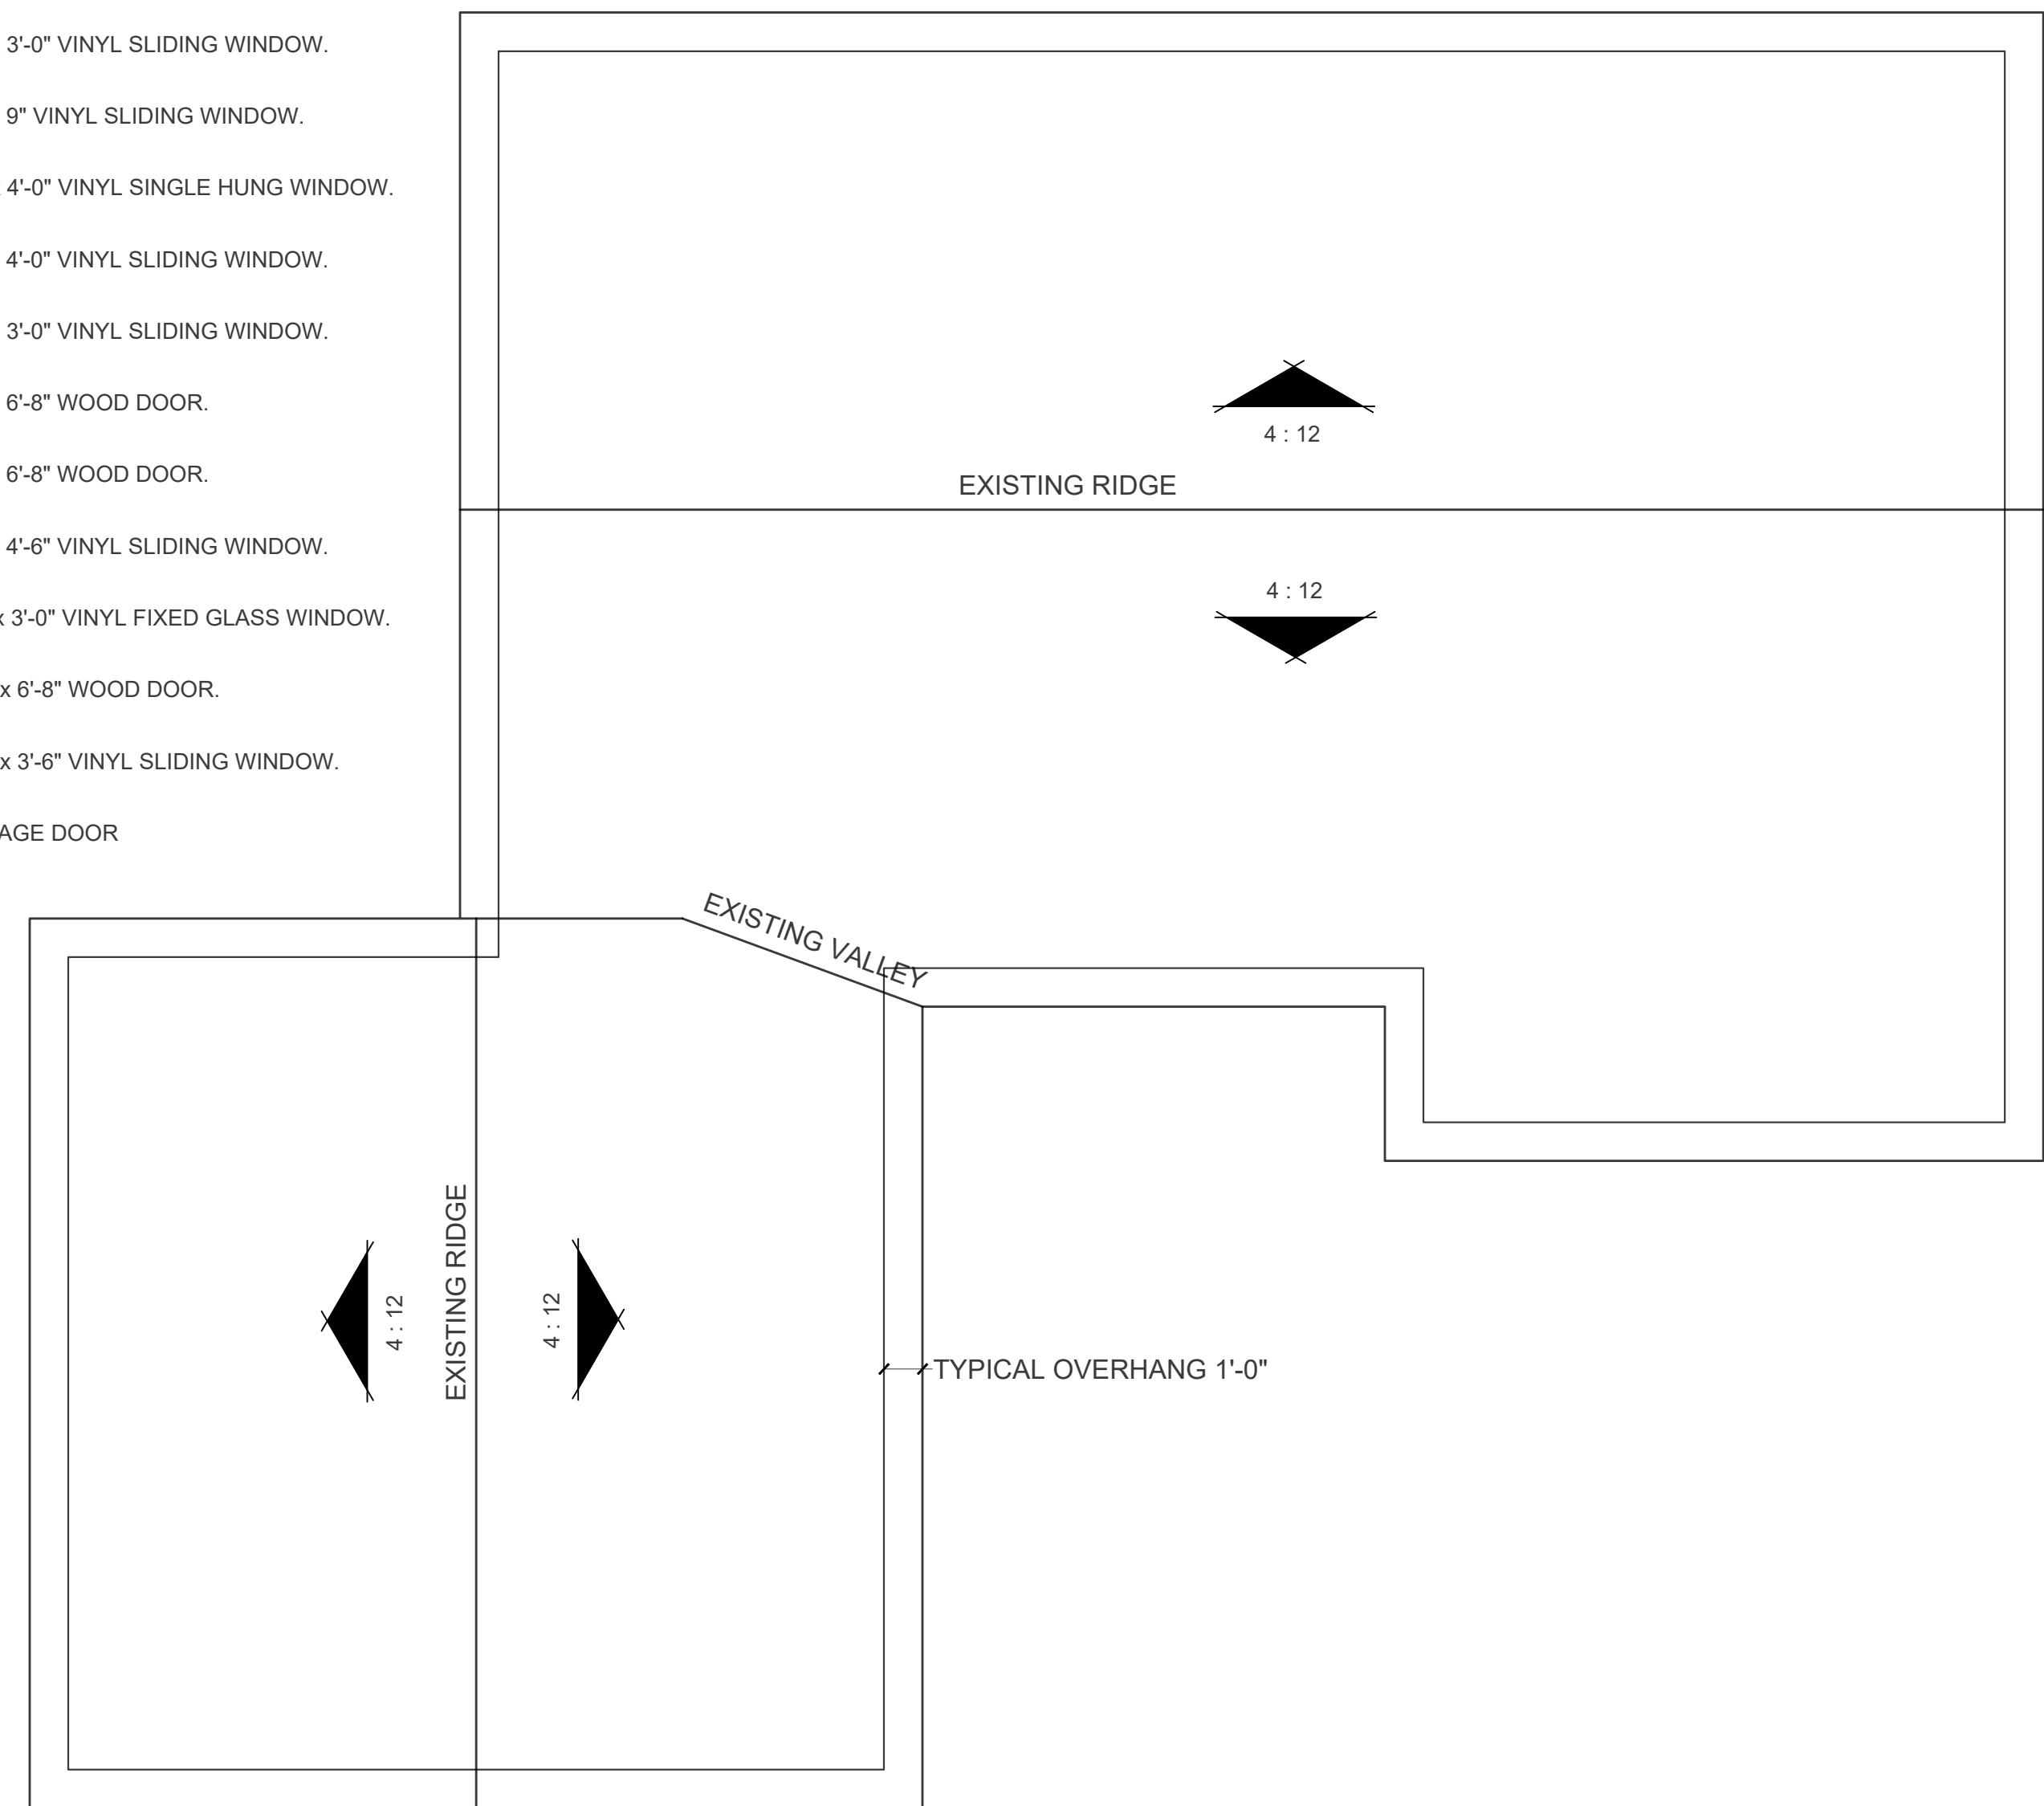

EXISTING ROOF PLAN 1/4"=1'-0"

REVISIONS	DATE
1st PLAN CHECK	9/29/23

BASIL AMMARI P.E.
202 AMBLING DR.
BREA, CA 92821
TEL: 714-332-0087

PROPOSED ADDITION FOR:
YURI SALMERON
5866 PANAMA DR.
BUENA PARK, CA 90620

EXISTING FLOOR & ROOF PLAN




BASIL AMMARI

DRAWN BY DR
CONSULTANT / DESIGNER SIGNATURE
DATE 5/18/2025
SCALE 1/4" = 1'-0"
JOB NO.
SHEET A3

NEW WINDOW & DOOR SCHEDULE GENERAL NOTES

- (A) 2'-8" x 6'-8" WOOD DOOR.
- (B) 2'-0" x 3'-0" VINYL SLIDING WINDOW TEMPERED. ▲
- (C) 4'-6" x 2'-0" VINYL SLIDING WINDOW.
- (D) 5'-0" x 6'-8" VINYL SLIDING DOOR TEMPERED. ▲
- (E) 3'-0" x 3'-0" VINYL SLIDING WINDOW.

1. ALL EQUIPMENT, APPLIANCES AND FIXTURES
SELECTED BY OWNER / BUILDER AND INSTALLED
PER MANUFACTURERS RECOMMENDATIONS.
2. CABINET DRAWINGS SHALL BE PROVIDED BY
KITCHEN DESIGNER.
3. TEMPERED GLASS TYPICAL. = ▲

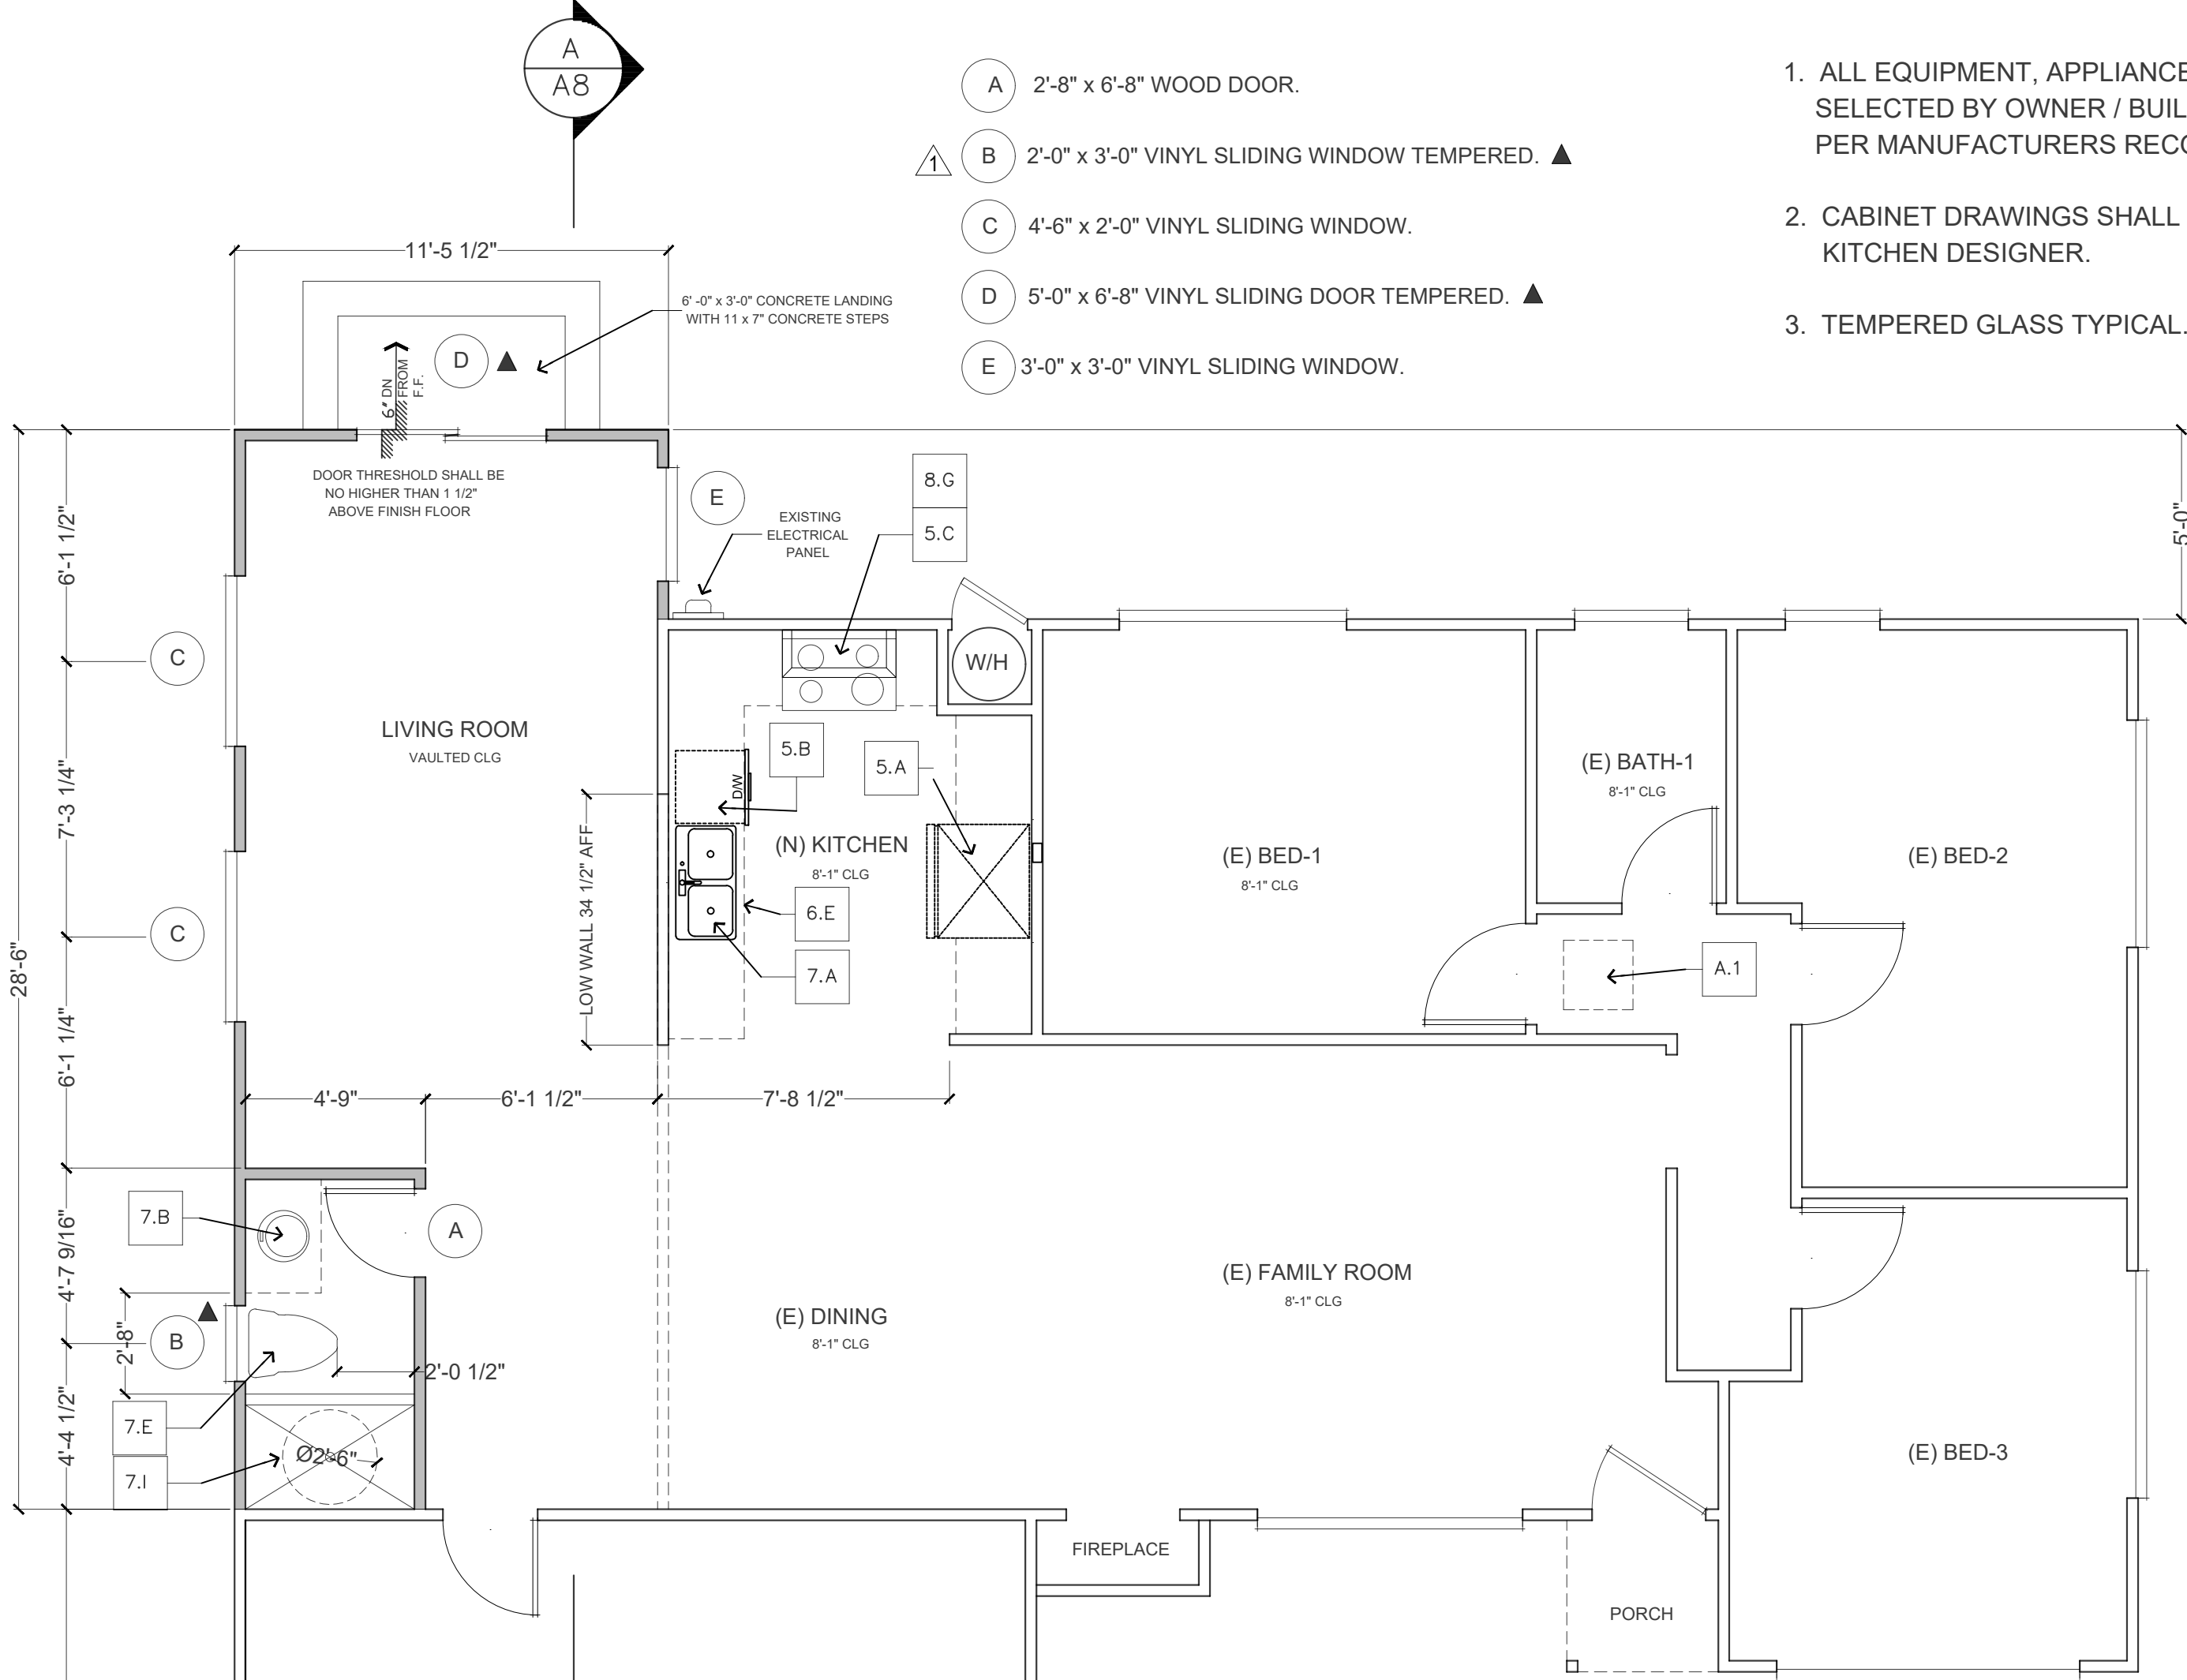

FLOOR PLAN NOTES


XX SYMBOL

- 1.A. ATTIC ACCESS 22" x 30" MIN.
- 5.A. REFRIGERATOR SPACE WITH RECESSED
COLD WATER BIBB FOR ICE MAKER.
- 5.B. DISHWASHER
- 5.C. SLIDE IN GAS RANGE
- 6.E. LOWER CABINETS
- 7.A. SINK WITH GARBAGE DISPOSAL
- 7.B. LAVATORY
- 7.E. WATER CLOSET WITH 30" MIN.
CLEAR WIDTH AND 24" CLEAR
SPACE IN FRONT.
- 7.I. FIBERGLASS - ONE PIECE SHOWER ENCLOSURE.
PROVIDE SHATTER RESISTANT GLASS ENCLOSURE
SHOWER HEAD AT 78" A.F.F.
- 8.G. 36" RANGE HOOD ABOVE WITH A MIN. EXHAUST RATE
OF 280 CFM.

WALL LEGEND

- NEW 2 x 4 @ 16" OC WALLS
- EXISTING WALLS OR PORTION OF EXISTING WALLS TO REMAIN
- EXISTING WALLS OR PORTION OF EXISTING WALLS TO BE REMOVED

PROPOSED FLOOR PLAN 1/4"=1'-0"

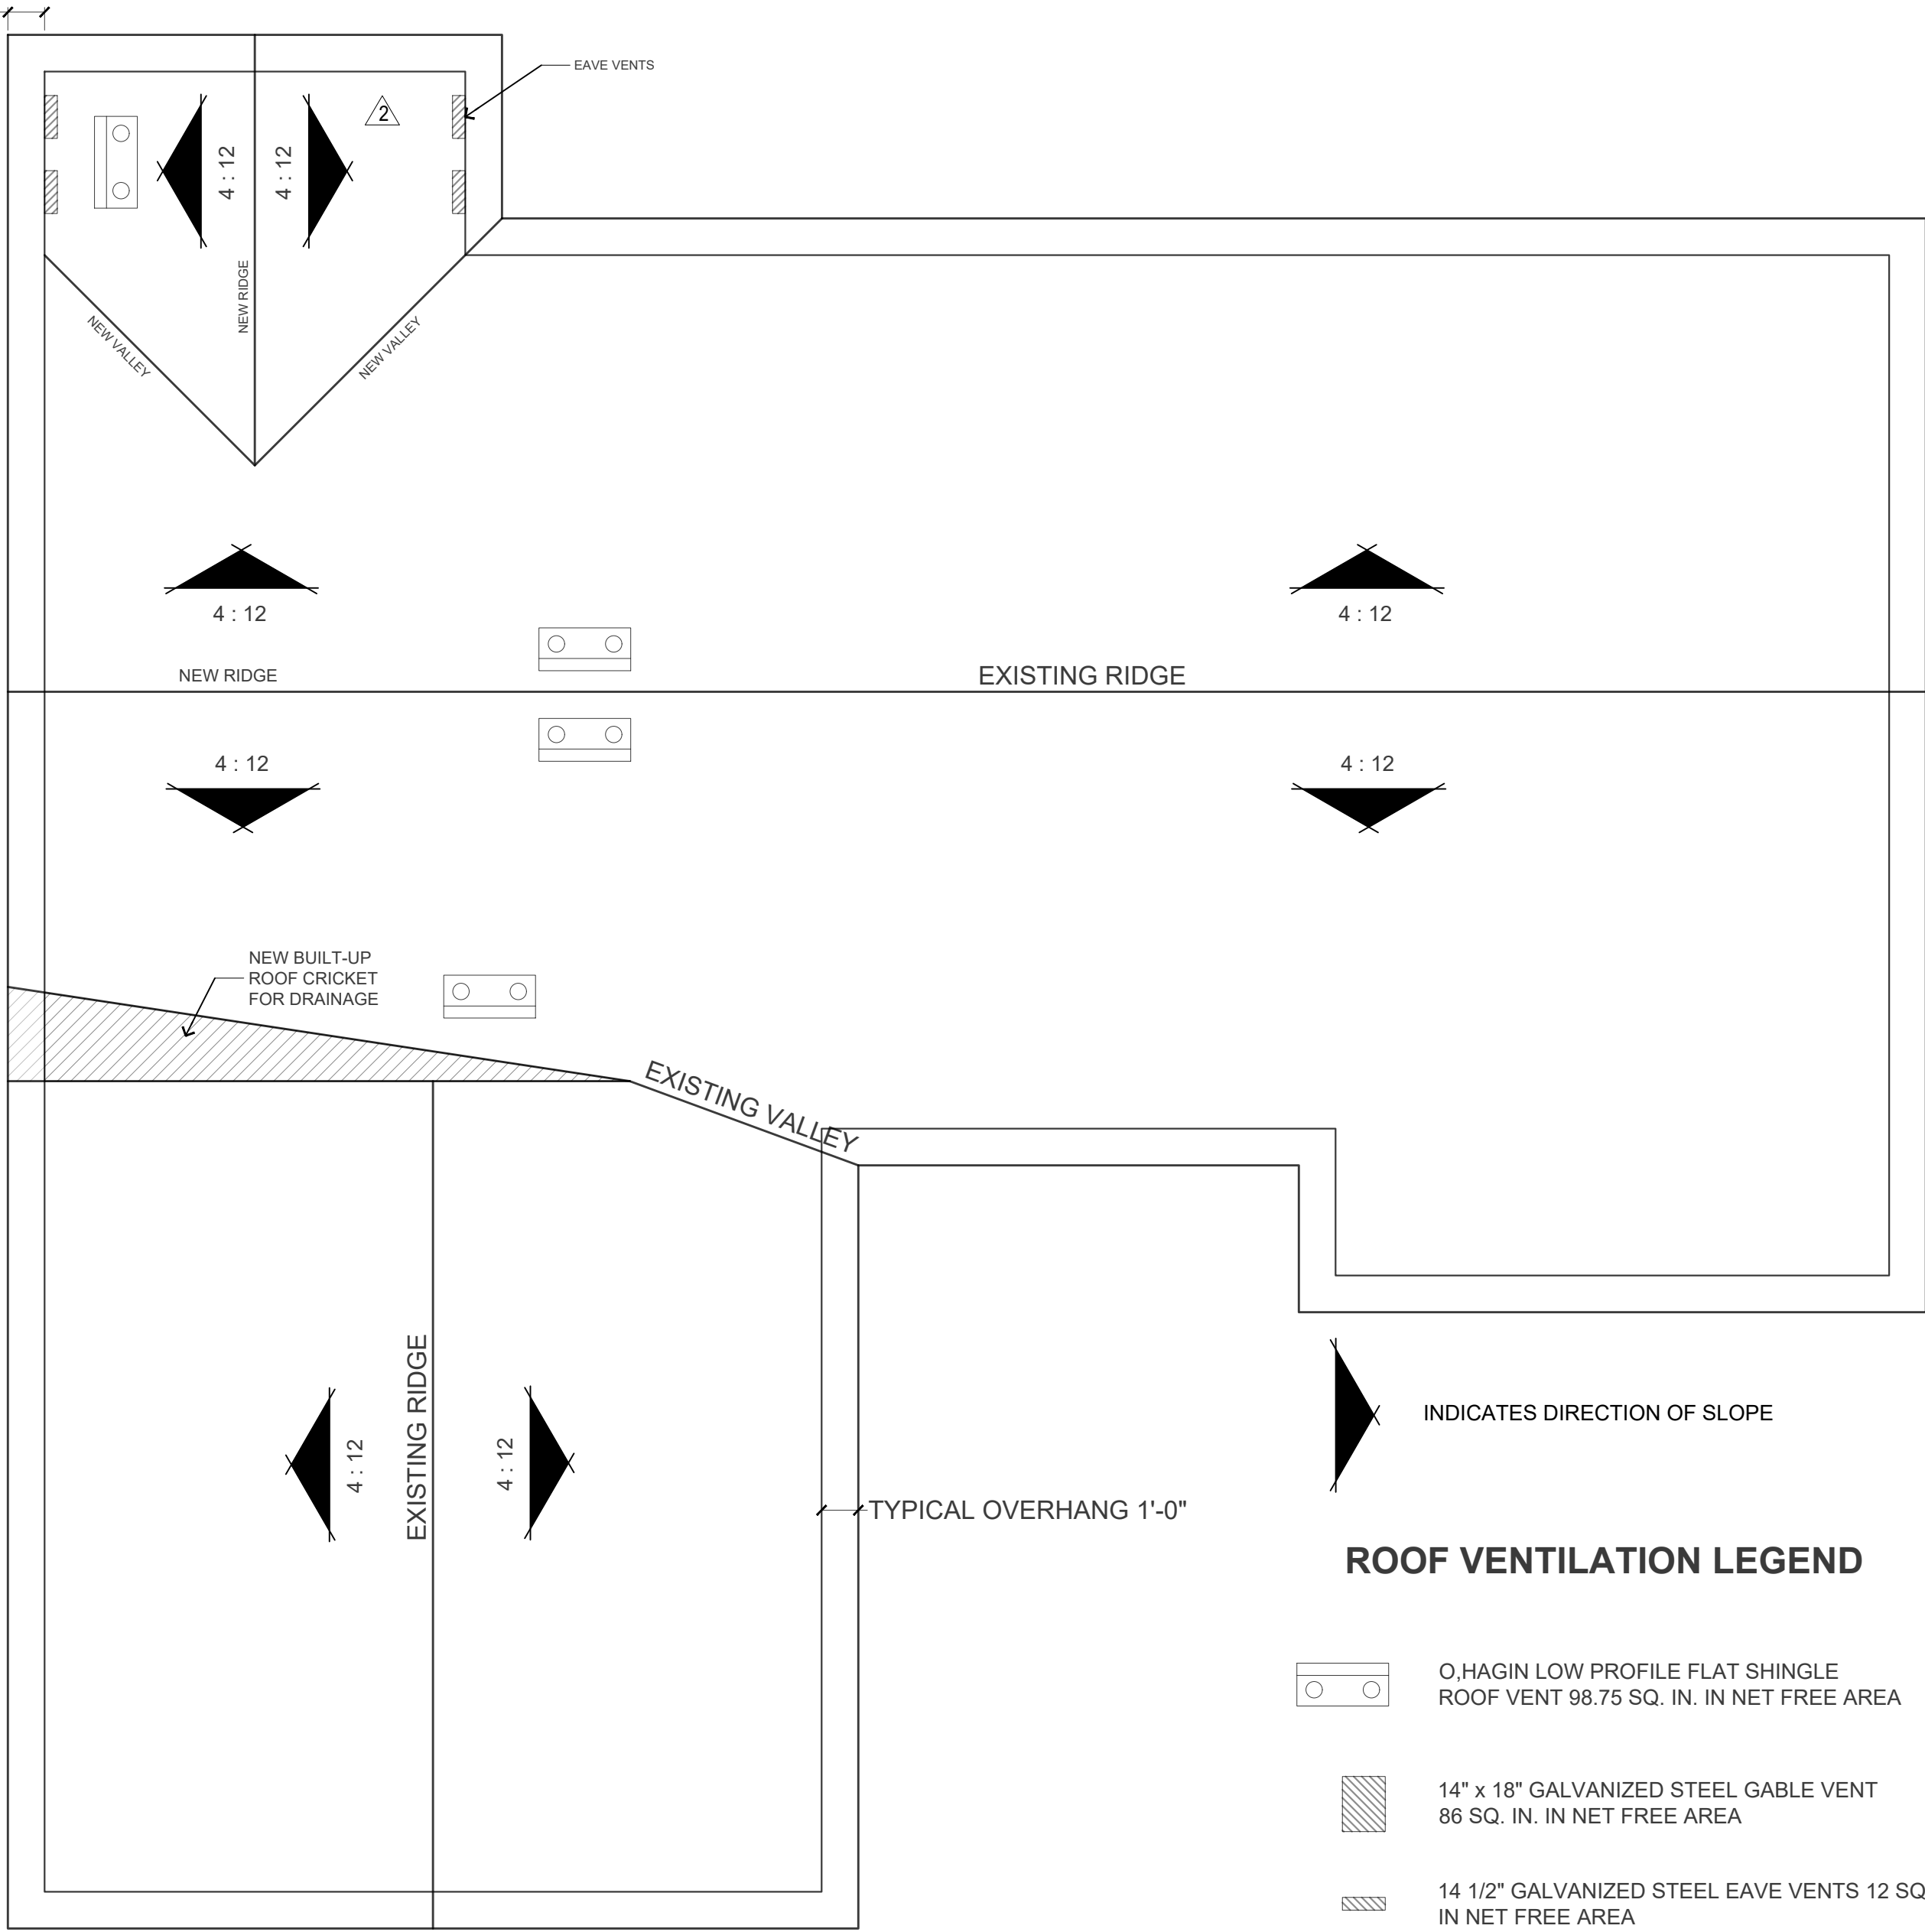

ROOF VENTILATION LEGEND

- O.HAGIN LOW PROFILE FLAT SHINGLE
ROOF VENT 98.75 SQ. IN. IN NET FREE AREA
- 14" x 18" GALVANIZED STEEL GABLE VENT
86 SQ. IN. IN NET FREE AREA
- 14 1/2" GALVANIZED STEEL EAVE VENTS 12 SQ. IN.
IN NET FREE AREA

VENTILATION CALCULATION

*TOTAL ROOF AREA = 328 SQ. FT.
*REQUIRED VENTILATION = 956 / 150 = 2.19 SQ. FT.
315 SQ. IN.
*REQUIRED VENTILATION = 315 / 2 = 158 SQ. IN.
(HIGH & LOW)
*PROVIDE (2) O.HAGIN VENTS (HIGH)
*PROVIDE (2 *98.75) 197.5 SQ. IN. (HIGH)
*PROVIDE (2) O.HAGIN VENTS & (3) EAVE VENTS
*PROVIDE (2 *98.75) + (3 *12) = 233.5 SQ. IN. LOW
*USE GAF ASPHALT ROOF SHINGLES COLOR TO MATCH
EXISTING MAIN HOUSE ROOFING.

PROPOSED ROOF PLAN 1/4"=1'-0"

REVISIONS	DATE
1st PLAN CHECK	9/29/23
2nd PLAN CHECK	6/11/25

BASIL AMMARI P.E.
202 AMBLING DR.
BREA, CA 92821
TEL: 714-332-0087


PROPOSED ADDITION FOR:
YURI SALMERON
5866 PANAMA DR.
BUENA PARK, CA 90620

PROPOSED FLOOR
& ROOF PLAN



BASIL AMMARI

DRAWN BY DR
CONSULTANT / DESIGNER SIGNATURE
DATE 6/11/2025
SCALE 1/4" = 1'-0"
JOB NO.
SHEET A4

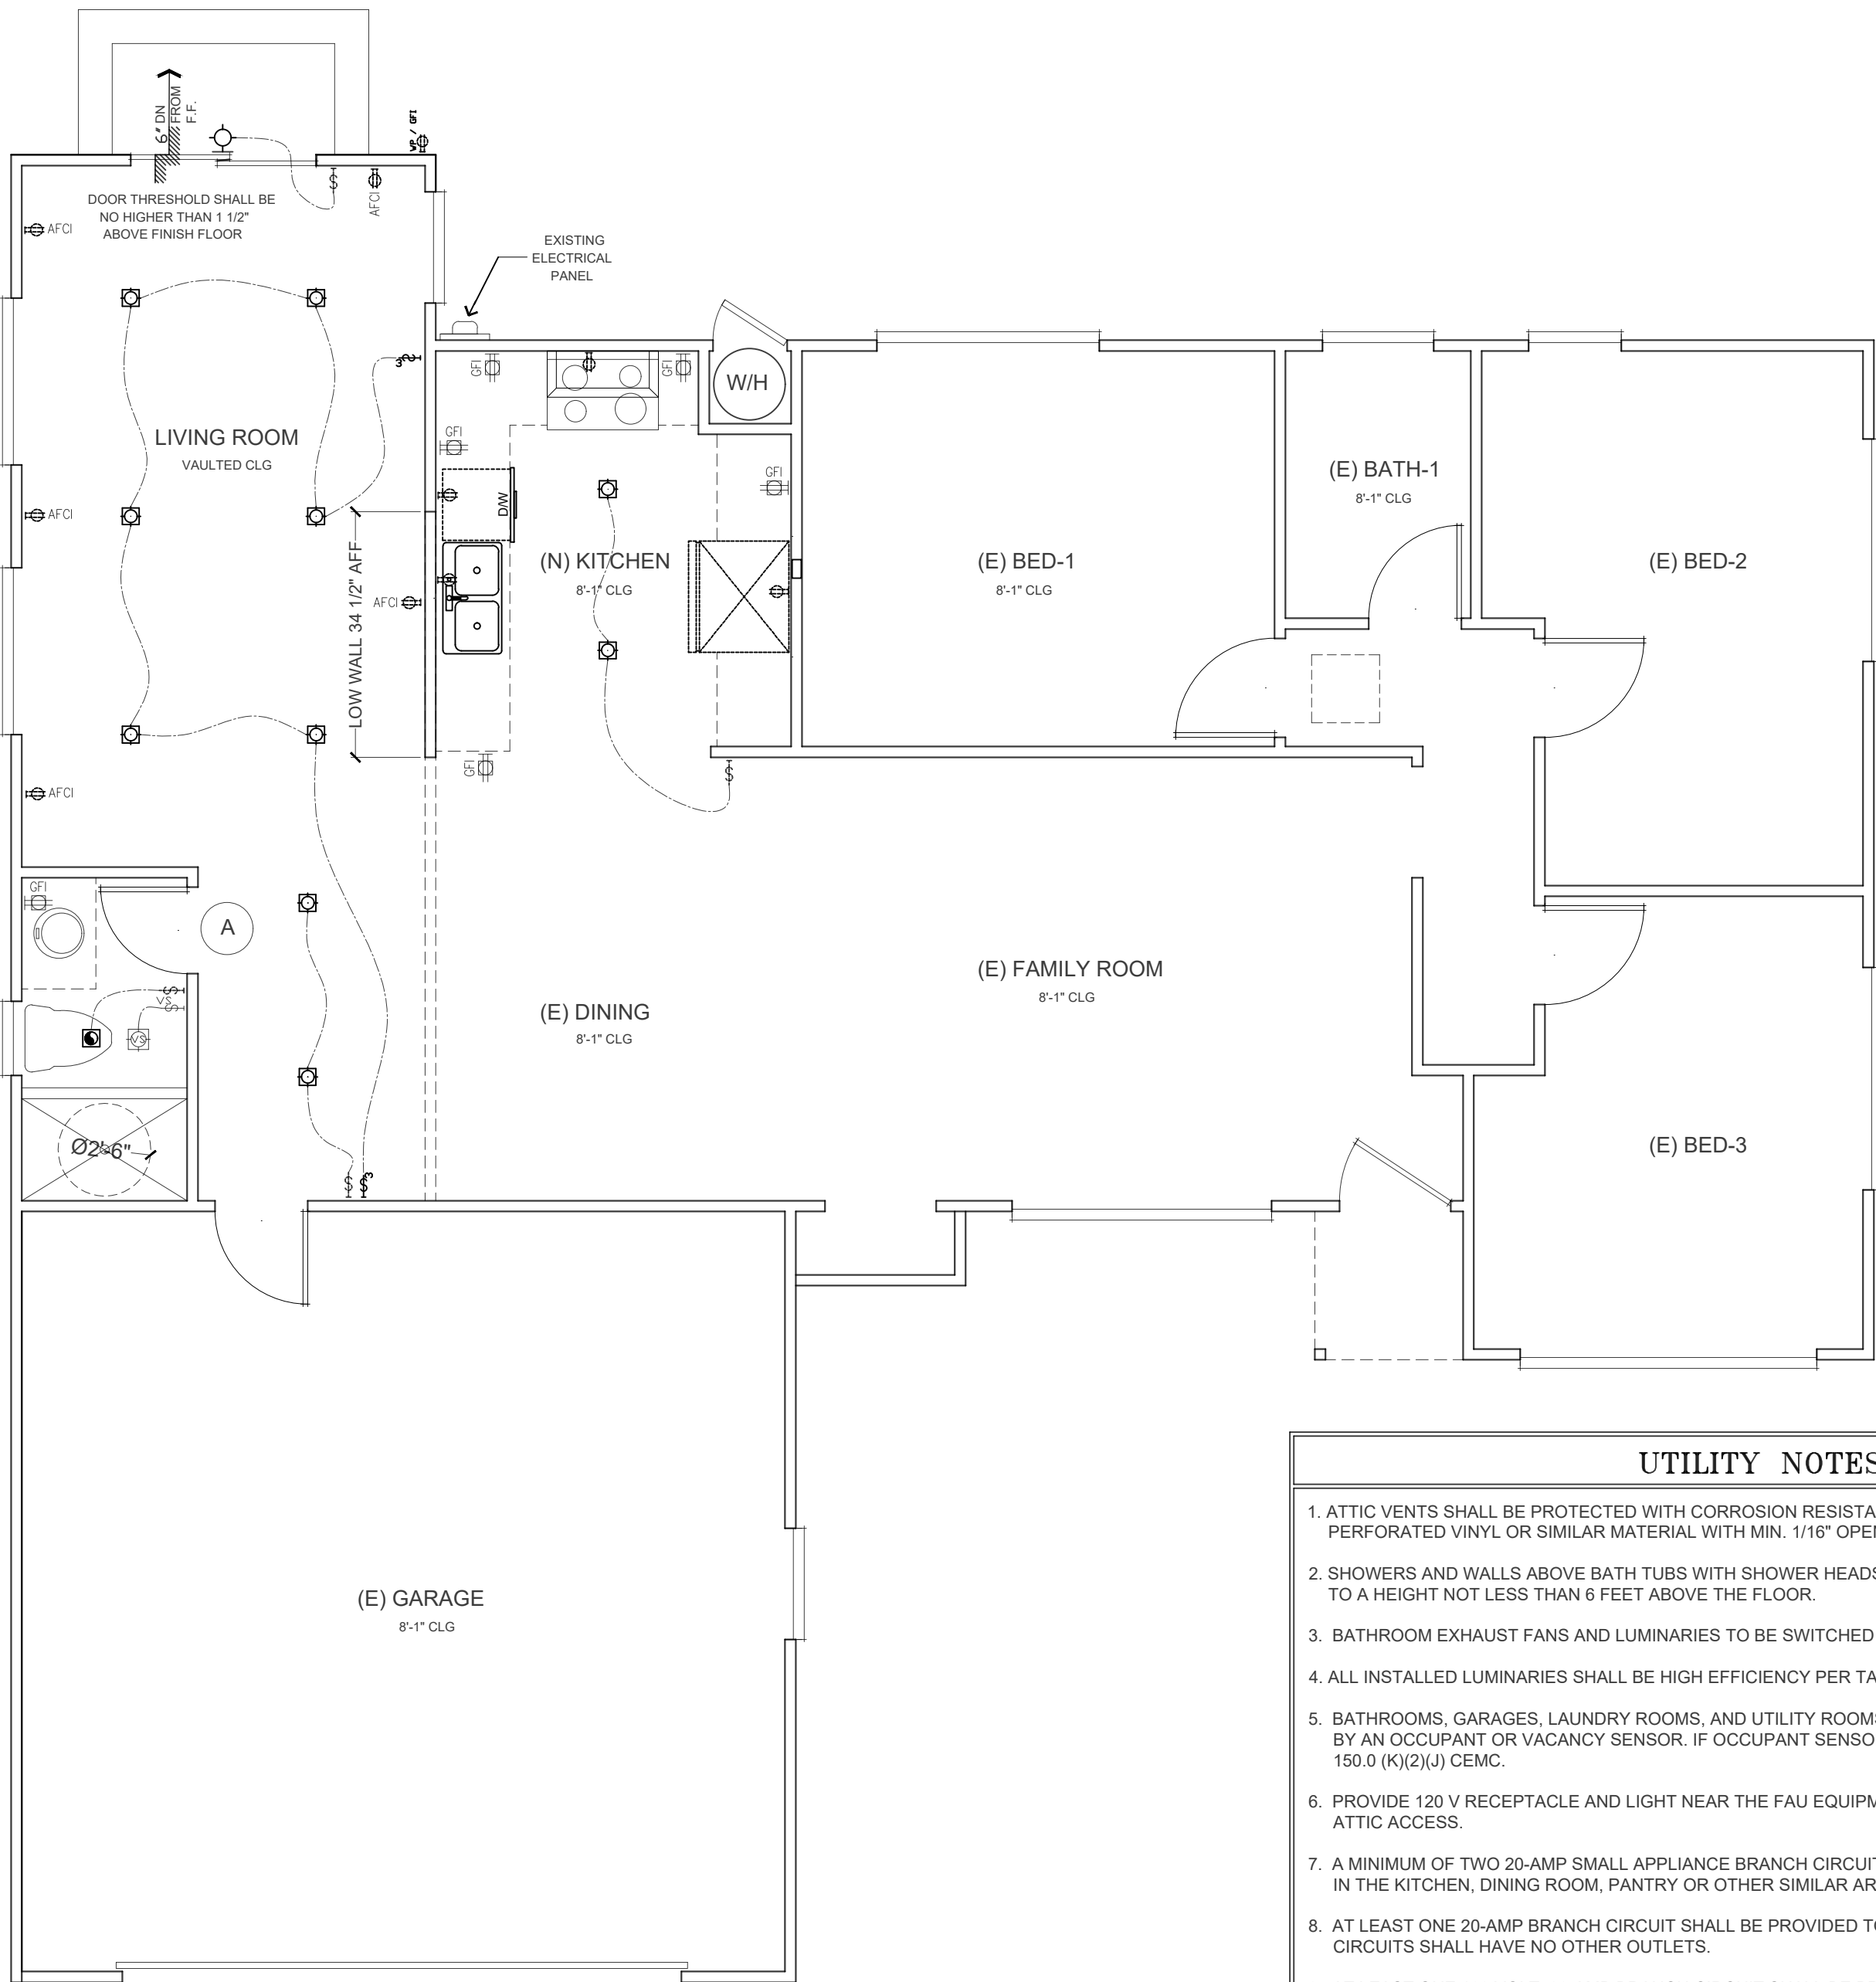

UTILITY SYMBOLS	
	120 V OUTLET AFCI
	120 V OUTLET GFCI
	LIGHT SWITCH
	2-WAY SWITCH
	3-WAY SWITCH
	4-WAY SWITCH
	CEILING MOUNT LIGHT FIXTURE
	PENDANT LIGHT FIXTURE
	CAN CEILING LIGHT
	SMOKE DETECTOR HARDWIRED WITH BATTERY BACK-UP
	SMOKE DETECTOR HARDWIRED WITH BATTERY BACK-UP
	LED LIGHT FIXTURES WITH J-BOX
	EXHAUST FAN MIN 50 CFM

UTILITY NOTES
1. ATTIC VENTS SHALL BE PROTECTED WITH CORROSION RESISTANT WIRE CLOTH SCREENING, HARDWARE CLOTH, PERFORATED VINYL OR SIMILAR MATERIAL WITH MIN. 1/16" OPENING AND 1/4" MAX. OPENING.
2. SHOWERS AND WALLS ABOVE BATH TUBS WITH SHOWER HEADS. SHALL BE FINISHED WITH NON ABSORBENT SURFACE TO A HEIGHT NOT LESS THAN 6 FEET ABOVE THE FLOOR.
3. BATHROOM EXHAUST FANS AND LUMINARIES TO BE SWITCHED SEPARATELY PER 150.0(K)(2)(B) CEN.C.
4. ALL INSTALLED LUMINARIES SHALL BE HIGH EFFICIENCY PER TABLE 150.0 A, 150 (K)(1)(A) CEN.C.
5. BATHROOMS, GARAGES, LAUNDRY ROOMS, AND UTILITY ROOMS. SHALL HAVE AT LEAST ONE LUMINARY CONTROLLED BY AN OCCUPANT OR VACANCY SENSOR. IF OCCUPANT SENSOR IS INSTALLED, IT SHALL BE SET TO MANUAL-ON, 150.0 (K)(2)(J) CEN.C.
6. PROVIDE 120 V RECEPTACLE AND LIGHT NEAR THE FAU EQUIPMENT AT THE ATTIC. LOCATE THE LIGHT SWITCH AT THE ATTIC ACCESS.
7. A MINIMUM OF TWO 20-AMP SMALL APPLIANCE BRANCH CIRCUITS SHALL BE PROVIDED FOR ALL RECEPTACLE OUTLETS IN THE KITCHEN, DINING ROOM, PANTRY OR OTHER SIMILAR AREAS.
8. AT LEAST ONE 20-AMP BRANCH CIRCUIT SHALL BE PROVIDED TO SUPPLY LAUNDRY RECEPTACLE OUTLETS, SUCH CIRCUITS SHALL HAVE NO OTHER OUTLETS.
9. AT LEAST ONE 120 VOLT, 20-AMP BRANCH CIRCUIT SHALL BE PROVIDED TO SUPPLY BATHROOM RECEPTACLE OUTLETS SUCH CIRCUITS SHALL HAVE NO OTHER OUTLETS.
10. INSTALL SMOKE DETECTORS AT ALL SLEEPING ROOMS AND CENTRALLY LOCATED AT ALL HALLWAYS.
11. INSTALL CARBON MONOXIDE DETECTORS CENTRALLY LOCATED AT ALL HALLWAYS.

REVISIONS	DATE
1st PLAN CHECK	9/29/23


BASIL AMMARI P.E.
202 AMBLING DR.
BREA, CA 92821
TEL: 714-332-0087

PROPOSED ADDITION FOR:
YURI SALMERON
5866 PANAMA DR.
BUENA PARK, CA 90620


PROPOSED UTILITY
PLAN



DRAWN BY DR
CONSULTANT / DESIGNER SIGNATURE
DATE 5/18/2025
SCALE 1/4" = 1'-0"
JOB NO.
SHEET A5

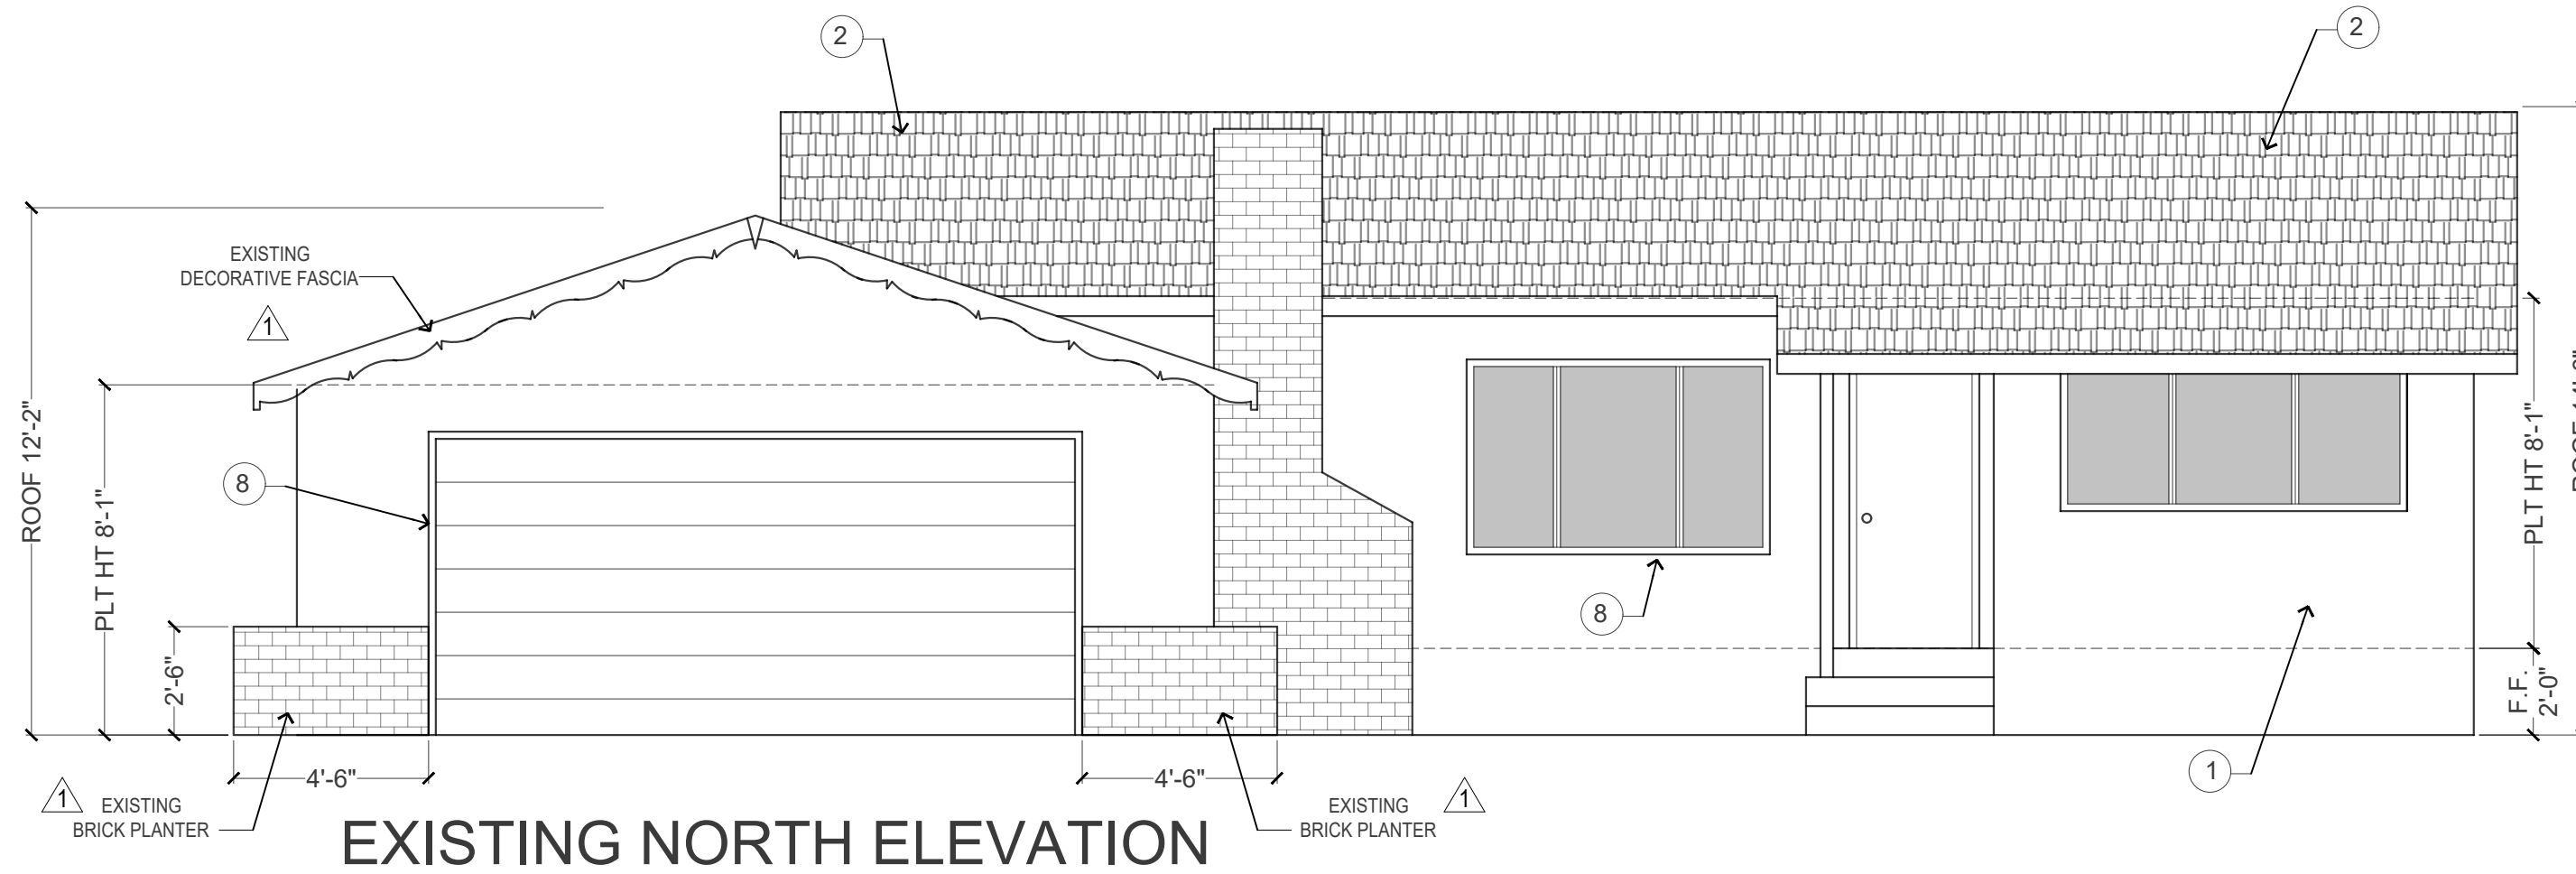


EXISTING NORTH ELEVATION

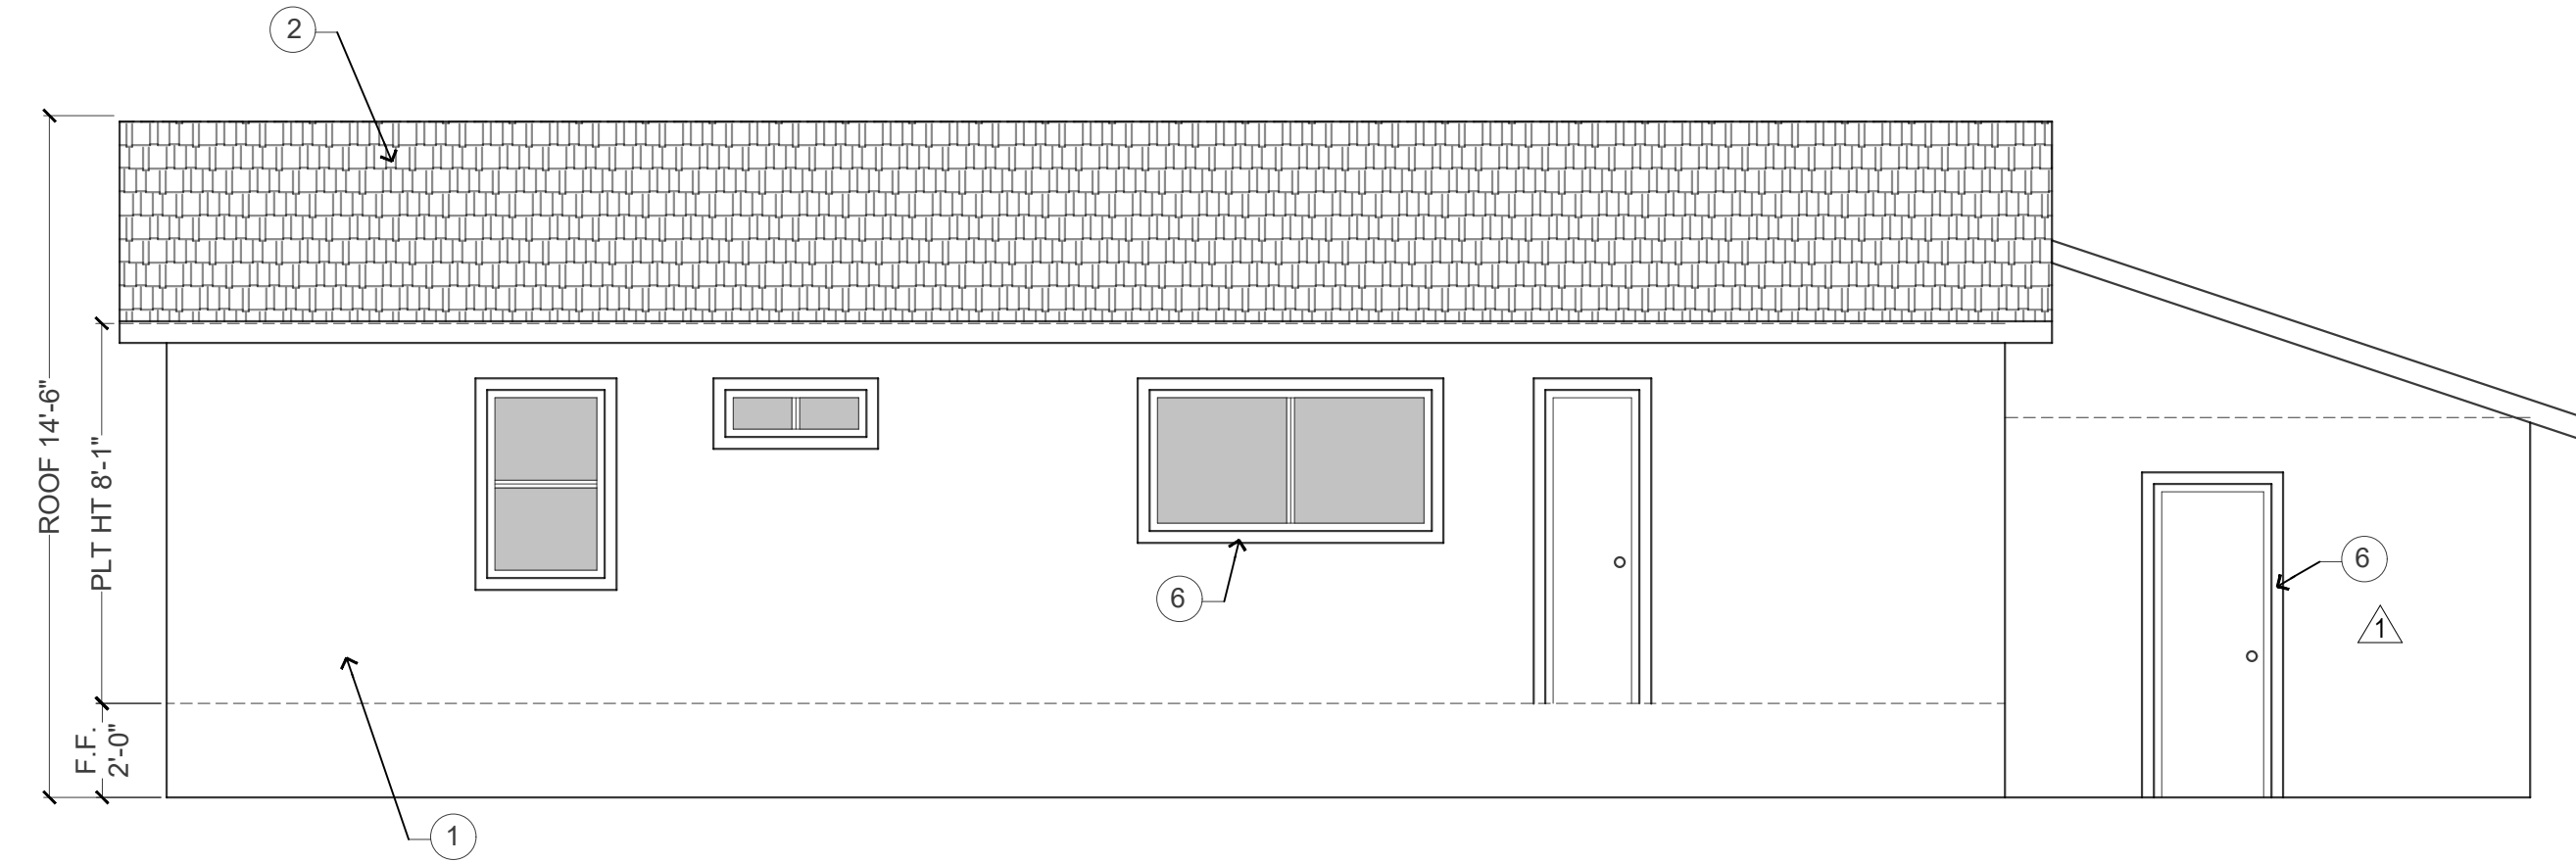


EXISTING SOUTH ELEVATION

ELEVATION NOTES

- EXISTING STUCCO FINISH.
- EXISTING ASPHALT ROOF SHINGLES.
- NEW ASPHALT ROOF SHINGLES TO MATCH EXISTING ROOF SHINGLES IN COLOR & STYLE.
- NEW STUCCO FINISH TO MATCH EXISTING MAIN HOUSE STUCCO FINISH IN COLOR & STYLE.
- NEW CONCRETE LANDING AND STEPS PER PLAN.
- EXISTING 3" STUCCO FOAM WINDOW/ DOOR TRIM.
- NEW 3" STUCCO FOAM WINDOW/ DOOR TRIM TO MATCH EXISTING.
- NO TRIM AROUND WINDOWS/ DOORS AT EXISTING NORTH ELEVATION.
- AS AN ADDED BUILDING ENHANCEMENT, NEW 4" STUCCO FOAM AROUND WINDOWS & DOORS AT NORTH ELEVATION.

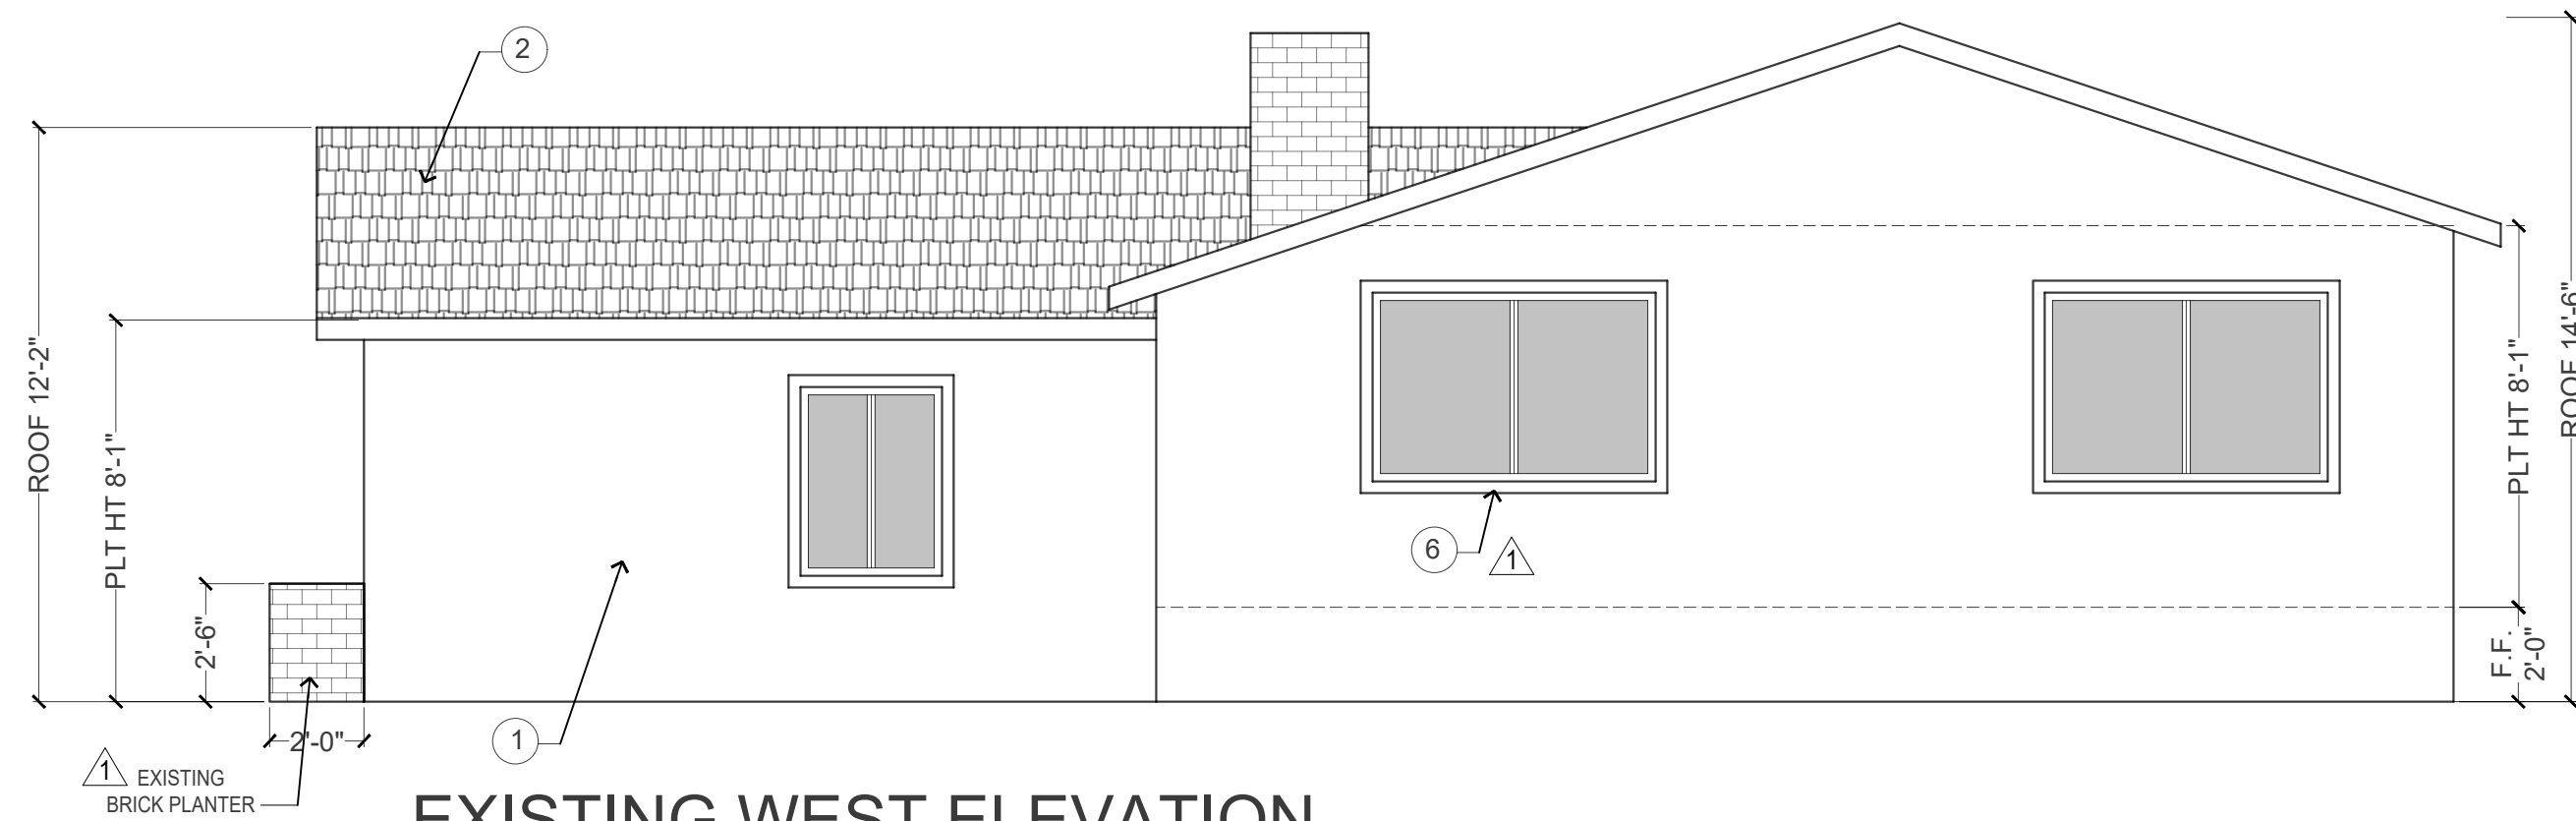

EXISTING WEST ELEVATION

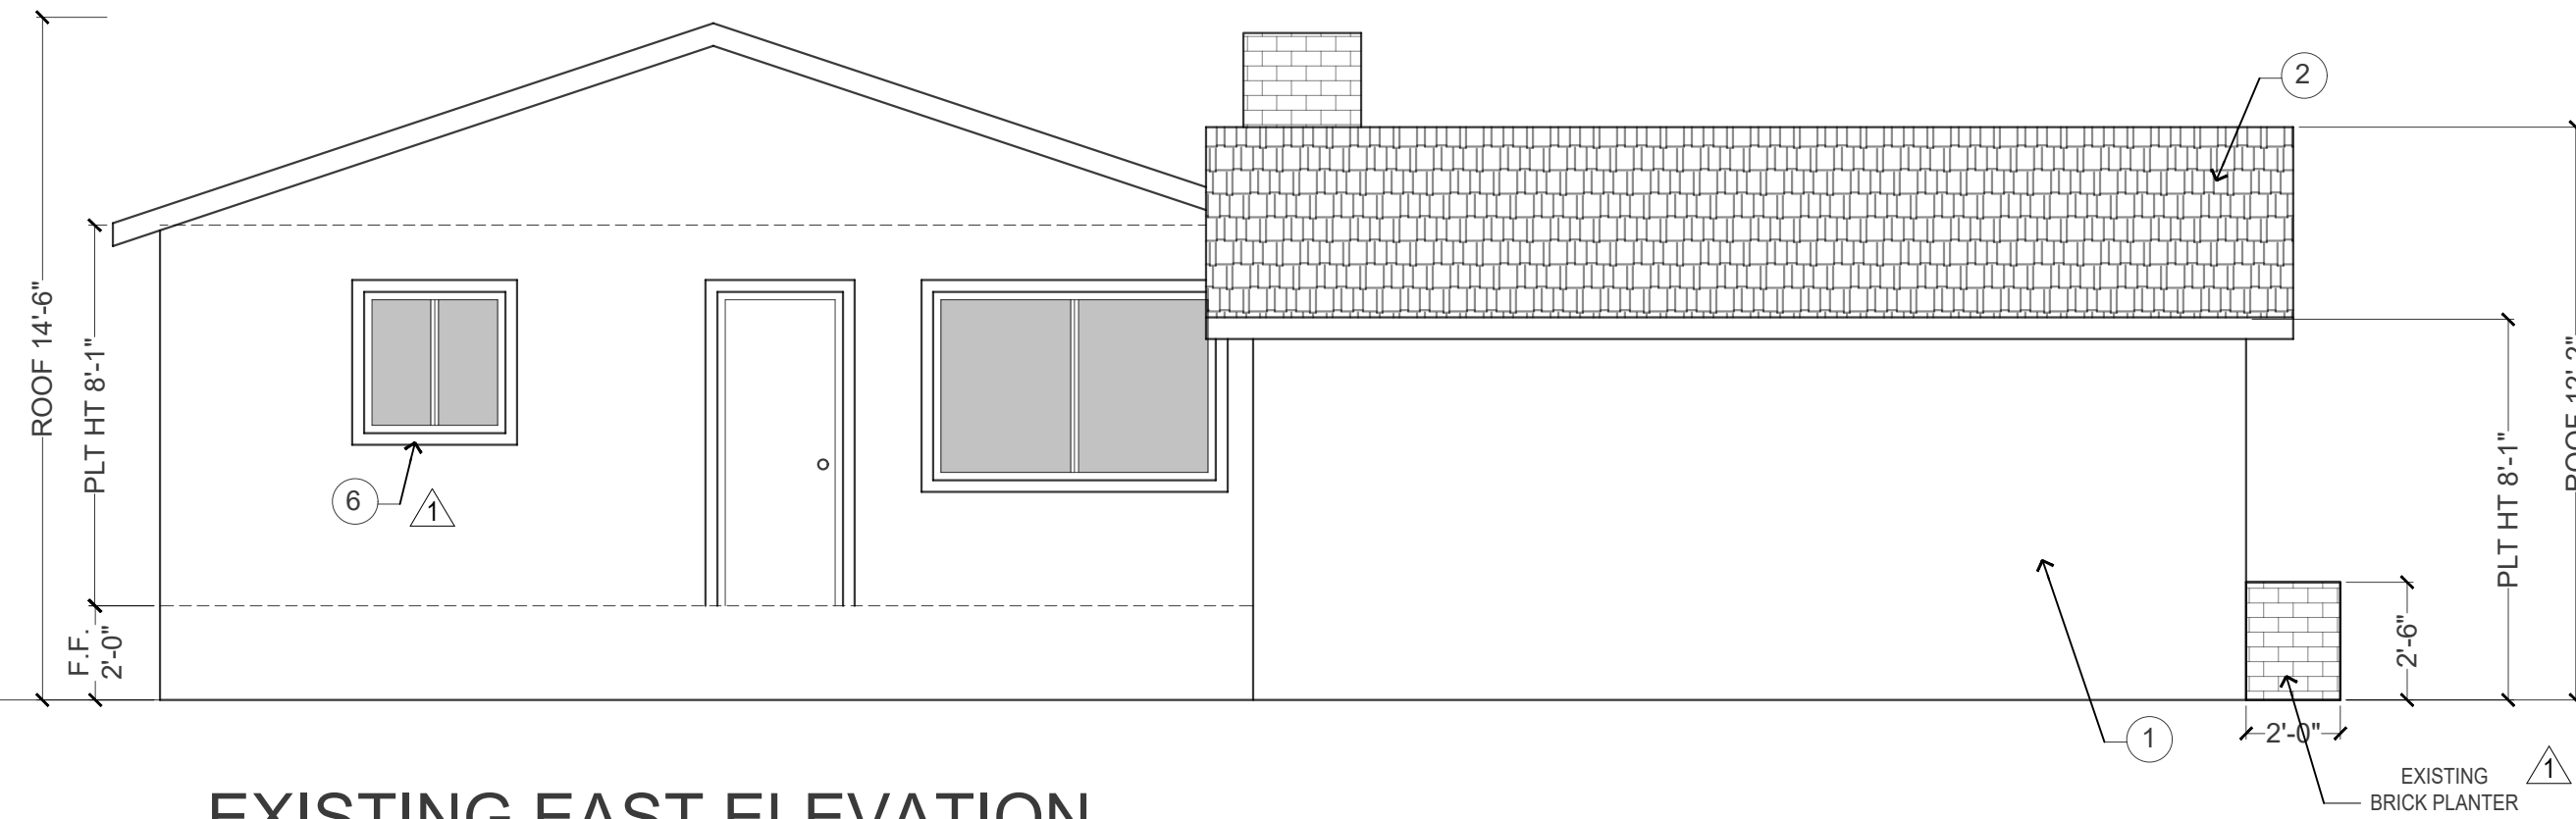

EXISTING EAST ELEVATION

REVISIONS

DATE

1st PLAN CHECK	9/29/23

BASIL AMMARI P.E.
202 AMBLING DR.
BREA, CA 92821
TEL: 714-332-0087

PROPOSED ADDITION FOR:
YURI SALMERON
5866 PANAMA DR.
BUENA PARK, CA 90620

EXISTING ELEVATIONS



BASIL AMMARI

DRAWN BY
DR

CONSULTANT / DESIGNER SIGNATURE





DATE
5/18/2025

SCALE
1/4" = 1'-0"

JOB NO.

SHEET

A6

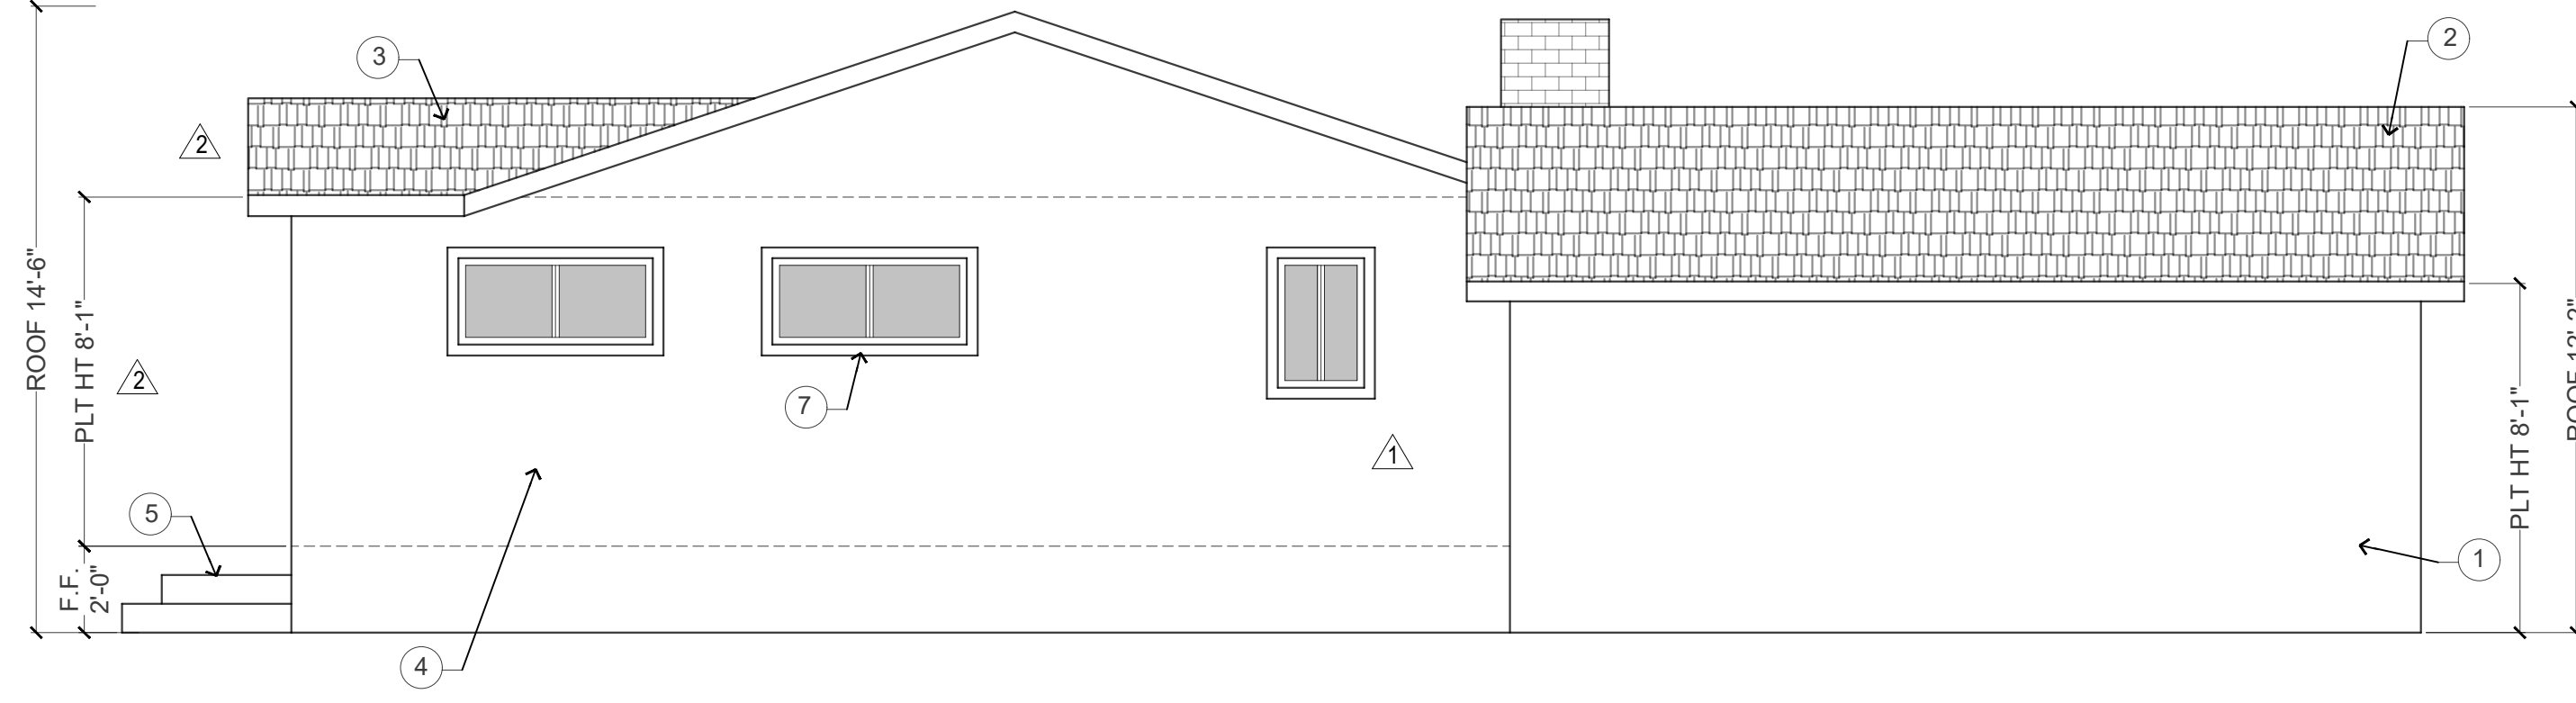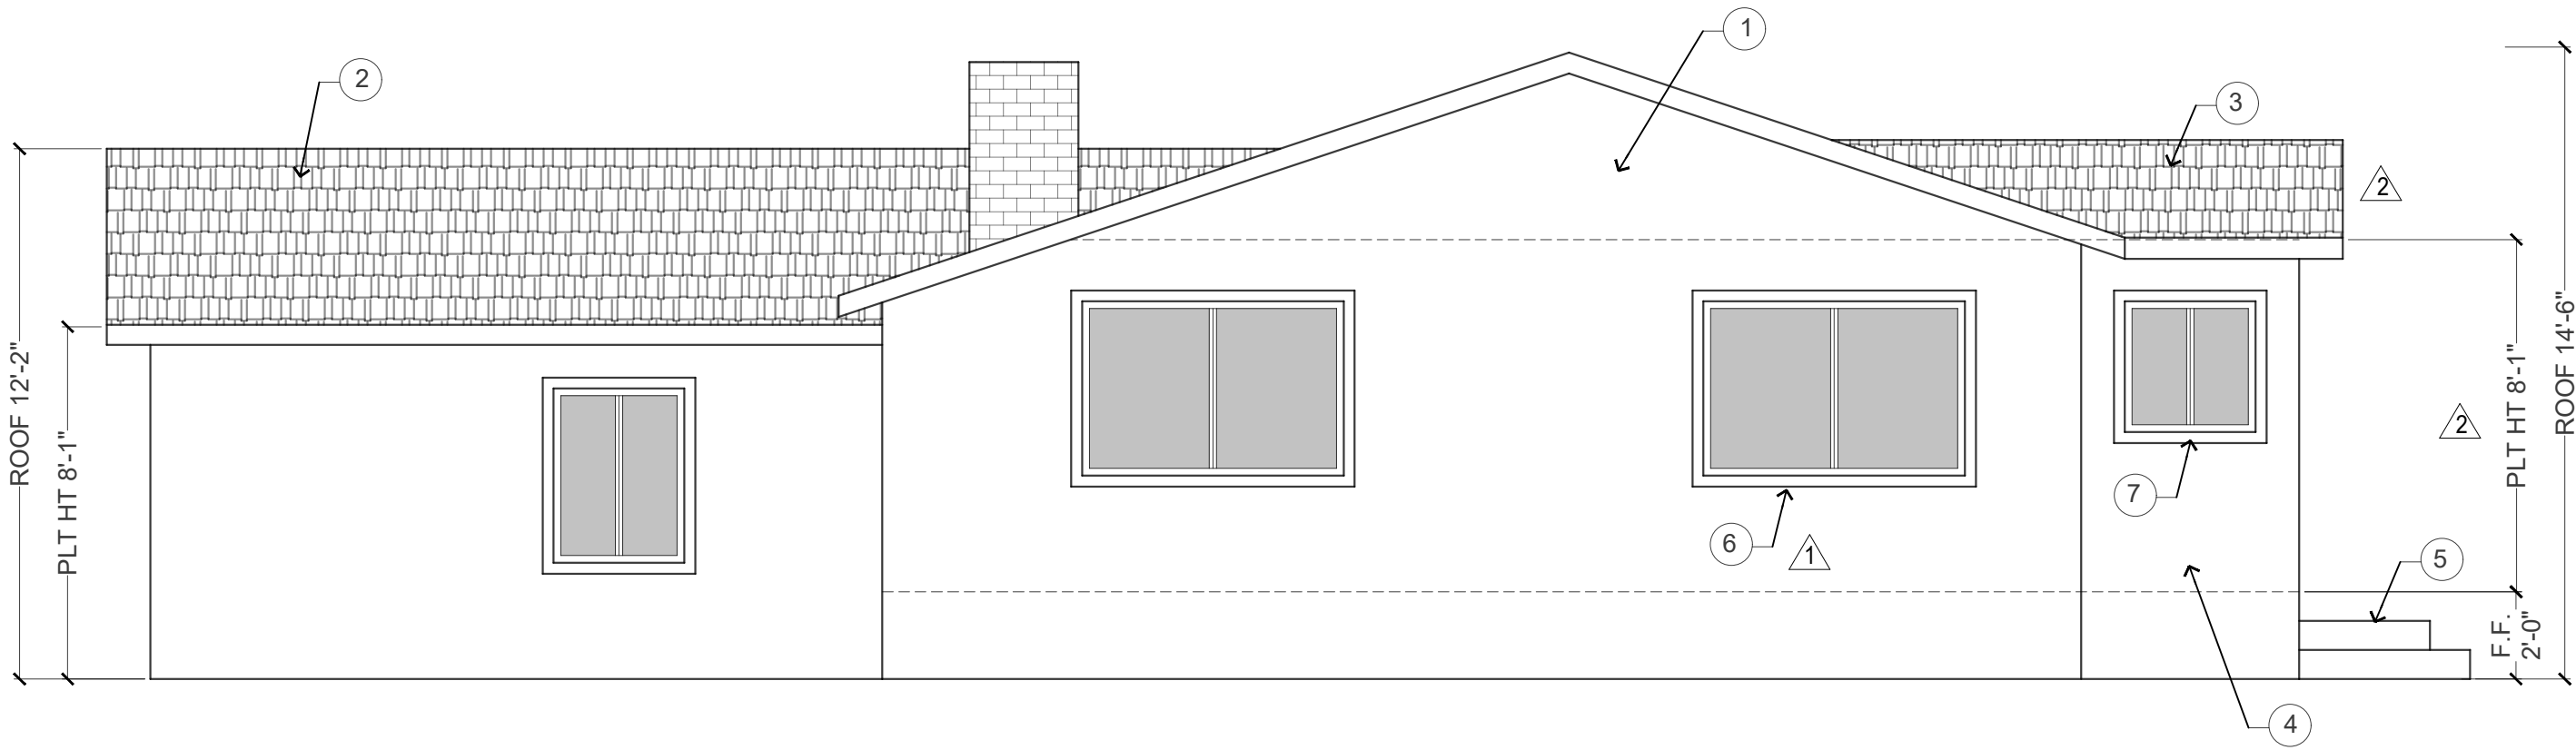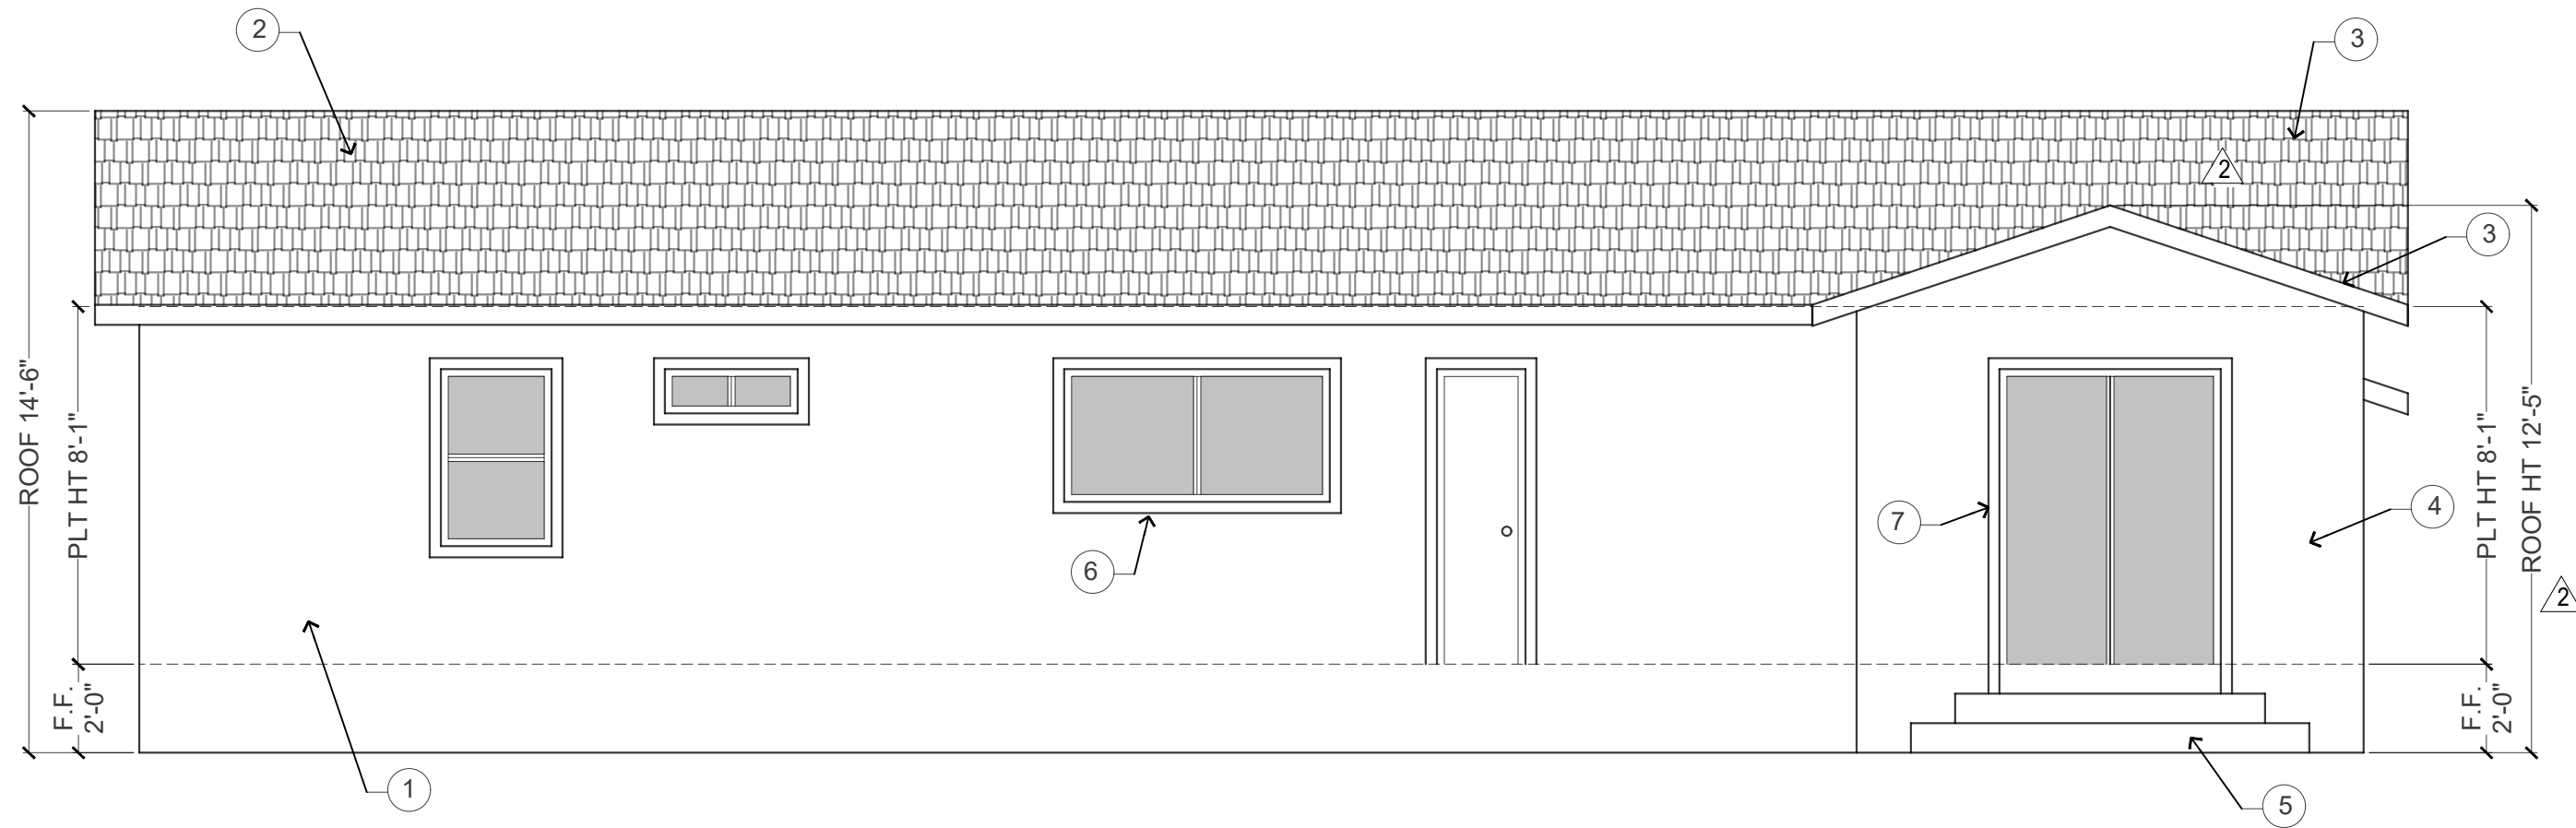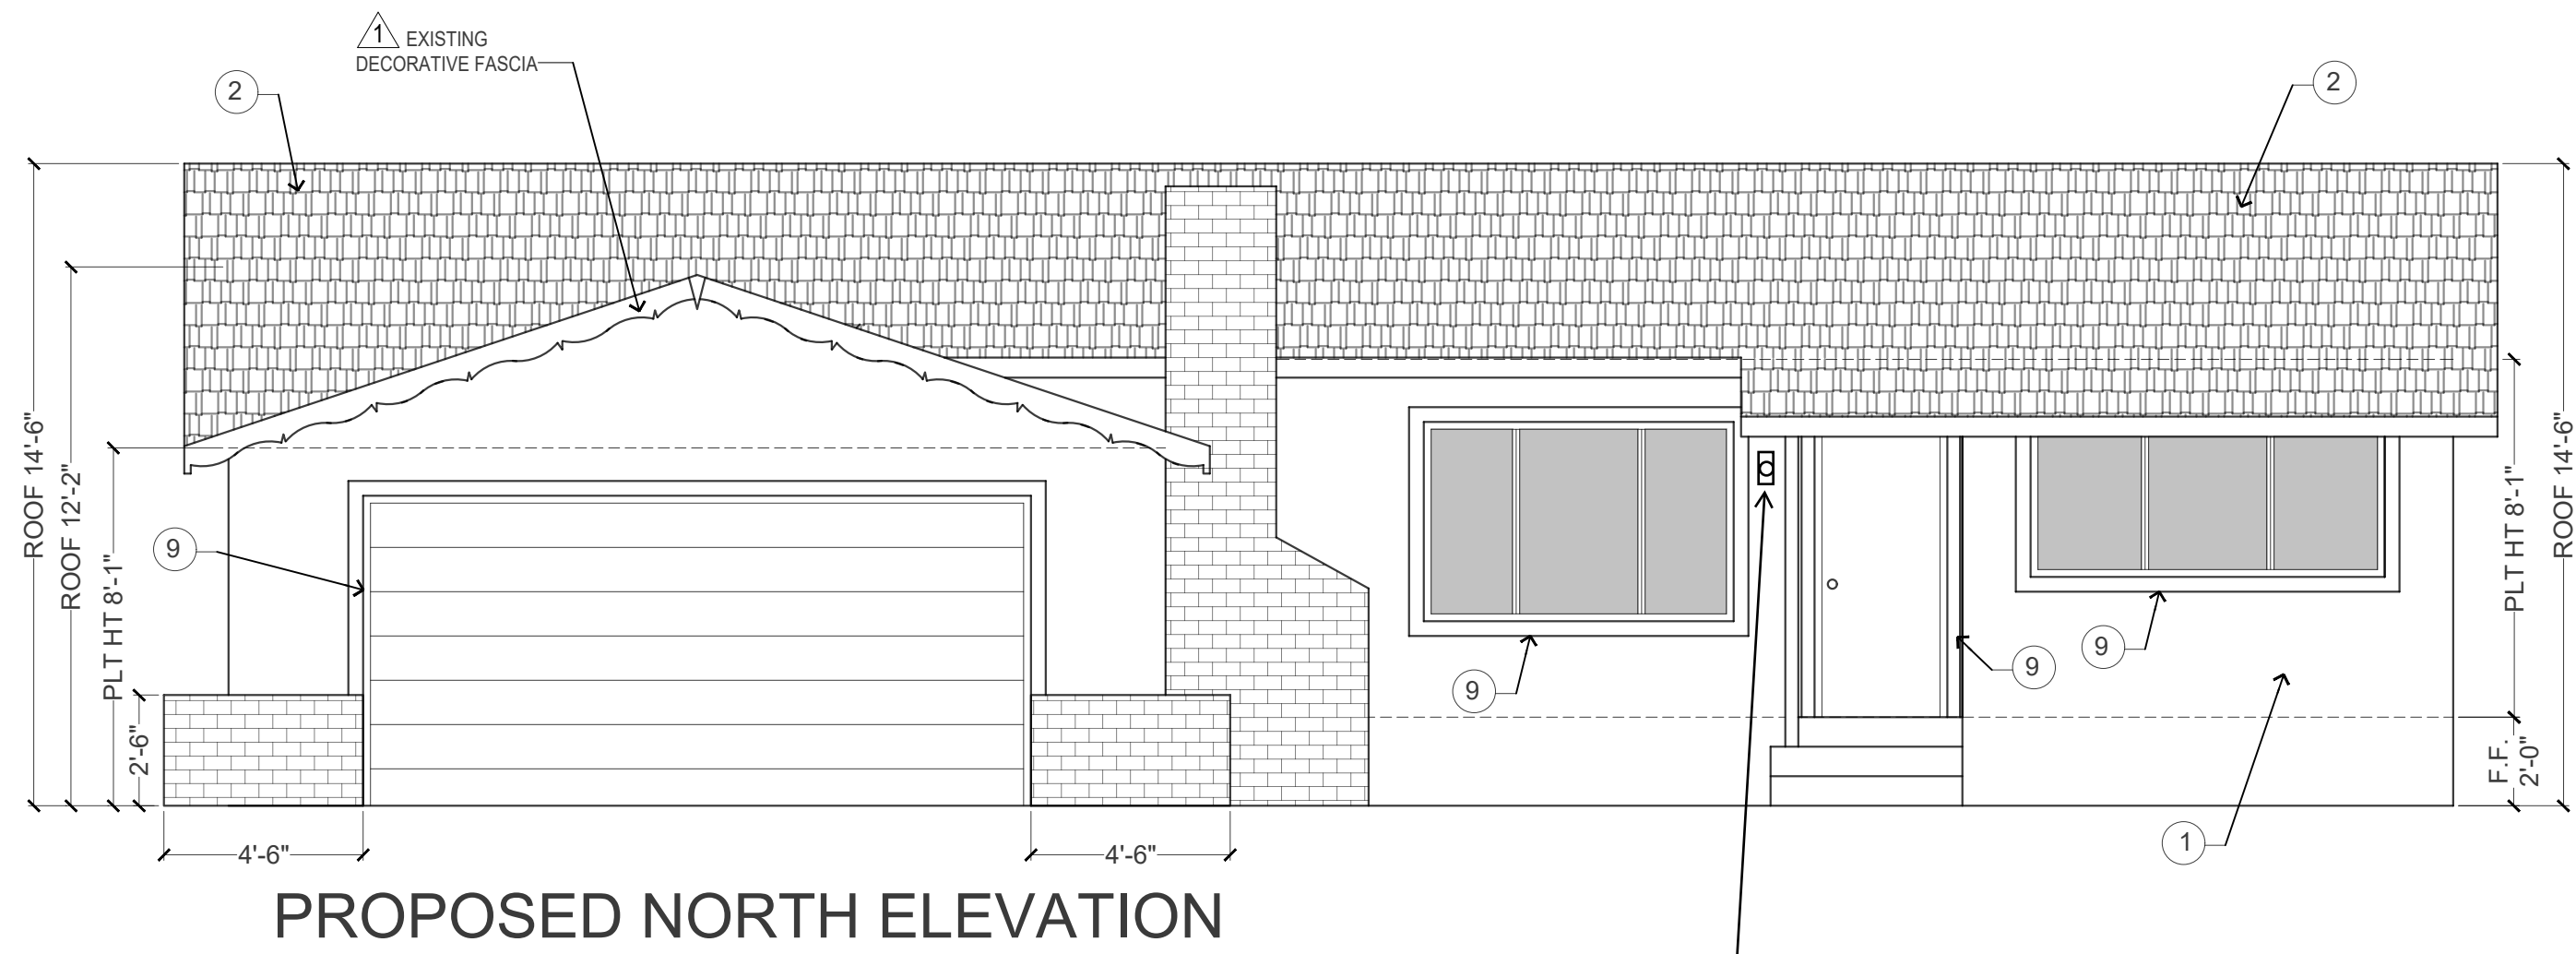

ELEVATION NOTES

- 1 EXISTING STUCCO FINISH.
- 2 EXISTING ASPHALT ROOF SHINGLES.
- 3 NEW ASPHALT ROOF SHINGLES TO MATCH EXISTING ROOF SHINGLES IN COLOR & STYLE.
- 4 NEW STUCCO FINISH TO MATCH EXISTING MAIN HOUSE STUCCO FINISH IN COLOR & STYLE.
- 5 NEW CONCRETE LANDING AND STEPS PER PLAN.
- 6 EXISTING 3" STUCCO FOAM WINDOW/ DOOR TRIM.
- 7 NEW 3" STUCCO FOAM WINDOW/ DOOR TRIM TO MATCH EXISTING.
- 8 NO TRIM AROUND WINDOWS/ DOORS AT EXISTING NORTH ELEVATION.
- 9 AS AN ADDED BUILDING ENHANCEMENT, NEW 4" STUCCO FOAM AROUND WINDOWS & DOORS AT NORTH ELEVATION.

NOTE: ⚠

ALL PROPOSED WINDOW & DOORS TO MATCH EXISTING WINDOWS & DOORS.

REVISIONS	DATE
⚠ 1st PLAN CHECK	9/29/23
⚠ 2nd PLAN CHECK	6/11/25

BASIL AMMARI P.E.
202 AMBLING DR.
BREA, CA 92821
TEL: 714-332-0087


PROPOSED ADDITION FOR:
YURI SALMERON
5866 PANAMA DR.
BUENA PARK, CA 90620

PROPOSED ELEVATIONS



BASIL AMMARI

DRAWN BY DR
CONSULTANT / DESIGNER SIGNATURE
DATE 6/11/2025
SCALE 1/4" = 1'-0"
JOB NO.
SHEET A7

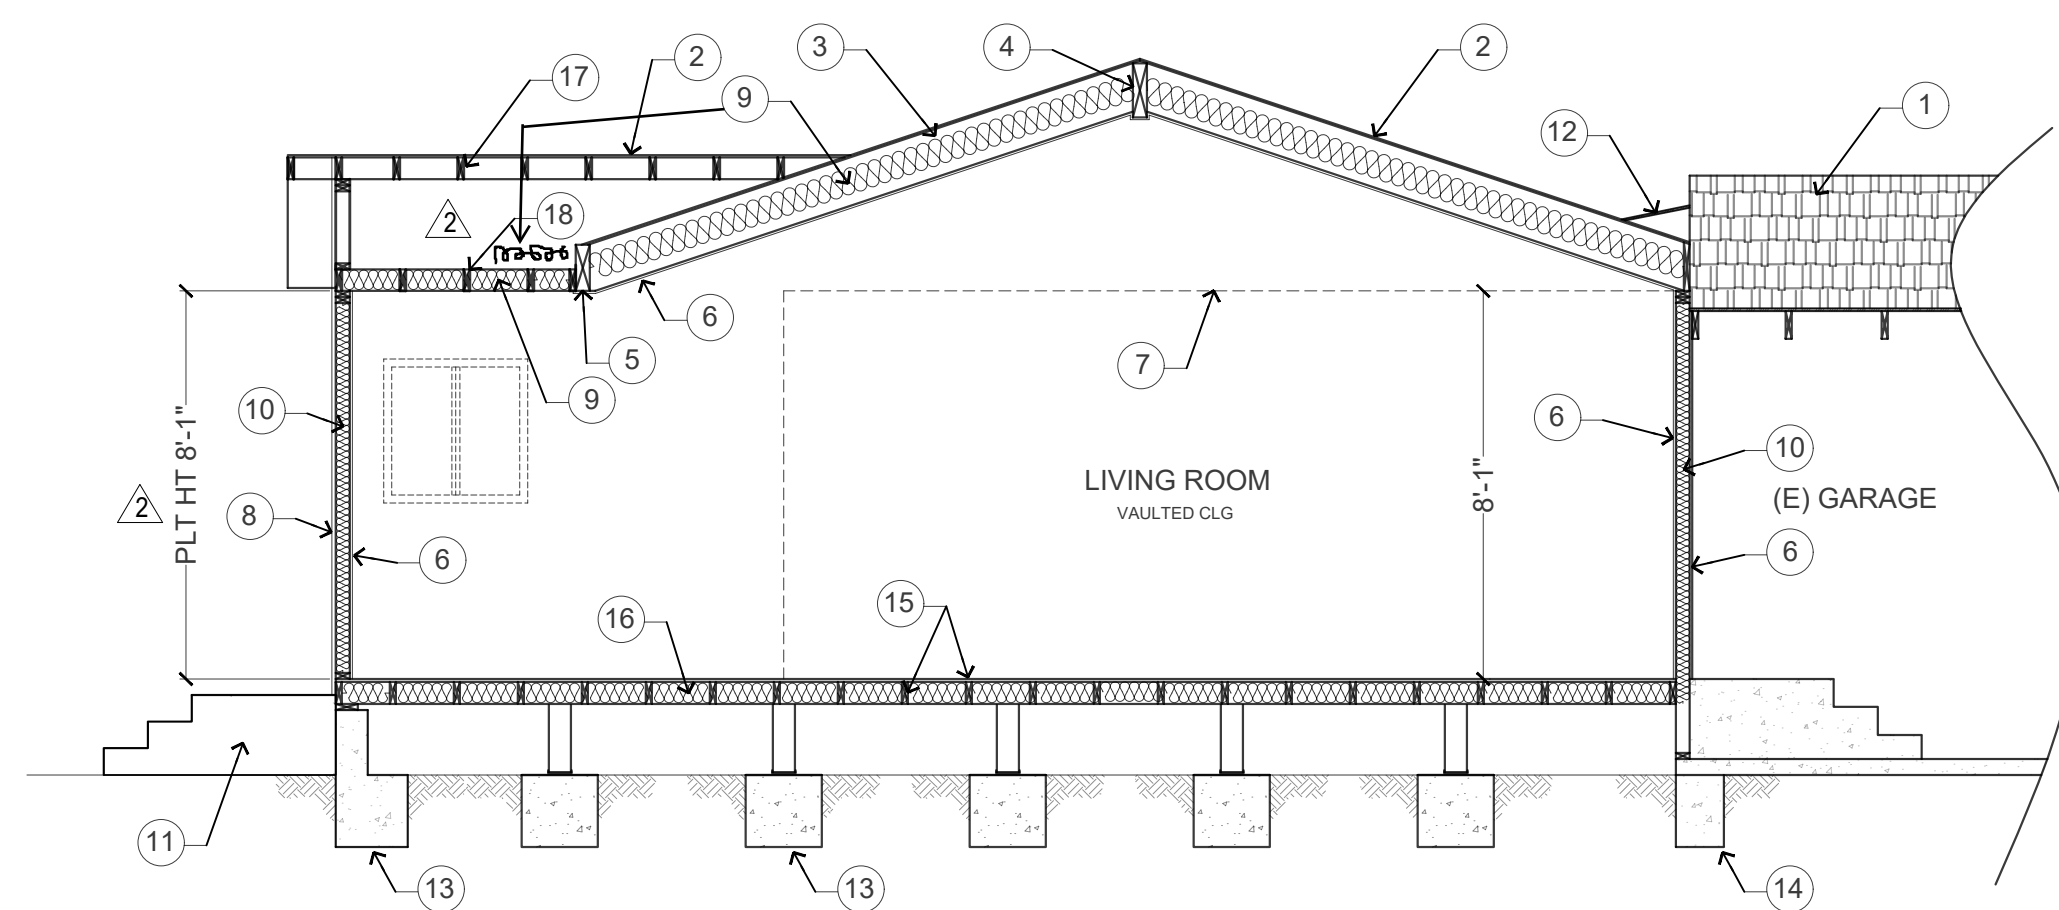

SECTION A-A

SECTION NOTES

- EXISTING ROOFING TO REMAIN.
- NEW ROOFING TO MATCH EXISTING ROOFING IN MATERIAL, STYLE & COLOR.
- NEW ROOF RAFTERS PER PLAN.
- NEW RIDGE BEAM PER PLAN.
- NEW CEILING BEAM PER PLAN.
- 5/8" GYPSUM BOARD AT WALLS & CEILING.
- CEILING LINE AT KITCHEN.
- NEW STUCCO FINISH TO MATCH EXISTING STUCCO IN COLOR & FINISH.
- NEW R-38 INSULATION BETWEEN ROOF RAFTERS.
- NEW R-15 INSULATION AT EXTERIOR WALLS AND AT WALL BETWEEN EXISTING GARAGE & NEW ADDITION.
- CONCRETE LANDING & STEPS PER PLAN.
- BUILT-UP ROOF CRICKET FOR DRAINAGE.
- NEW FOOTING PER PLAN.
- EXISTING FOOTINGS.
- NEW 2 X FLOOR JOIST AND PLYWOOD FLOOR SHEATHING PER PLAN.
- NEW R-19 INSULATION AT RAISED FLOOR SYSTEM.
- NEW ROOF RAFTERS PER STRUCTURAL PLANS.
- NEW CEILING JOIST PER STRUCTURAL PLANS.

REVISIONS	DATE
1st PLAN CHECK	9/29/23
2nd PLAN CHECK	6/11/25

BASIL AMMARI P.E.
202 AMBLING DR.
BREA, CA 92821
TEL: 714-332-0087

PROPOSED ADDITION FOR:
YURI SALMERON
5866 PANAMA DR.
BUENA PARK, CA 90620

SECTIONS



BASIL AMMARI




DRAWN BY DR
CONSULTANT / DESIGNER SIGNATURE
DATE 6/11/2025
SCALE 1/4" = 1'-0"
JOB NO.
SHEET A8

GENERAL REQUIREMENTS

- 1.0 Work performed shall comply with the following:
- 1.1 These general Requirements unless otherwise noted on plans or specifications.
- 1.2 Building Code – CBC 2022.
- 1.3 All applicable local, State and Federal Codes, Ordinances, Laws, regulations and Protective Covenants governing the site of work.
- 1.4 Standard Specifications of ASTM as noted herein and as required by the Building Code.
- 1.5 All work need to be performed by qualified and experience contractors familiar with this type of project.
- 2.0 In case of conflict, the more stringent requirement shall govern.
- 3.0 On site Verification of all dimensions and conditions shall be the responsibility of the contractor and sub-contractors. Noted dimensions take precedent over scale of drawings.
- 4.0 Engineer or architect of record is to be notified immediately by the contractor should any question arise or any discrepancies be found pertaining to the working drawings and/or specifications.
- 5.0 No deviations from these requirements and structural details shall be made without the written approval of engineer.
- Approval by the inspector does not constitute authority to deviate from plans or specifications.
- 6.0 The design, adequacy, and safety of erection bracing, shoring, temporary supports, etc., is the sole responsibility of the contractor, and has not been considered by the architect or engineer. The contractor is responsible for the stability of the structure prior to the application of all shear walls, roof and floor diaphragms, and finish materials. The contractor shall provide the necessary bracing to provide stability prior to the application of the aforementioned materials. Observation visits to the site by the architect or structural engineer shall not imply the assumption of any responsibility in this regard.
- The builder has requested, contracted with and is compensating the Engineer for the limited services of providing the minimum structural engineering drawings required, when combined with the other builders consultants drawings, to obtain a building permit for this project. These drawings are not intended to, nor do they, detail all conditions, identify all materials, or define or limit the scope of work required to complete the project. The builder has requested, accepts, and represents that he will select all materials and manufacturers, qualify and select all subcontractors and installers, direct all ways and means of construction, and provide all additional information, above and beyond these drawings, required to complete the project in conformance with all governing agencies and the work will meet or exceed accepted industry standards.
- 7.0 Special inspection per Building Code Sec. 1704 is required & applies to the following type work: (note: Special inspectors qualification and responsibilities should comply with Building Code Section 1704 Requirements.)
- 7.1 All structural welding, including welding of reinforcing steel and welding of steel decking.
- 7.2 Installation and tightening operations for all high-strength bolting.
- 7.3 Installation and tightening operations for all high-strength anchor bolts.
- 7.4 During the taking of test specimens and placing of all reinforced concrete. Exception: concrete foundation with structural design strength not greater than $f'c=2500$ psi.
- 7.5 During the placement of all masonry indicated on the drawings as having "special inspection".
- 7.6 During driving and testing of piles and construction of cast-in-place drilled piles or caissons.
- 7.7 See foundation notes for other requirements.
- 7.8 • Horizontal wood diaphragms with E.N. equal or closer than 4" o.c. continuous during task.
- Wood shear walls with E.N. equal or less than 4" o.c. Periodically during task including shear transfer details.
- Manufactured shear walls. Periodically during task.
- 8.0 Structural analysis for this project is done per applicable Building Code at the time of design considering standard of care.
- 9.0 Upon completion of above by the engineer & prior to start of construction, contractor is responsible to check all dimensions, coordinate with the work of architectural, mechanical & other trades to ensure compliance with his/her requirements.

STRUCTURAL WOOD

- 1.0 MINIMUM QUALITY
- 1.1 All structural wood shall be of Douglas Fir Larch species, (19% maximum moisture content at the time of construction U.N.O.).
- 1.2 All machine bolts shall conform to ASTM A307. Holes for bolts should be drilled 1/16" larger than bolt dia.
- 1.3 Round washers shall be used on all bolts and should conform with ANSI/ASTM B 18.22.1. Use min. 3" ϕ x 5/64" thick washer for 1/2" ϕ bolt, 3" ϕ x 0.229" thick for 5/8" & 3.5" ϕ x 11/64" for 1" ϕ bolt.
- 1.4 Square washers shall be mild steel. Use min. 3" sq. x 0.229" thick washers for 5/8" ϕ bolts, 3 1/2" sq. x 3/8" thick washers for 1" ϕ bolts.
- 1.5 All nails shall be sinker nails, unless otherwise noted.
- 1.6 Adhesive used to attach floor sheathing to framing elements shall conform with APA specification AFG-01.
- 1.7 Manufactured hardware specified on the drawings are to be Simpson Strong Tie (Unless specifically authorized in writing by engineer Engineering Consulting Group). Follow all manufacturer's requirements & recommendations for installation & handling of the product.
- 1.8 Do not bend the Simpson PA straps.
- 1.9 Fasteners specified on the drawings may be colored using manufacturer's brands that utilize the Trackers color coded system. Follow all manufacturer's requirements and recommendations for installation & handling of the products.

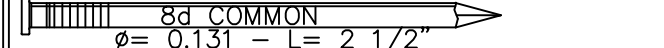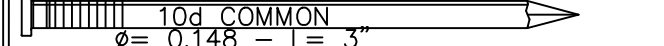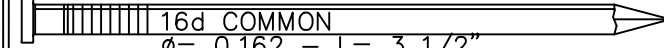COLOR CHART FOR STRUCTURAL NAILS			
TYPE OF FASTENER	SIZE & NUMBER	COLORS	
	$\phi = 0.131$ - L = 2 1/2"		
	$\phi = 0.148$ - L = 3"		
	$\phi = 0.162$ - L = 3 1/2"		
	$\phi = 0.113$ - L = 2 3/8"		
	$\phi = 0.131$ - L = 2 7/8"		
	$\phi = 0.148$ - L = 3 1/4"		

2.0 FRAMING

- 2.1 All framing, bracing, nailing, notching, drilling or boring shall be in accordance with Building Code. Unless more stringent requirements are specified or required by the local Jurisdiction.
- 2.2 Fabrication and handling of Glue-lam beams shall be per ANSI/AITC A 190.1 standard beams to bear legible APA-ENS or AITC grade stand. An APA-ENS CRAN AITC Certificate of conformance for glued-laminated members should be submitted to the field inspector prior to installation. And should have minimum 2400 psi flexural stress, DF/DF-V4 with standard camber (U.N.O.) All beams shall be fabricated using waterproof glue.

GENERAL REQUIREMENTS

- 2.3 All foundation plates or sills, sleepers & any other framing member in contact with concrete or masonry, shall be pressure treated wood of the same species & should be marked or branded by an approved agency. As an alternate, use a layer of 22 gauge sheet metal between the sill and concrete/masonry.
- 2.4 Stud walls perpendicular to a concrete or masonry wall shall be bolted to the concrete or masonry wall with 5/8" diameter x 8" A307 bolts at top, mid-height and bottom.
- 2.5 Structural information shown on framing plans is for the main structural elements. Non-structural elements shall be constructed per approved code requirements.
- 2.6 Conventional construction requirements of chapter 23 for light framed construction should be followed as required.
- 2.7 Weight of the roof tile is considered as 10 psf max. (total roof dead load of 19 psf). If roofing material exceeds this load, the framing contractor should notify engineer in writing prior to construction.
- 2.8 Top plates of all wood stud walls to consist of (2) 2x's the same width as the studs U.N.O. Top plates shall lap a minimum of 48" and be spliced with not less than 6-16d nails spaced not more than 12" on center.
- 2.9 All shear panels shall have continuous sheathing material from one end to the other and from plate to plate as specified on the drawings. Contractor shall coordinate framing such that continuity of shear panels is assured.
- 2.10 All ledgers shall be spliced with ST22 strap, unless noted otherwise.
- 2.11 All shear transfer nailing shall be per drawings, and contractor shall provide proper notification for inspections to review the same.
- 2.12 Provide posts at lower floor under post or multiple studs above. Provide full width and depth compression block between floors at such locations.
- 2.13 All joist hangers shall be Simpson U hanger, all beam hangers shall be Simpson HU hangers U.N.O. on plan or detail. Follow manufacturer's recommendations for installation.
- 2.14 If a double sill plate is used at light-weight concrete flooring, then the framing contractor shall apply sill plate nailing to both sill plates, at 16" o.c. max. or as specified per schedule.
- 2.15 Building Code Table 2308.9.1 balloon framed walls (non-bearing) stud heights:
2x4's @ 16" o.c. maximum 14'-0" height
2x6's @ 16" o.c. maximum 20'-0" height
No multiples of 2x4's are allowed to span more than 14'-0" bearing walls exceeding 10'-0" must be designed case by case.
- 2.16 Use 4X4 header for openings less than 16" at bearing walls without point loads, or at openings less then 4'-0" at non-bearing walls.
Use 2x framing @ medicine cabinet and garage vent. (U.N.O.)
- 3.0 SHOP DRAWINGS
- 3.1 Sufficient copies of shop drawings for any member or product designed by entity other than engineer shall be submitted to engineer prior to fabrication for review. Which will be reviewed & returned in 3 to 5 working days.
- 3.2 Review of shop drawing by engineer does not relieve the engineer responsible for the design or the contractor from compliance with Building Code.
- 3.3 engineer review of the shop drawing consists of checking general conformance with structural drawings. Design accuracy of such product, dimensions and quantity of the product is not reviewed by engineer.
- 3.4 Truss design and fabrication by others.

4.0 CEILING JOISTS

- 4.1 Use this span table for ceiling joists given the following conditions, unless noted otherwise on plans:
a. dead load = 6.0 psf
b. live load = 10.0 psf
c. total deflection = L/240
d. with ceiling drywall
e. use #2 Douglas Fir Larch
- | SIZE | SPACING | MAX. SPAN |
|------|---------|-----------|
| 2x4 | 12" | 9'-0" |
| | 16" | 8'-4" |
| | 24" | 16'-7" |
| 2x6 | 12" | 15'-1" |
| | 16" | 13'-2" |
| | 24" | 21'-11" |
| 2x8 | 12" | 19'-11" |
| | 16" | 17'-4" |

7.0 REINFORCED CONCRETE

- 7.1 GENERAL
- All reinforced concrete materials and construction shall conform to Building Code, chapter 19.
- 7.2 MATERIALS
- 7.2.1 Cement shall conform to Section 1903 of Building Code and shall correspond to that on which the selection of concrete proportions were based.
- 7.2.2 Concrete aggregates shall conform to Building Code Section 1903
- 7.2.3 Reinforcing steel shall conform to ASTM A615. Grade 40 for sizes #3 and #4 and grade 60 for sizes #5 and larger.
- 7.2.4 Dowels shall be equal in size and spacing.
- 7.2.5 Refer to Table 1904 of Building Code for special exposure condition as required by soils engineer & see corrosion engineer recommendations for concrete exposed to corrosion.
- 7.3 STRENGTH
- 7.3.1 Concrete shall be proportioned to provide a minimum compressive strength, $f'c$, equal to 4500 psi (28 days), unless noted otherwise.
Use type V cement
- 7.3.2 Special inspection is required for concrete with $f'c > 2500$ psi. U.N.O.
- 7.4 All reinforcing, dowels, holdowns, and other inserts shall be secured in position and approved by the local building official prior to the pouring of any concrete.
- 7.5 Min. concrete cover for reinforcing:
a- Concrete, placed against earth not formed - 3"
b- Concrete formed or troweled - 2"
c- Walls and curbs - 1 1/2"
d- Slab on grade - at center

8.0 FOUNDATION

- 8.1 All continuous exterior footing to have 5/8"dia. x min. 12" anchor bolts with 3"x3"x0.229" plate washer, min. 7" embedment into concrete, at 72" o.c. unless noted otherwise on plans. one anchor bolt should be located max. 12" away from the end of the sill plates. min. (2) A.B.'s per sill plate / shear panel.
- 8.2 All interior non-shear walls to have HILTI X-DNI 0.1456 pins with a minimum penetration of 1 1/4" into slab) at 16" on center unless noted otherwise to be installed in accordance with ICC ER-1290 & ESR 1663. Actual slab thickness to be minimum 4". All interior shear walls to have A.B.'s per 8.1.

- 8.3 All holdowns and post anchors to be installed according to most current Simpson Strong Tie specifications and requirements of ICC-ER report and shall be tied in place prior to foundation inspection.
- 8.3.1 Dimensions are not furnished to Simpson holdowns. It is the responsibility of the contractor's superintendent, the framing contractor and the concrete contractor to locate these anchors in the exact location. Refer to details for proper installation.
- 8.4 Min. concrete width to be 8" for receiving MPA's and HPAHD22's/STHD's. Verify locations of holdowns and anchor bolts with rough framing to assure prior and accurate installation.
- 8.5 Provide #3 X 24" X 24" dowel at 24" o.c. and 12" from the corner at all concrete stoops and porches.
- 8.6 Provide min. (1) #4 reinforcing for electrical ground, location to be verified with the electrical contractor.
- 8.7 Verify min. foundation depth, width, reinforcing steel and additional expansive soil requirements with valid soils report and if more stringent, they shall supersede the above minimum requirement.
- 8.8 See Section 7.3.1 for concrete strength.
- 8.9 Admixtures in concrete mix. containing calcium chlorides shall not be used.
- 8.10 Footings shall be examined and certified in writing by the project soil/geology engineer prior to inspection and placement of concrete.
- 8.11 Concrete shall be to the strength and slump as specified per structural design and consist of Portland cement ASTM C-150 Type V per soils engineer's recommendations and Building Code Table 1904.3 when concrete is exposed to sulfate containing solutions and aggregates per ASTM C-33, water to be clean and potable.
- 8.12 Placement shall be in one continuous operation unless otherwise specified and slab surface shall be cured with Hunts compound or equal or other methods in accordance with good construction practices at contractor's option.
- 8.13 Contractor shall dampen slab underlayment of sand/membrane just prior to concrete placement to assist uniform concrete curing.
- 8.13.1 Slabs must not be poured during or immediately after rainstorms. The specified sand over visqueen should not be saturated at the time of the concrete pour. Any free water trapped in the sand layer must be removed prior to the concrete pour.
- 8.13.2 Requirements for pre-saturation of subgrade soils and daylight setback of exterior footings from any descending slope shall comply with soil report recommendations.
- 8.14 The bottoms of footing excavations shall be level, clean and free of loose material or water when concrete is placed. Over excavation shall be filled with concrete or properly compacted fill that has been tested and approved by the soils engineer. Back fill shall not be placed until supporting foundations, walls and slab have attained sufficient strength to support lateral soil pressure.
- 8.15 Concrete placement shall be monolithic in one continuous operation uniformly placed and must be vibrated and well consolidated unless shown otherwise on plans. For non-mono pour (non-mono pour is defined by ACI as to when 1st. & 2nd. pour can not be vibrated together), use #4 dowels at 24" o.c. min. 18" into slab and 12" into 1st. pour.
- 8.16 Floor slab shall be poured level to 1/8" in 10'.
- 8.17 Requirements for pre-saturation of sub grade soil and daylight setback of footing from any descending slope shall comply with current soils report.
- 8.18 Finish grade around the perimeter of slab shall be constructed such that rain and irrigation water is drained away from the slab.
- 8.19 All site and pad preparation, such as but not limited to shading compacting of the fill, pre-saturation, and concrete slab base preparation, shall be performed in accordance with the soil engineer's recommendation and soil report.
- 8.20 Foundation drawings prepared by engineer reflect the structural requirements, refer to architectural plans for dimensions depressions, slope shelves patios, stoops and porches not shown. Accuracy of the dimensions and final fit of the building shall be reviewed by the architect and the contractor prior to construction.
- 8.21 Waiting period for concrete slabs-on-grade prior to start of construction as follow:
a) Walk on slab 24 hours after concrete has been poured.
b) Begin wall framing 4-5 days after concrete poured.
c) Begin roof/floor framing 7-10 days after concrete poured.
d) Do not load roof prior to 14 days after concrete poured.
- 8.22 No pipes or conduits shall extend under isolated column footing or under continuous wall footings unless specifically detailed or approved by the architect and structural engineer and the building official.
- 8.23 The contractor shall arrange for observation of the work by the soils engineer, following are requirements of the soils engineer:
a) All footing excavations shall be inspected and certified in compliance with the soils report by the soil engineer prior to placing of concrete or steel.
b) Soil conditions, including compacting and moisture content, shall be inspected and certified in compliance with the soil report by the soils engineer prior to placing of concrete or steel.
c) A certificate of compliance shall be submitted to the building official prior to his foundation inspection and to the architect and structural engineer.
- 8.24 Prior to the contractor requesting a Building Department foundation inspection, the soil engineer shall advise the building official in writing that:
a. The building pad was prepared in accordance with the soil report.
b. The utility trenches have been properly backfilled and compacted
c. The foundation excavations, the soils expansive characteristics and bearing capacity conform to the soils report.

9.0 MISCELLANEOUS

- 9.1 Grout under base plates shall be non-shrinking type and shall have compressive strength equal to concrete or masonry supporting it.
- 9.2 All grade beams shall be poured monolithically for their entire length.
- 9.3 All reinforcing to be accurately and securely located prior to pouring concrete or grouting masonry.
- 9.4 All horizontal reinforcement to have matching dowels at corners of walls. All vertical reinforcement to have matching dowels to footing, unless otherwise noted.
- 9.5 SHEET ROCK ON FRAMING

Stacked sheet rock loading shall be limited to the following quantities in any one room:
5/8" : 16 individual 4x10 sheets (8 pairs of sheets)
1/2" : 20 individual 4x10 sheets (10 pairs of sheets)
The shoring of the 2nd floor is required if the number of sheet rock exceeds the quantities listed above.

10.0 DESIGN CRITERIA

10.2 LATERAL LOADS:
RISK CATEGORY: II
Site Class: D
Ss: 150.0 % g
SI: 53.1 % g
R: 6.5
Seismic base shear V=0.154
RISK CATEGORY: II
SEISMIC RESISTANT SYSTEM: LIGHT FRAMED PLYWOOD SHEAR WALLS

WIND:
Wind speed: 110
Wind exposure: C
Wind Pressure: qz=22.25 PSF

10.3 DESIGN LOADS:
Roof Load
Dead Load=15 psf
Live Load=20 psf
Total=35 psf

Floor Loads
Dead Load=12 psf
Live Load=40 psf
Total=52 psf

10.4 LUMBER GRADES
6x & 8x posts/beams/headers: #1 DFL
4x beams and headers: #2 DFL
2x joists/rafters: #2 DFL
Studs: Stud grade
Top plates: D.F.L. construction standard, standard or better.
All mud sills to be P.T. DFL

10.5 TYPICAL FLOOR SHEATHING
23/32" APA rated Sturd-I-Floor T&G Exp I with min. a panel index of 24
Refer to NER 108 for installation and conditions of use
B.N.:10d common nails at 6" o.c.
E.N.:10d common nails at 6" o.c.
F.N.:10d common nails at 12" o.c.

ALT. Use ring or screw shank nails and glue sheathing to framing using adhesives meeting APA specification AFG-01 or ASTM D3498. Apply glue in accordance with manufacturer's recommendations.

Use Grabber plywood screw min. 2" long at 6" o.c. B.N., 6" o.c. E.N., and 12" o.c. field nailing (ICC-ER-5280) or simpson strong tie quick drive screws (ICC-ER 5053)

10.6 TYPICAL ROOF SHEATHING
15/32" APA rated sheathing Exp I with a min. panel index of 32/16. refer to NER 108 for installation and conditions of use.
B.N.:8d common nail at 6" o.c.
E.N.:8d common nail at 6" o.c.
F.N.:8d common nail at 12" o.c.

*Note: All structural rated panels must be stamped by one of the following approved agencies, APA, PFS/TECO or Pittsburg.

REQUIRED SPECIAL INSPECTION:

In addition to the regular inspection, the following items will also require special inspection in accordance with Sec. 1704 of the Building Code.

Soils compliance prior to the foundation inspection, pre-stress foundation, high strength steel and concrete.

Application of missed anchor bolts or holdowns per provided details.

Anchor bolts and holdowns into existing footings.

NAILING SCHEDULE

CONNECTION	NAILING *
1. JOIST TO SILL OR GIRDER, TOENAIL	3-8d
2. BRIDGING TO JOIST, TOENAIL EACH END	2-8d
3. 1" X 6" SUBFLOOR OR LESS TO EACH JOIST, FACE NAIL	2-8d
4. WIDER THAN 1" X 6" SUBFLOOR TO EACH JOIST, FACE NAIL	3-8d
5. 2" SUBFLOOR TO JOIST OR GIRDER, BLIND AND FACE NAIL	2-16d
6. SOLE PLATE TO JOIST OR BLOCKING, FACE NAIL	16d AT 16" O.C.
7. TOP PLATE TO STUD, END NAIL	(3) 16d PER 16"
8. STUD TO SOLE PLATE	4-8d, TOENAIL OR 2-16d, END NAIL
9. DOUBLE STUDS, FACE NAIL	16d AT 24" O.C.
10. DOUBLED TOP PLATES, FACE NAIL	16d AT 16" O.C.
11. BLOCKING BETWEEN JOIST OR RAFTERS TO TOP PLATE, TOENAIL	3-8d
12. RIM JOIST TO TOP PLATE, TOE NAIL	8d AT 6" O.C.
13. TOP PLATES, LAPS AND INTERSECTIONS, FACE NAIL	2-16d
14. CONTINUOUS HEADER, TWO PIECES	16d AT 16" O.C. ALONG EACH EDGE
15. CEILING JOISTS TO PLATE, TOENAIL	3-8d
16. CONTINUOUS HEADER TO STUD, TOENAIL	4-8d
17. CEILING JOISTS, LAPS OVER PARTITIONS, FACE NAIL	3-16d
18. CEILING JOISTS TO PARALLEL RAFTERS, FACE NAIL	3-16d
19. RAFTER TO PLATE, TOENAIL	3-8d
20. 1" BRACE TO EACH STUD AND PLATE, FACE NAIL	2-8d
21. 1" X 8" SHEATHING OR LESS TO EACH BEARING, FACE NAIL	2-8d
22. WIDER THAN 1" X 8" SHEATHING TO EACH BEARING, FACE NAIL	3-8d
23. BUILT-UP CORNER STUDS	16d AT 24" O.C.
24. BUILT-UP GIRDER AND BEAMS	20d AT 32" O.C. AT TOP AND BOTTOM AND STAGGERED 2-20d AT ENDS AND AT EACH SPLICE
25. 2" PLANKS	2-16d AT EACH BEARING

* NOTE: COMMON OR BOX NAILS MAY BE USED (U.N.O.)

REVISIONS	DATE


BASIL AMMARI P.E.
202 AMBLING DR.
BREA, CA 92821
TEL: 714-332-0087

PROPOSED ROOM ADDITION FOR:
YURI SALMERON
5866 PANAMA DR.
BUENA PARK, CA 90620

STRUCTURAL NOTES



DRAWN BY D.R.
CONSULTANT / DESIGNER SIGNATURE
DATE 12/20/2024
SCALE NTS
JOB NO.
SHEET GN

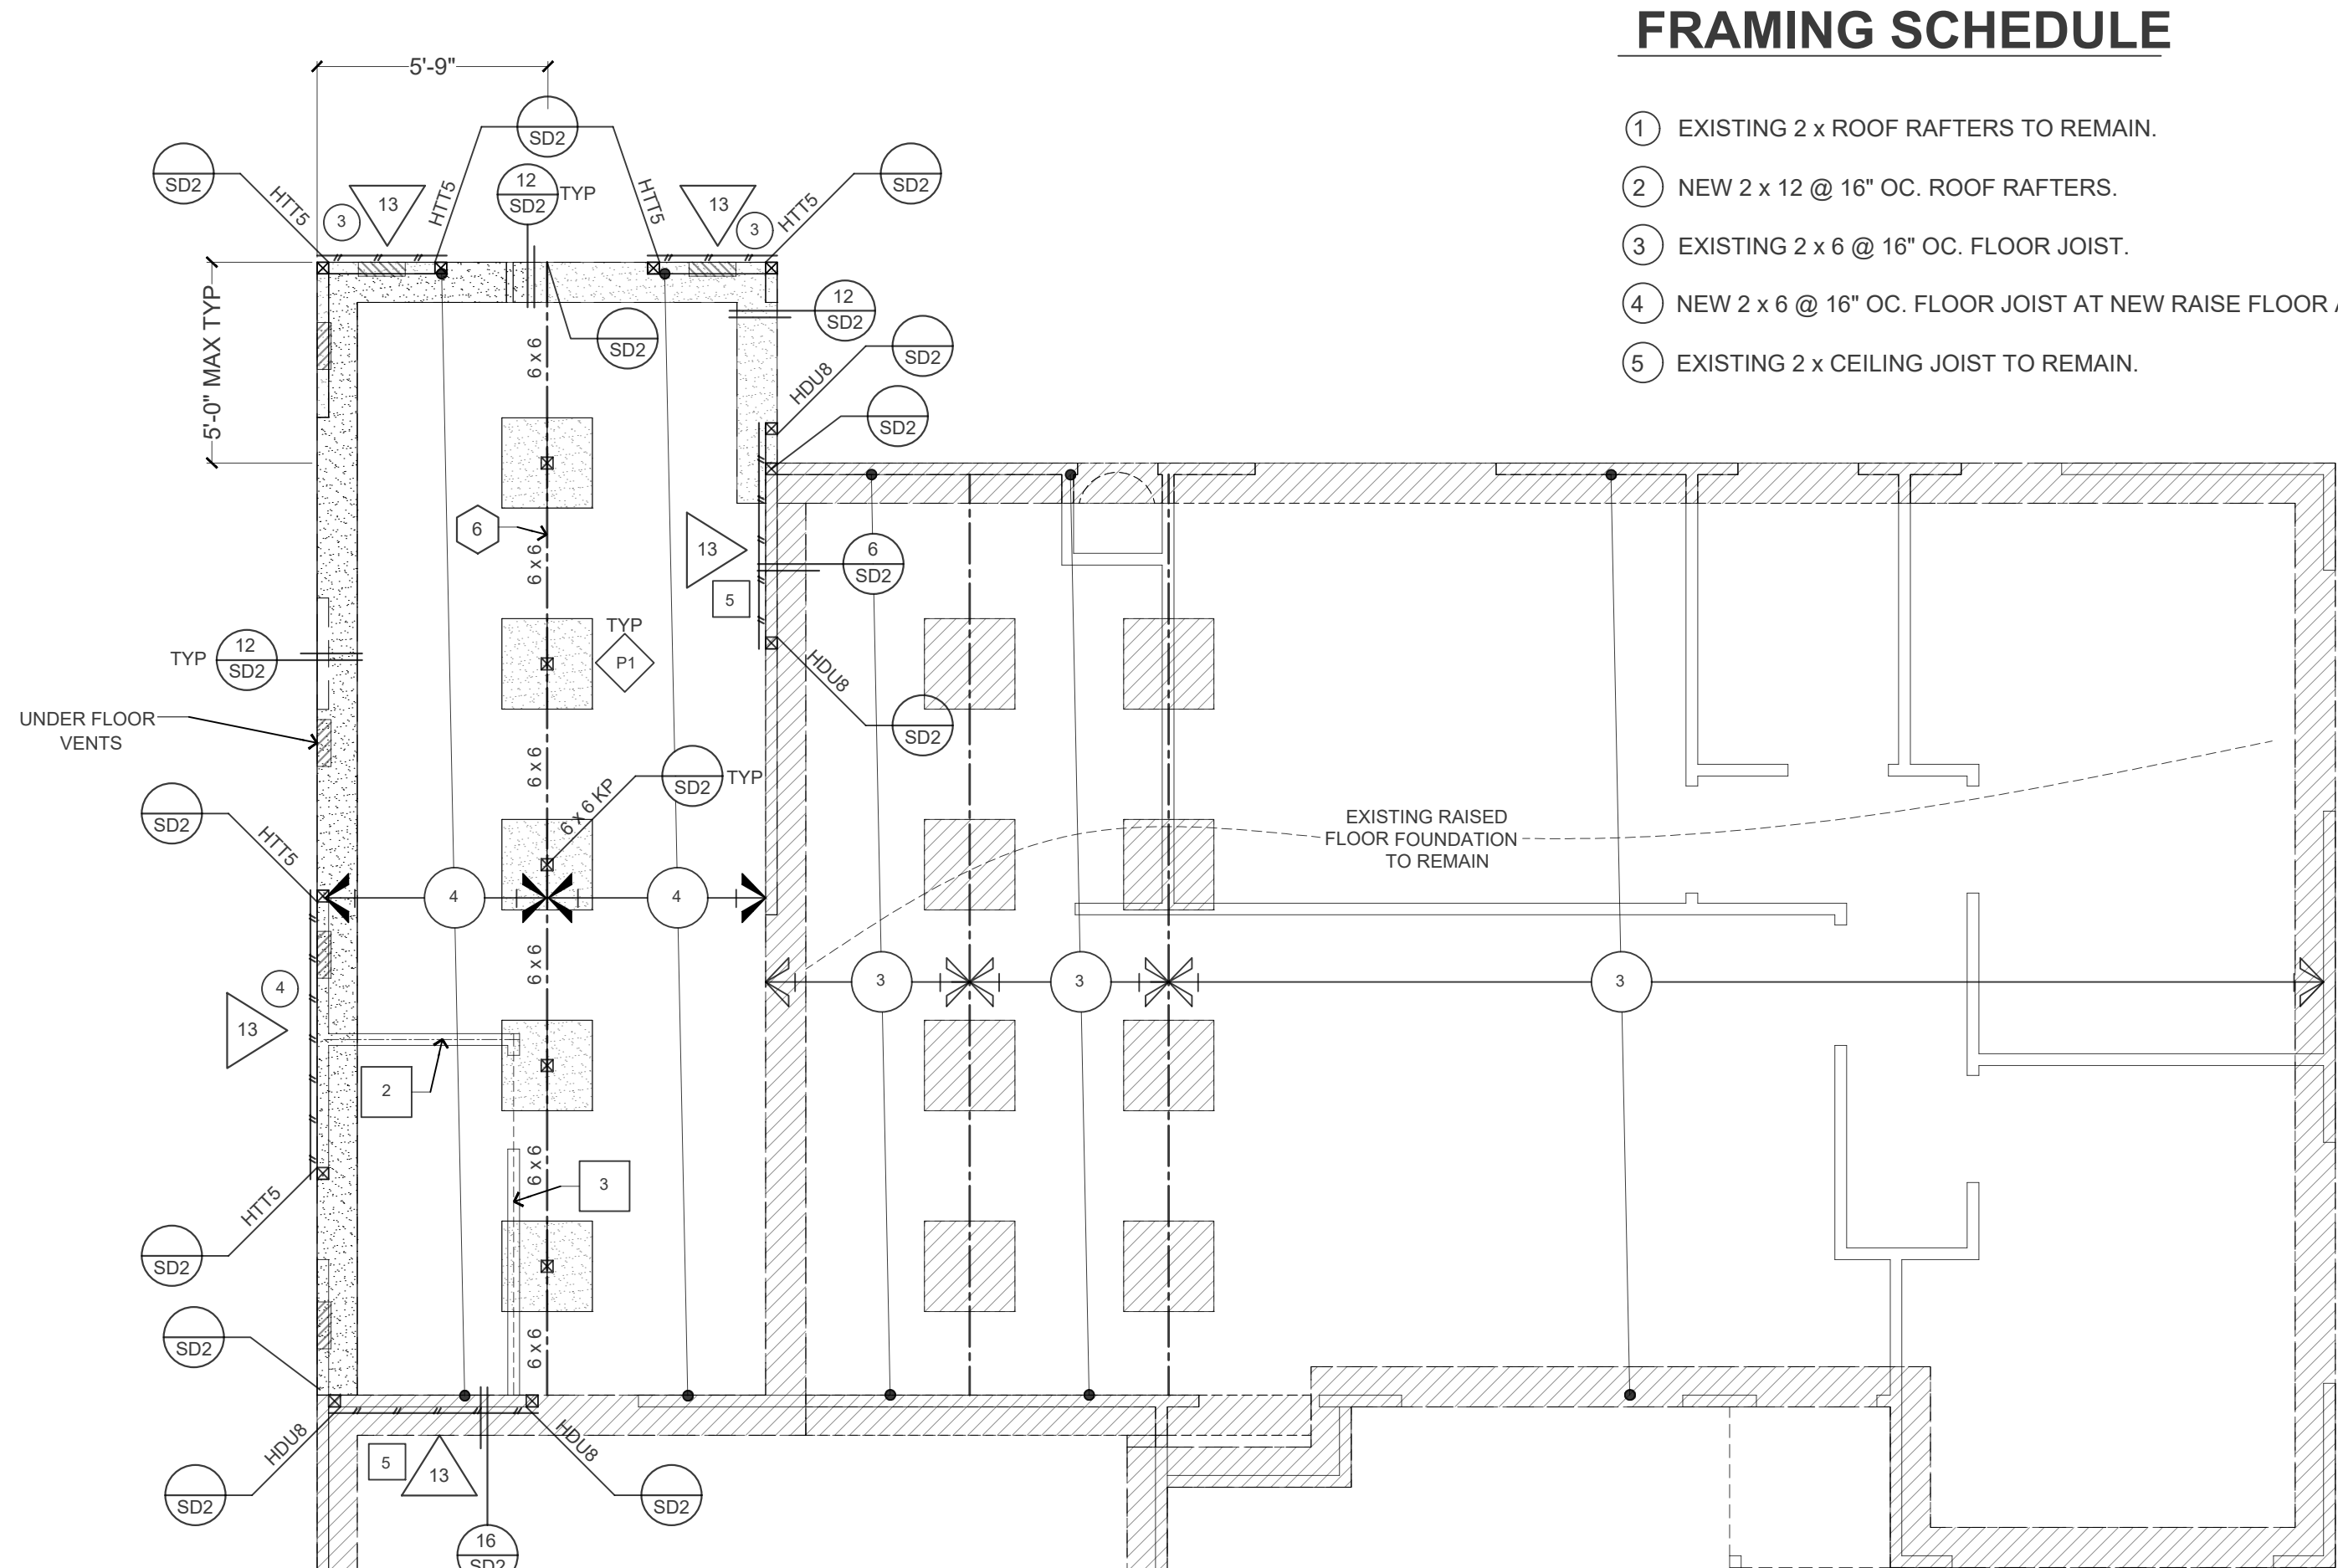

- FRAMING SCHEDULE**
- EXISTING 2 x ROOF RAFTERS TO REMAIN.
 - NEW 2 x 12 @ 16" OC. ROOF RAFTERS.
 - EXISTING 2 x 6 @ 16" OC. FLOOR JOIST.
 - NEW 2 x 6 @ 16" OC. FLOOR JOIST AT NEW RAISE FLOOR AREA.
 - EXISTING 2 x CEILING JOIST TO REMAIN.

UNDER- FLOOR VENTILATION CALCULATION

*TOTAL NEW FLOOR AREA = 328 SQ. FT.

*REQUIRED VENTILATION = 328 / 150 = 2.2 SQ. FT. = 315 SQ. IN.

*PROVIDE (6) UNDER-FLOOR VENTS = (6) *(60) = 360 SQ.IN.

5 1/2" x 14" UNDER FLOOR VENTS. NET FREE AREA = 60 SQ. IN.

*VENTS SHALL BE CORROSION-RESISTANT WIRE MESH WITH MIN. 1/8" OPENING AND MAX. 1/4" OPENING.

SYMBOLS LEGEND

DETAIL NUMBER
DETAIL SHEET NUMBER

EXISTING FOOTINGS, TO BE SITE VERIFIED BY GENERAL CONTRACTOR.

NEW 12" x 18" CONTINUOUS CONCRETE FOOTINGS WITH 2 #5 TOP & 2 #5 BOTTOM.

TYP : TYPICAL APPLICATION AT ALL SIMILAR LOCATIONS.

- # OF 5/8" DIA. x 12" ANCHOR BOLTS @ SHEAR WALLS EQUALLY SPACED. (@ NEW FOOTINGS).

- # OF 5/8" DIA. x 10" ANCHOR BOLTS INTO EXISTING FOOTINGS EQUALLY SPACED AT SHEAR WALLS, MIN. 6" EMBEDMENT. USE SIMPSON SET-EPOXY ICC-ESR-2508 "SPECIAL INSPECTION IS REQUIRED"

PAD SCHEDULE

2'-3" SQ. x 24" DEEP WITH 5 #5 BARS EACH WAY.

KEY NOTES

PROVIDE 2-2 x 6 FLOOR JOISTS UNDER WALLS @ THESE LOCATIONS. TYP.

PROVIDE 2 x 6 FULL HEIGHT BLOCKING UNDER WALLS. TYP.

NOTE:

ALL EXISTING FOOTING AND RAISED FLOOR SYSTEM IS TO BE FIELD VERIFIED BY THE GENERAL CONTRACTOR.

SHEAR WALL SCHEDULE

2022 CALIFORNIA BUILDING CODE

SHEAR PANEL TYPE	SHEATHING	EDGE NAILING (COMMON)	FIELD NAILING (COMMON)	SHEAR CAPACITY (PLF)	SILL CONNECTION	FRAMING CLIPS	ANCHOR BOLT SPACING
3/8" APA RATED		8 d's @ 6" O.C.	8 d's @ 12" O.C.	260	@ 3" O.C. @ 24" O.C.	A35's,LS50's OR LTP4's	5/8" ø x 12" @ 24" O.C.
3/8" APA RATED		8 d's @ 4" O.C.	8 d's @ 12" O.C.	350	@ 3" O.C. @ 16" O.C.		5/8" ø x 12" @ 24" O.C.
3/8" APA RATED		8 d's @ 3" O.C.	8 d's @ 12" O.C.	480	@ 2.5" O.C. @ 12" O.C.		5/8" ø x 12" @ 12" O.C.
15/32" APA RATED STRUCTURAL-I		10 d's @ 3" O.C.	10 d's @ 12" O.C.	600	@ 2" O.C. @ 8" O.C.		5/8" ø x 12" (U.N.O.) @ 8" O.C.
15/32" APA RATED STRUCTURAL-I		10 d's @ 2" O.C.	10 d's @ 12" O.C.	870	2 ROWS STAGGED @ 3" O.C. @ 8" O.C. (**)		5/8" ø x 12" (U.N.O.) @ 16" O.C. W/ 3 x 6 SILL
3/8" APA RATED		8 d's @ 3" O.C.	8 d's @ 12" O.C.	960	SEE TRANSFER DETAIL @ 6" O.C.	SEE SHEAR TRANSFER DETAIL	5/8" ø x 12" @ 16" O.C. W/ 3 x 6 SILL
15/32" APA RATED STRUCTURAL-I		10 d's @ 3" O.C.	10 d's @ 12" O.C.	1200	SEE TRANSFER DETAIL @ 4" O.C.	SEE SHEAR TRANSFER DETAIL	5/8" ø x 12" @ 12" O.C. W/ 3 x 6 SILL
15/32" APA RATED STRUCTURAL-I		10 d's @ 2" O.C.	10 d's @ 12" O.C.	1740	N / A @ 3" O.C.	SEE SHEAR TRANSFER DETAIL	5/8" ø x 12" @ 8" O.C. W/ 3 x 6 SILL

(*) PROVIDE 3" NOMINAL OR WIDER FRAMING AT ADJOINING PANEL EDGES WITH NAILS STAGGERED.

(**) PROVIDE SHEAR TRANSFER DETAIL, USE MIN. 3 1/2" WIDE FRAMING MEMBERS TO RECEIVE SILL PLATE NAILING.

USE A35 @ 6" O.C. ON SIMPSON STRONG WALL & HARDY PANEL (U.N.O.)

MIN. 3 1/2" RIM OR BLOCKING IS REQUIRED TO RECEIVE SDS SCREWS. PLACE SCREWS AT CENTER / STAGGERED BY 1/2".

FOUNDATION NOTES

- ALL NEW CONTINUOUS FOOTINGS SHALL BE 12" x 18" DEEP W/ 2 #5 BARS TOP AND 2 #5 BARS BOTTOM.
- ALL FOUNDATION EXCAVATIONS SHOULD BE OBSERVED PRIOR TO THE PLACEMENT OF FORMS, REINFORCEMENT OR CONCRETE.
- ALL SLABS ON GRADE SHALL BE MIN. 4" THICK WITH #4 BARS @ 16" OC EACH WAY.
- ALL CONTINUOUS EXTERIOR FOOTINGS TO HAVE 5/8" DIA. x 12" A.B. WITH 7" MIN. EMBEDMENT INTO CONCRETE @ 48" O.C. UNLESS NOTED OTHERWISE ON PLANS.
- LOCATE 1 - A.B. WITHIN 12" FROM THE END OF THE SILL PLATE OF A SHEAR WALL AND 1 - A.B. AT EACH SIDE OF ANY SILL PLATE BREAK WITH 6" MIN. END DISTANCE.
- PROVIDE MIN. 2 - A.B. PER SHEAR PANEL.
- ALL INTERIOR NON SHEAR WALLS TO HAVE HILTI X-DNI WITH A MIN. PENETRATION OF 1 1/4" INTO SLAB AT 24" O.C. INSTALL PER ICC-ER 1290, ESR-1863.
- PROVIDE MIN. (2) #5 BAR AT TOP AND (2) #5 BAR AT THE BOTTOM FOR ALL CONTINUOUS FOOTINGS IN ADDITION TO (1) #4 BAR FOR ELECTRICAL GROUND. LOCATION TO BE VERIFIED BY ELECTRICAL CONTRACTOR.
- PROVIDE #4, 24" x 24" DOWELS AT 24" O.C. AND 12" FROM CORNERS AT ALL CONCRETE STOOPS AND PORCHES.
- VERIFY MIN. FOUNDATION DEPTH, WIDTH, REINFORCING STEEL WITH VALID SOILS REPORT AND IF ANY MORE RESTRICTIVE, THEY SHALL SUPERSEDE THE ABOVE MINIMUM REQUIREMENTS. "WHERE SOILS REPORTS ARE AVAILABLE"
- VERIFY HOLDOWN AND ANCHOR BOLT LOCATIONS WITH THE ROUGH FRAMING CONTRACTOR IN ORDER TO INSURE PROPER AND ACCURATE INSTALLATION.
- ALL HOLDOWNS SHALL BE TIED IN PLACE PRIOR TO FOUNDATION OR FOOTING INSPECTION.
- ALL HOLDOWNS AND ANCHOR BOLTS SHALL BE INSTALLED PER SIMPSON STRONG TIE SPECIFICATIONS AND REQUIREMENTS. I
- CONCRETE STRENGTH TO BE MIN. 2500 PSI. (U.N.O.).
- FOUNDATION SHALL BE EXAMINED AND CERTIFIED IN WRITING BY THE PROJECT SOILS ENGINEER PRIOR TO INSPECTION AND PLACEMENT OF CONCRETE. WHERE SOILS REPORT IS AVAILABLE.
- USE 3" x 3" x .229" PLATE WASHERS FOR ANCHOR BOLTS AT SHEAR WALL LOCATIONS.

REVISIONS

DATE

1st PLAN CHECK

9/29/23

2nd PLAN CHECK

6/11/25

BASIL AMMARI P.E.
202 AMBLING DR.
BREA, CA 92821
TEL: 714-332-0087

PROPOSED ADDITION FOR:
YURI SALMERON
5866 PANAMA DR.
BUENA PARK, CA 90620

FOUNDATION PLAN



BASIL AMMARI

DRAWN BY
DR

CONSULTANT / DESIGNER SIGNATURE

DATE

6/11/2025


SCALE

1/4" = 1'-0"

JOB NO.

SHEET

S1

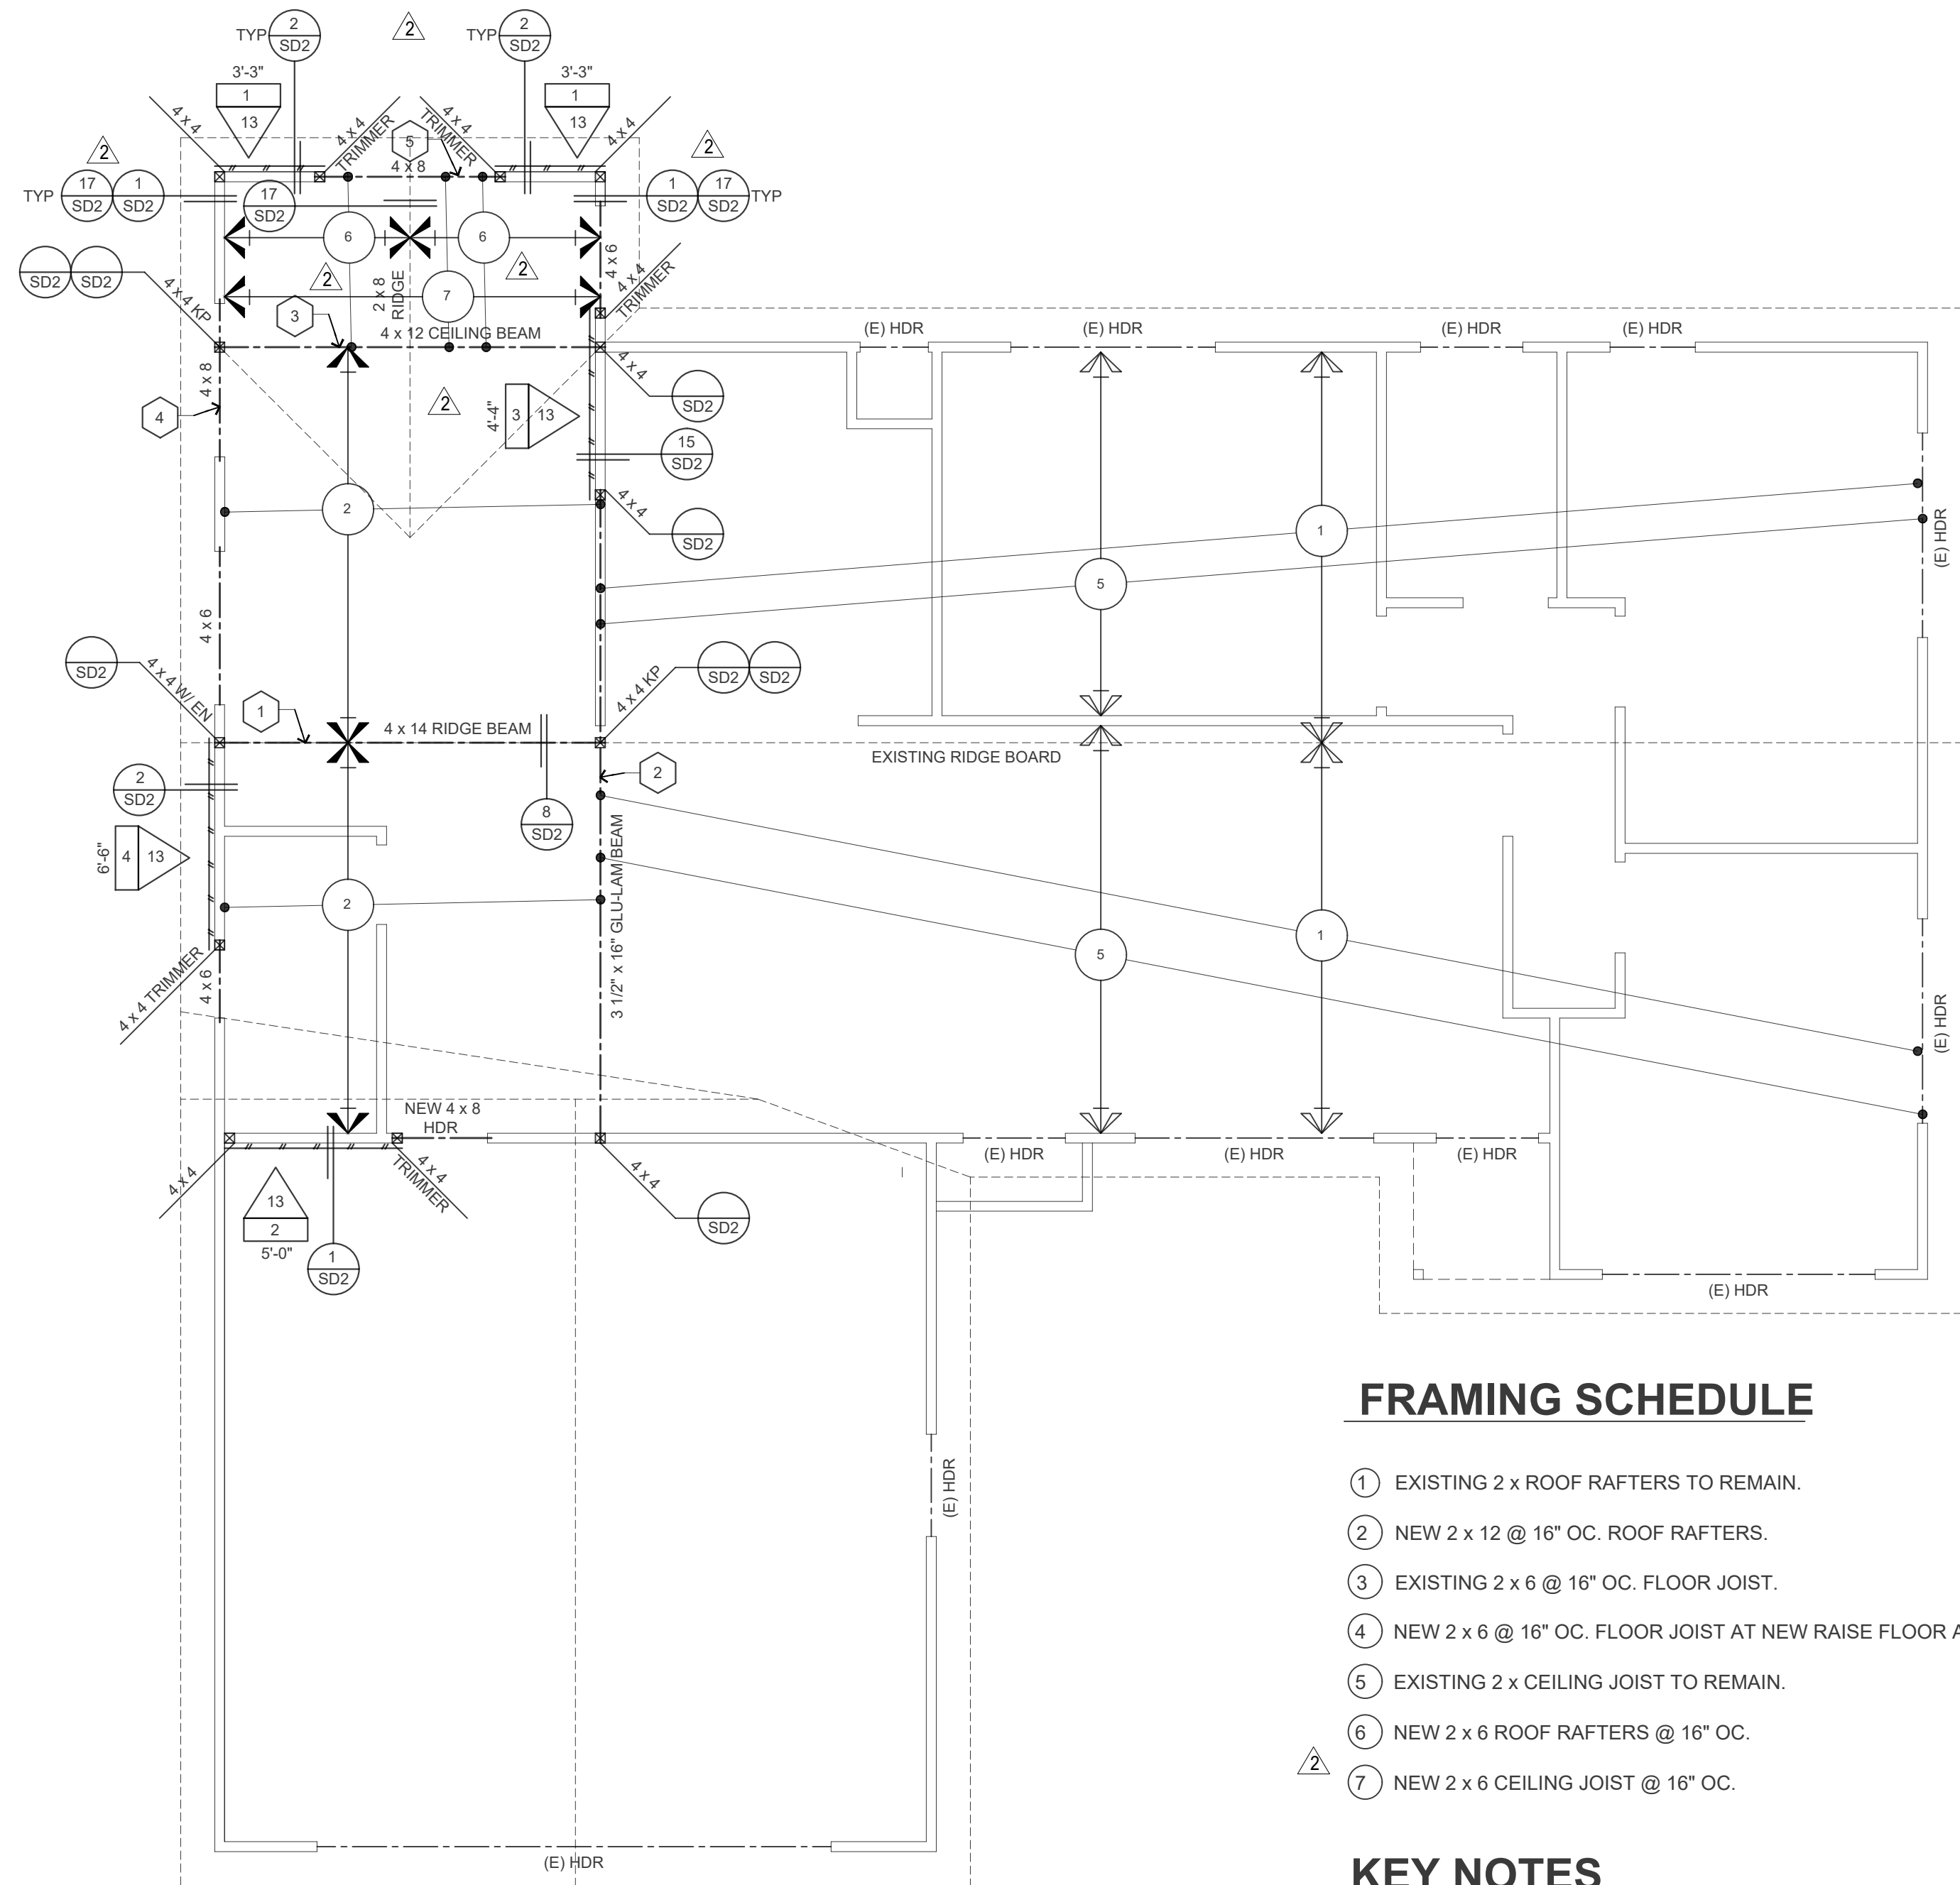

FRAMING SCHEDULE

- 1 EXISTING 2 x ROOF RAFTERS TO REMAIN.
- 2 NEW 2 x 12 @ 16" OC. ROOF RAFTERS.
- 3 EXISTING 2 x 6 @ 16" OC. FLOOR JOIST.
- 4 NEW 2 x 6 @ 16" OC. FLOOR JOIST AT NEW RAISE FLOOR AREA.
- 5 EXISTING 2 x CEILING JOIST TO REMAIN.
- 6 NEW 2 x 6 ROOF RAFTERS @ 16" OC.
- 7 NEW 2 x 6 CEILING JOIST @ 16" OC.

KEY NOTES

- 1 APPLY DETAIL 4/SD2 AT ALL TOP PLATE SPLICES.

NOTES

*ROOF DIAPHRAGMS NAILING TO BE INSPECTED BEFORE COVERING. FACE GRAIN OF PLYWOOD SHALL BE PERPENDICULAR TO SUPPORTS.

*HOLDOWN CONNECTOR BOLTS INTO WOOD FRAMING REQUIRED APPROVED PLATE WASHERS AND HOLDDOWNS SHALL BE TIGHTENED JUST PRIOR TO COVERING THE WALL FRAMING.

*FOUNDATION ANCHOR BOLTS IN WALLS SHALL HAVE AN APPROVED PLATE WASHER UNDER EACH NUT, AND THE NUTS SHALL BE TIGHTENED JUST PRIOR TO COVERING THE WALL FRAMING. USE MINIMUM 3" x 3" x 0.229" THICK WASHER ON EACH BOLT.

*ALL EXTERIOR WALLS ARE 2 x 4 @ 16" OC.

*APPLY DETAIL 4/SD2 AT ALL TOP PLATE SPLICES.

*ALL EXISTING FRAMING MEMBERS, FOOTINGS...ETC. SHALL BE FIELD VERIFIED BY THE GENERAL CONTRACTOR AND HOME OWNER. ENGINEER OF RECORD SHALL BE NOTIFIED IN WRITING IF EXISTING CONDITIONS ARE DIFFERENT THAN WHAT ARE SHOWN ON THESE PLANS. FIELD FIXES MAY BE REQUIRED.

SHEAR WALL SCHEDULE

2022 CALIFORNIA BUILDING CODE

SHEAR PANEL TYPE	SHEATHING	NAILING (COMMON)	FIELD NAILING (COMMON)	SHEAR CAPACITY (PLF)	SILL CONNECTION 16dfs SHINKER OR 16dfs SHINKER	FRAMING CLIPS A35%LS509s OR LTP44s	ANCHOR BOLT SPACING
10	3/8" APA RATED	8 d's @ 6" O.C.	8 d's @ 12" O.C.	280	@ 3" O.C. @ 24" O.C.	@ 12" O.C.	5/8" ø x 12" @ 24" O.C.
11	3/8" APA RATED	8 d's @ 4" O.C.	8 d's @ 12" O.C.	350	@ 3" O.C. @ 16" O.C.	@ 10" O.C.	5/8" ø x 12" @ 24" O.C.
12	3/8" APA RATED	8 d's @ 3" O.C.	8 d's @ 12" O.C.	480	@ 2.5" O.C. @ 12" O.C.	@ 8" O.C.	5/8" ø x 12" @ 12" O.C.
13	15/32" APA RATED	10 d's @ 3" O.C.	10 d's @ 12" O.C.	600	@ 2" O.C. @ 8" O.C.	@ 6" O.C. (U.N.O.)	5/8" ø x 12" @ 8" O.C.
14	15/32" APA RATED	10 d's @ 2" O.C.	10 d's @ 12" O.C.	870	2 ROWS STAGGED @ 3" O.C. (**) @ 6" O.C.	@ 6" O.C. (U.N.O.)	5/8" ø x 12" @ 16" O.C. W/ 3 x 6 SILL
15	3/8" APA RATED	8 d's @ 3" O.C.	8 d's @ 12" O.C.	960	SEE SHEAR TRANSFER DETAIL @ 6" O.C.	SEE SHEAR TRANSFER DETAIL	5/8" ø x 12" @ 16" O.C. W/ 3 x 6 SILL
16	15/32" APA RATED	10 d's @ 3" O.C.	10 d's @ 12" O.C.	1200	SEE SHEAR TRANSFER DETAIL @ 4" O.C.	SEE SHEAR TRANSFER DETAIL	5/8" ø x 12" @ 12" O.C. W/ 3 x 6 SILL
17	15/32" APA RATED	10 d's @ 2" O.C.	10 d's @ 12" O.C.	1740	N / A @ 3" O.C.	SEE SHEAR TRANSFER DETAIL	5/8" ø x 12" @ 8" O.C. W/ 3 x 6 SILL

(*) PROVIDE 3" NOMINAL OR WIDER FRAMING AT ADJOINING PANEL EDGES WITH NAILS STAGGERED.

(**) PROVIDE SHEAR TRANSFER DETAIL, USE MIN. 3 1/2" WIDE FRAMING MEMBERS TO RECEIVE SILL PLATE NAILING.

USE A35 @ 6" O.C. ON SIMPSON STRONG WALL & HARDY PANEL (U.N.O.)

MIN. 3 1/2" RIM OR BLOCKING IS REQUIRED TO RECEIVE SDS SCREWS. PLACE SCREWS AT CENTER / STAGGERED BY 1/2".

REVISIONS	DATE
1st PLAN CHECK	9/29/23
2nd PLAN CHECK	6/11/25

BASIL AMMARI P.E.
202 AMBLING DR.
BREA, CA 92821
TEL: 714-332-0087

PROPOSED ADDITION FOR:
YURI SALMERON
5866 PANAMA DR.
BUENA PARK, CA 90620

FRAMING PLAN



BASIL AMMARI

DRAWN BY DR
CONSULTANT / DESIGNER SIGNATURE
DATE 6/11/2025
SCALE 1/4" = 1'-0"
JOB NO.
SHEET S2


1. 2 x CEILING JOIST PER PLAN. 2. 2 x 4 @ 48" OC. 3. 2 x 8 RIDGE BOARD. 4. ST22 @ 32" OC. 5. 2 x ROOF RAFTERS PER PLAN. 6. (5) 16d's @ LAPPED RAFTERS/ CEILING JOIST. 7. H2.5. 8. ROOF RAFTERS HANGERS @ EACH ROOF RAFTERS. 9. 2 x 4 KICKERS @ 32" OC 45 DEGREES. 10. (4) 16d @ EACH CONNECTION TO ROOF RAFTERS & CEILING JOISTS. 2 CONNECTION DETAIL17	1. EXISTING FOOTINGS PER PLAN. 2. NEW FOOTINGS PER PLAN. 3. MIN. (4) #4 DOWELS @ NEW FOOTING TO EXISTING FOOTINGS. MIN. 6" INTO EXISTING FOOTINGS AND 24" INTO NEW FOOTINGS. USE SIMPSON SET-EPOXY ICC-ESR 2508. *SPECIAL INSPECTION IS REQUIRED. 1 CONNECTION DETAIL13	MIN. 2X CONT. BOARD W/ (3)16d's TO EACH ROOF FRAMING ELEMENT. CAULF. FRM'G. @ RIDGE CAULF. FRM'G. (PLAN VIEW) 7. REMOVE ALL EXISTING ROOFING AT NEW CALIFORNIA CONNECTION. 9 CONNECTION DETAIL5	1- CEILING/FLUSH BEAM PER PLAN. 2- KING POST PER PLAN. 3- ST22 EACH SIDE OF KING POST TO BEAM. 5 SHEAR TRANSFER1							
	1. 4X4 POST, U.N.O. SEE PLAN 2. STRAP, SEE TABLE 3. EMBEDMENT IS FROM COLD JOINT AT NON-MONO POUR FOUNDATION SYSTEMS. 4. EXISTING FOOTINGS. SPECIAL INSPECTION IS REQUIRED DURING ALL INSTALLATION MIN. CONC. STRENGTH $f_c = 2500$ psi ADEQUATE SIZE WASHER REQ'D. WHEN ANCHOR BOLT SIZE IS SMALLER THAN HOLE IN HOLDOWN. CONTRACTOR SHALL SPECIFY OVERALL LENGTH OF ANCHOR. * USE SIMPSON SET EPOXY ICC-ESR 2508 OR EQUIVALENT <table><tr><th>HOLDOWNS</th><th>EMBEDMENT</th></tr><tr><td>HTT5</td><td>10"</td></tr><tr><td>HDU8</td><td>12"</td></tr></table> 18 FIX FOR MISSING HOLDOWN14	HOLDOWNS	EMBEDMENT	HTT5	10"	HDU8	12"	2 x BLOCKING FLOOR JOISTS SUBFLOOR SHEATHING DROP BEAM PER PLAN LTP4 @ 48" OC ST22 IF BEAM BREAKS ON POST ST22 OR HTS12 EA SIDE @ BEAM TO POST 6 x 6 KING POST ABA66Z COLUMN BASE W/ 5/8" DIA x 12" ANCHOR BOLT CONCRETE PAD 10 CONNECTION DETAIL10	1- NATURAL GRADE OR COMPACTED FILL. 2- EXISTING FLOOR JOIST PER PLAN. 3- EXISTING FLOOR SHEATHING. 4- EXISTING 2X4 PRESSURE TREATED SILL PLATE WITH 5/8"x12" ANCHOR BOLTS PER PLN. 5- NEW FLOOR JOIST PER PLAN. 6- SHEAR WALL PER PLAN WITH E.N. TO SILL PLATES. 7- 2X4 SILL PLATE WITH 16d. @ 3" O.C. 8- 1-7/8" MIN. EDGE DISTANCE @ NEW & EXISTING ANCHOR BOLTS. 9- EXISTING CONCRETE FOOTING AS SHOWN. 10- NEW 2 X BLOCKING WITH SIMPSON LTP4 @ 8" OC. TO SILL PLATE. 11- NEW PLYWOOD FLOOR SHEATHING. 12- 2 X BLOCKING WITH 16d @ 4" OC. TO BLOCKING OVER STEM WALL. 13- E.N. 6 SHEAR TRANSFER6	1. TYPICAL ROOF RAFTER PER PLAN 2. 2X FASCIA BOARD 3. 2X FLAT BLOCKS W/ 16d's @ 4" O.C. TO PLATE BELOW 4. ROOF SHEATHING 5. EDGE NAILING 6. 2X FLAT OUTRIGGER @ 24" O.C. 7. (2) 16d's PER CONNECTION 8. SEE PLAN FOR SHEAR PANEL TYPE AND LOCATION 9. ALTERNATE COND. W/ ROOF RAFTER NEXT TO WALL W/16 d's @ 8" O.C. TO TOP PLATE 10. NOTCH RAFTER @ OUTRINGER 2 SHEAR TRANSFER2
HOLDOWNS	EMBEDMENT									
HTT5	10"									
HDU8	12"									
	1- EXISTING ROOF SHEATHING & 2 X RAFTERS PER PLAN. 2- NEW ROOF SHEATHING & 2 X RAFTERS PER PLAN. 3- EXISTING 2 X CEILING JOIST PER PLAN. 4- NEW PLYWOOD SHEAR WALL FULL HEIGHT AS SHOWN. 5- E.N. 6- 16d @ 6" OC. 7- 16d @ 4" OC. TO TOP PLATES. 8- A35'S @ 16" OC. 19 SHEAR TRANSFER15	* REFER TO EXTERIOR FOUND. DETAIL FOR ALL OTHER INFORMATION. 1- DROP BEAM PER PLAN. 2- SIMPSON HW TOP FLANGE HANGER 3- PRESSURE TREATED BLOCKING. 11 CONNECTION DETAIL11	9- CONCRETE FOOTING AS SHOWN. 10- #4 BAR AT 16" O.C. AS SHOWN. 11- 2#5 BAR AT BOT. AS SHOWN. 12- 2#5 AS SHOWN. 13- WEEP SCREED. 14- SIMPSON HOLDOWN PER PLAN. 15- SIMPSON SSTB HOLDOWN BOLT. 7 HOLDOWN DETAIL7	1. BEAM, SEE PLAN. 2. SIMPSON ST6224 EACH SIDE OF BEAM TO POST FOR 6X AND 8X BEAM'S; ST22 FOR 4X BEAM'S. 3. POST, SEE U.N.O. ON PLANS. 4. ALT. TO STRAPS USE 2X KING STUD EACH SIDE OF BEAM TO POST & NAIL W/ 16d's @ 16" O.C. TO POST & MIN. (3) 16d's TO BEAM. NOTE: — ADD SHIMS AS REQUIRED SIDE VIEW END VIEW 3 POST & BEAM CONNECTION3						
	1- EXISTING STUD WALL AT GARAGE. 2- NEW PLYWOOD SHEAR WALL PER PLAN. 3- EXISTING SLAB & FOOTINGS. 4- NEW PLYWOOD FLOOR SHEATHING & 2 X FLOOR JOIST PER PLAN. 5- E.N. 6- SIMPSON H2.5 @ 32" OC. 7- 2 X FLOOR JOIST WITH 16d @ 4" OC TO BLKG. 8- 2 X BLOCKING. 20 SHEAR TRANSFER16	1- NATURAL GRADE OR COMPACTED FILL. 2- FLOOR JOIST PER PLAN. 3- FLOOR SHEATHING. 4- 2X4 PRESSURE TREATED SILL PLATE WITH 5/8"x12" ANCHOR BOLTS PER PLN. 5- 2X. RIM JOIST. 6- SHEAR WALL PER PLAN WITH E.N. TO SILL PLATES. 7- 2X4 SILL PLATE WITH 16d. @ 6" O.C. 8- 1-7/8" MIN. EDGE DISTANCE @ ANCHOR BOLT. 9- CONCRETE FOOTING AS SHOWN. 10- #4 BAR AT 16" O.C. AS SHOWN. 11- 2#5 BAR AT BOT. AS SHOWN. 12- 2#5 AS SHOWN. 13- WEEP SCREED. 12 SHEAR TRANSFER12	1- ROOF RAFTER PER PLAN. 2- RIDGE BEAM PER PLAN 3- ROOF RAFTER HANGERS. 4- ROOF SHEATHING. 5- 2X. BLOCKING. 6- E.N. 7- ST22 CENTERED @ 48" O.C. 8- OVERLAP ROOF RAFTERS AND NAIL TOGETHER W/ 4-16d's. 8 CONNECTION DETAIL8	48" MINIMUM PLATE SPLICE W/ (18) 16d NAILS @ EA. PLATE SPLICE U.N.O. (ALT: ST6236 AT TOP OF PLATES) U.N.O. ON PLANS STANDARD PLATE SPLICE CONDITION STUD WALL TOP PLATE ST6236 U.N.O. ON PLANS PLATE SPLICE @ SLOPING CONDITION 4 PLATE SPLICE4						

REVISIONS	DATE

BASIL AMMARI P.E.
202 AMBLING DR.
BREA, CA 92821
TEL: 714-332-0087

PROPOSED ROOM ADDITION FOR:
YURI SALMERON
5866 PANAMA DR.
BUENA PARK, CA 90620

DETAILS

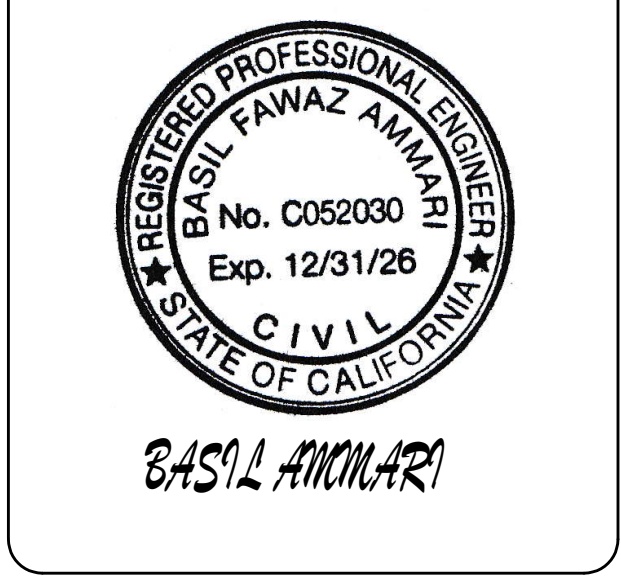

DRAWN BY D.R.
CONSULTANT / DESIGNER SIGNATURE
DATE 12/20/2024
SCALE NTS
JOB NO.
SHEET
SD-2



PRESCRIPTIVE ADDITIONS 1000 FT2 OR LESS

CF1R-ADD-01-E

(Page 1 of 7)

CERTIFICATE OF COMPLIANCE

Project Name:	Yuri Residence	Enforcement Agency:	Buena Park, City of
Dwelling Address:	5866 Panama Dr.	Permit Number:	
City and Zip Code	Buena Park, 90620	Permit Application Date:	2024-12-12

A. General Information				
01	Project Name	Yuri Residence	02	Date Prepared
03	Project Location	5866 Panama Dr.	04	Building Front Orientation (deg)
05	CA City	Buena Park	06	Number of Dwelling Units with Additions
07	Zip Code	90620	08	Fuel Type
09	Climate Zone	8	10	Total Conditioned Floor Area (ft ²) (Addition)
11	Building Type	Single family	12	Slab Area (ft ²)
13	Project Scope	Addition 300 ft ² to 400 ft ² Space cooling system Fenestration Space heating system Kitchen Remodel	14	Fenestration Exceptions
				NA (do not allow other entries)

Registration Number: 424-D010312846A-000-000-0000000-0000
NOTICE: This document has been generated by California Home Energy Efficiency Rating Services (CHEERS) using information uploaded by third parties not affiliated with or related to CHEERS. Therefore, CHEERS is not responsible for, and cannot guarantee, the accuracy or completeness of the information contained in this document.
CA Building Energy Efficiency Standards - 2022 Residential Compliance

Registration Date/Time: 2024-12-19 14:34:27
Report Version: 2022.0.000
Schema Version: rev 20220101

HERS Provider: CHEERS
Report Generated: 2024-12-19 14:34:58



PRESCRIPTIVE ADDITIONS 1000 FT2 OR LESS

CF1R-ADD-01-E

(Page 3 of 7)

D. Building Insulation Details - Mass Walls (Section 150.1(c)1Bii)												
This section does not apply to this project.												
E. Slab On Grade/Concrete Raised Floor Insulation (Table 150.1-A)												
This section does not apply to this project.												
F. Radiant Barrier (Section 150.1(c).2)												
01						02						
Radiant Barrier installed below the roof deck and on all gable end walls						Comments						
Yes						plywood roof sheathing with Radiant Barrier at new addition areas.						
A radiant barrier is required (for Climate Zones 2-15)												
• Radiant barriers shall meet specific eligibility and installation criteria to receive energy credit for compliance with the Building Energy Efficiency Standards for low-rise residential buildings. Refer to Reference Appendices, Residential Appendix RA4.2.1. • The emittance of the radiant barrier shall be less than or equal to 0.05 as tested in accordance with American Society for Testing and Materials (ASTM) C1371 or ASTM E408. • For Prescriptive Compliance the attic shall be ventilated to provide a minimum free ventilation area of not less than 1 square foot (ft²) of vent area for each 300 square feet ft² of attic floor area with a minimum of 40 percent to no more than 50 percent upper vents. Ridge vents or gable end vents are recommended to achieve the best performance. The material should be cut to allow for full airflow to the venting.												
G. Roofing Products (Cool Roof) (Section 150.1(c).11)												
01	02	03	04	05	06	07	08	09	10	11	12	13
Tag/ID	Exception	Roof Pitch	Method of Compliance	Product Type	CRRC Product ID Number	Proposed				Required		
						Initial Solar Reflectance	Aged Solar Reflectance	Thermal Emittance	SRI (optional)	Aged Solar Reflectance	Thermal Emittance	SRI (optional)
						Maximum Calculated based on Allowed %	Maximum Calculated Allowed ft ²	Maximum Calculated based on Allowed %	Maximum Calculated Allowed ft ²	Maximum Allowed U-factor (Windows)	Maximum Allowed U-factor (Skylights)	Maximum Allowed SHGC (Windows)
Asphalt Roofing.	No exceptions	Roof pitch is >= 2 :12	Aged solar reflectance and thermal emittance	Asphalt shingles	n/a	n/a	0.1	0.87	n/a	n/a	n/a	n/a

Registration Number: 424-D010312846A-000-000-0000000-0000
NOTICE: This document has been generated by California Home Energy Efficiency Rating Services (CHEERS) using information uploaded by third parties not affiliated with or related to CHEERS. Therefore, CHEERS is not responsible for, and cannot guarantee, the accuracy or completeness of the information contained in this document.
CA Building Energy Efficiency Standards - 2022 Residential Compliance

Registration Date/Time: 2024-12-19 14:34:27
Report Version: 2022.0.000
Schema Version: rev 20220101

HERS Provider: CHEERS
Report Generated: 2024-12-19 14:34:58



PRESCRIPTIVE ADDITIONS 1000 FT2 OR LESS

CF1R-ADD-01-E

(Page 2 of 7)

B. Building Insulation Details - Framed Walls/ Framed Floors (Section 150.2(a))											
01	02	03	04	05	06		07	08	09	10	11
Tag/ID	Assembly Type	Frame Type	Frame Depth (inches)	Frame Spacing (inches)	Proposed					Required	Comments
					Cavity R-value	Continuous Insulation R-value	U-Factor	Appendix JA4 Reference		U-Factor from Table 150.2-A	
								Table	Cell		
North exterior wall, addition	Wall	Wood	2x4	@ 16 in. O. C.	15	0	0.094	4.3.1	4A	0.094	
South interior wall between addition and garage.	Wall	Wood	2x4	@ 16 in. O. C.	15	0	0.094	4.3.1	4A	0.094	
East exterior wall, addition	Wall	Wood	2x4	@ 16 in. O. C.	15	0	0.094	4.3.1	4A	0.094	
West exterior wall, addition	Wall	Wood	2x4	@ 16 in. O. C.	15	0	0.094	4.3.1	4A	0.094	
Roof	Roof	Wood	2x12	@ 16 in. O. C.	38	0	0.026	4.2.1	9A	0.026	
Floor	Floor	Wood	2x6	@ 16 in. O. C.	19	0	0.037	4.4.1	4A	0.037	
Notes:											
- Where insulation is installed above the roofing membrane, or above the layer used to seal the roof from water penetration, the insulation shall have a maximum water absorption of 0.3 percent by volume when tested according to American Society for Testing and Materials (ASTM) Standard C272. - Extensions of existing wood-framed walls may retain the dimensions of the existing walls and shall install cavity insulation of R-15 in a 2x4 framing and R-21 in a 2x6 framing.											
C. Building Insulation Details - Non-framed (Section 150.1(c)1)											
This section does not apply to this project.											

Registration Number: 424-D010312846A-000-000-0000000-0000
NOTICE: This document has been generated by California Home Energy Efficiency Rating Services (CHEERS) using information uploaded by third parties not affiliated with or related to CHEERS. Therefore, CHEERS is not responsible for, and cannot guarantee, the accuracy or completeness of the information contained in this document.
CA Building Energy Efficiency Standards - 2022 Residential Compliance

Registration Date/Time: 2024-12-19 14:34:27
Report Version: 2022.0.000
Schema Version: rev 20220101

HERS Provider: CHEERS
Report Generated: 2024-12-19 14:34:58



PRESCRIPTIVE ADDITIONS 1000 FT2 OR LESS

CF1R-ADD-01-E

(Page 4 of 7)

G. Roofing Products (Cool Roof) (Section 150.1(c).11)												
01	02	03	04	05	06	07	08	09	10	11	12	13
Tag/ID	Exception	Roof Pitch	Method of Compliance	Product Type	CRRC Product ID Number	Proposed				Required		
						Initial Solar Reflectance	Aged Solar Reflectance	Thermal Emittance	SRI (optional)	Aged Solar Reflectance	Thermal Emittance	SRI (optional)
Notes: - Exception 1 Any roof area covered by building integrated photovoltaic (PV) panels and solar thermal panels are exempt from the above Cool Roof requirements - Exception 2: Roof construction with a weight of 25 pounds per square foot (lb/ft²) are also exempt. - Liquid field applied coatings must comply with installation criteria from Section 110.8(i)4												
H. Fenestration/Glazing Allowed Areas and Efficiencies (Section 150.2(a)1)												
01	02	03	04	05	06	07	08	09	10			
Addition Type ft ²	Maximum Allowed Fenestration Area For All Orientations ft ²		Maximum Allowed West-Facing Fenestration Area Only ft ²		Maximum Allowed U-factor (Windows)	Maximum Allowed U-factor (Skylights)	Maximum Allowed SHGC (Windows)			Comments		
	The Greater		The Greater									
	Maximum Calculated based on Allowed %	Maximum Calculated Allowed ft ²	Maximum Calculated based on Allowed %	Maximum Calculated Allowed ft ²								
Addition 300 ft ² to 400 ft ²	98.4	75	n/a	60	0.3	0.3	0.23	0.23				

Registration Number: 424-D010312846A-000-000-0000000-0000
NOTICE: This document has been generated by California Home Energy Efficiency Rating Services (CHEERS) using information uploaded by third parties not affiliated with or related to CHEERS. Therefore, CHEERS is not responsible for, and cannot guarantee, the accuracy or completeness of the information contained in this document.
CA Building Energy Efficiency Standards - 2022 Residential Compliance

Registration Date/Time: 2024-12-19 14:34:27
Report Version: 2022.0.000
Schema Version: rev 20220101

HERS Provider: CHEERS
Report Generated: 2024-12-19 14:34:58

YURI SALMERON RESIDENCE.
5866 PANAMA DR. BUENA PARK, CA. 90620



PREScriptive ADDITIONS 1000 FT2 OR LESS

CF1R-ADD-01-E
(Page 5 of 7)

I. Fenestration Proposed Areas and Efficiencies Note: If meeting Exception 1 to 150.1(c)(3A), installing less than or equal to 3 square feet (ft²) glass in door, it is assumed to meet the minimum required U-factor (0.30) and SHGC (0.23). If meeting Exception 1 to 150.1(c)(3A), installing less than or equal to 3 square feet (ft²) tubular skylight, it is assumed to meet the minimum required U-factor (0.55) & SHGC (0.30). Doors with greater than or equal to 25 percent glazing area are considered glazed doors and are treated as fenestration products.													
01	02	03	04	05	06	07	08	09	10	11	12	13	14
Tag/ID	Fenestration Type	Frame Type	Dynamic Glazing	Orientation N, S, W, E	Number of Panes	Proposed Fenestration Area ft ²	Proposed West Facing Fenestration Area ft ²	Proposed U-factor	Proposed SHGC Source	Proposed SHGC	Proposed SHGC Source	Exterior Shading Device	Combined SHGC from CF1R-ENV-03
North window/door	Operable window	Non-metal	None	North	Double pane	33.33	n/a	0.30	NFRC	0.23	n/a	None	n/a
East window	Operable window	Non-metal	None	East	Double pane	9	n/a	0.30	NFRC	0.23	NFRC	None	n/a
West windows	Operable window	Non-metal	None	West	Double pane	24		0.30	NFRC	0.23	NFRC	None	n/a
15	Total Proposed Fenestration Area											66.33	
16	Maximum Allowed Fenestration Area											98.4	
17	Compliance Statement		Design complies with the total allowed fenestration area										
18	Total Proposed West-Facing Fenestration Area											24	
19	Maximum Allowed West Facing Fenestration Area											60	
20	Compliance Statement		Design complies with the total allowed west-facing fenestration area										
21	Proposed Fenestration U-factor (Windows)											0.3	
22	Required Fenestration U-factor (Windows)											0.3	
23	Compliance Statement		Design complies with the total allowed fenestration area										
24	Proposed Fenestration SHGC (Windows)											0.23	
25	Required Fenestration SHGC (Windows)											0.23	
26	Compliance Statement		Design complies with the maximum allowed fenestration SHGC										
27	Proposed Fenestration U-factor (Skylights)											n/a	
28	Required Fenestration U-factor (Skylights)											0.3	
29	Compliance Statement											n/a	

Registration Number: 424-D010312846A-000-000-0000000-0000
NOTICE: This document has been generated by California Home Energy Efficiency Rating Services (CHEERS) using information uploaded by third parties not affiliated with or related to CHEERS. Therefore, CHEERS is not responsible for, and cannot guarantee, the accuracy or completeness of the information contained in this document.
CA Building Energy Efficiency Standards - 2022 Residential Compliance

Registration Date/Time: 2024-12-19 14:34:27
Report Version: 2022.0.000
Schema Version: rev 20220101

HERS Provider: CHEERS
Report Generated: 2024-12-19 14:34:58



PREScriptive ADDITIONS 1000 FT2 OR LESS

CF1R-ADD-01-E
(Page 6 of 7)

30	Proposed Fenestration SHGC (Skylights)		n/a
31			0.23
32	Compliance Statement	n/a	
J. Opaque Swinging Doors to Exterior (Section 150.1(c)5)			
This section does not apply to this project.			
K. Space Conditioning (SC) Systems - Heating/ Cooling (Section 150.2(b) or (Section 150.1(c)7)			
01		02	03
Dwelling Unit Name		Dwelling Unit Total CFA = Sum of Existing + Addition (ft ²)	Comments
Existing FAU and AC		1308	
L. Water Heating Systems (Section 150.2(a)1D)			
This section does not apply to this project.			
M. Indoor Air Quality (IAQ) Fan Information			
This section does not apply to this project.			

Registration Number: 424-D010312846A-000-000-0000000-0000
NOTICE: This document has been generated by California Home Energy Efficiency Rating Services (CHEERS) using information uploaded by third parties not affiliated with or related to CHEERS. Therefore, CHEERS is not responsible for, and cannot guarantee, the accuracy or completeness of the information contained in this document.
CA Building Energy Efficiency Standards - 2022 Residential Compliance

Registration Date/Time: 2024-12-19 14:34:27
Report Version: 2022.0.000
Schema Version: rev 20220101

HERS Provider: CHEERS
Report Generated: 2024-12-19 14:34:58



PREScriptive ADDITIONS 1000 FT2 OR LESS

CF1R-ADD-01-E
(Page 7 of 7)

DOCUMENTATION AUTHOR'S DECLARATION STATEMENT	
I certify that this Certificate of Compliance documentation is accurate and complete.	
Documentation Author Name: Basil Ammari	Documentation Author Signature: <i>Basil Ammari</i>
Company: Petra Enterprise Inc	Signature Date: 2024-12-19
Address: 202 Ambling Dr	CEA/ HERS Certification Identification (if applicable):
City/State/Zip: Brea CA 92821	Phone: 949-2797410
RESPONSIBLE PERSON'S DECLARATION STATEMENT	
I certify the following under penalty of perjury, under the laws of the State of California:	
1. The information provided on this Certificate of Compliance is true and correct. 2. I am eligible under Division 3 of the Business and Professions Code to accept responsibility for the building design or system design identified on this Certificate of Compliance (responsible designer). 3. The energy features and performance specifications, materials, components, and manufactured devices for the building design or system design identified on this Certificate of Compliance conform to the requirements of Title 24, Part 1 and Part 6 of the California Code of Regulations. 4. The building design features or system design features identified on this Certificate of Compliance are consistent with the information provided on other applicable compliance documents, worksheets, calculations, plans and specifications submitted to the enforcement agency for approval with this building permit application. 5. I understand that a registered copy of this Certificate of Compliance shall be made available with the building permit(s) issued for the building, and made available to the enforcement agency for all applicable inspections, and I will take the necessary steps to accomplish this requirement. 6. I understand that a registered copy of this Certificate of Compliance is required to be included with the documentation the builder provides to the building owner at occupancy, and I will take the necessary steps to accomplish these requirements.	
Responsible Designer Name: Basil Ammari	Responsible Designer Signature: <i>Basil Ammari</i>
Company: Petra Enterprise Inc	Date Signed: 2024-12-19
Address: 202 Ambling Dr	License:
City/State/Zip: Brea CA 92821	Phone: 949-2797410

Registration Number: 424-D010312846A-000-000-0000000-0000
NOTICE: This document has been generated by California Home Energy Efficiency Rating Services (CHEERS) using information uploaded by third parties not affiliated with or related to CHEERS. Therefore, CHEERS is not responsible for, and cannot guarantee, the accuracy or completeness of the information contained in this document.
CA Building Energy Efficiency Standards - 2022 Residential Compliance

Registration Date/Time: 2024-12-19 14:34:27
Report Version: 2022.0.000
Schema Version: rev 20220101

HERS Provider: CHEERS
Report Generated: 2024-12-19 14:34:58

YURI SALMERON RESIDENCE.
5866 PANAMA DR. BUENA PARK, CA. 90620

2022 CALIFORNIA GREEN BUILDING STANDARDS CODE

RESIDENTIAL MANDATORY MEASURES, SHEET 1 (January 2023)

[illegible]

DISCLAIMER: THIS DOCUMENT IS PROVIDED AND INTENDED TO BE USED AS A MEANS TO INDICATE AREAS OF COMPLIANCE WITH THE CALIFORNIA GREEN BUILDING STANDARDS (CALGREEN) CODE. DUE TO THE VARIABLES BETWEEN BUILDING DEPARTMENT JURISDICTIONS, THIS CHECKLIST IS TO BE USED ON AN INDIVIDUAL PROJECT BASIS AND MAY BE MODIFIED BY THE END USER TO MEET THOSE INDIVIDUAL NEEDS. THE END USER ASSUMES ALL RESPONSIBILITY ASSOCIATED WITH THE USE OF THIS DOCUMENT, INCLUDING VERIFICATION WITH THE FULL CODE.

REVISIONS	DATE

BASIL AMMARI P.E.
202 AMBLING DR.
BREA, CA 92821
TEL: 714-332-0087

PROPOSED ROOM ADDITION FOR:
YURI SALMERON
5866 PANAMA DR.
BUENA PARK, CA 90620



BASIL ANMAR

DRAWN BY D. R.
CONSULTANT / DESIGNER SIGNATURE
DATE 12/20/2024
SCALE NTS
JOB NO.
SHEET GC1

2022 CALIFORNIA GREEN BUILDING STANDARDS CODE

RESIDENTIAL MANDATORY MEASURES, SHEET 2 (January 2023)

Y	NA	RESPON- PARTY																																																																			
			MAXIMUM INCREMENTAL REACTIVITY (MIR). The maximum change in weight of ozone formed by adding a compound to the "Basic Reactive Organic Gas (ROG) Mixture" per weight of compound added, expressed to hundredths of a gram (g O₃/g ROG). Note: MIR values for individual compounds and hydrocarbon solvents are specified in CCR, Title 17, Sections 94700 and 94701. MOISTURE CONTENT. The weight of the water in wood expressed in percentage of the weight of the oven-dry wood. PRODUCT-WEIGHTED MIR (PWMIR). The sum of all weighted-MIR for all ingredients in a product subject to this article. The PWMIR is the total product reactivity expressed to hundredths of a gram of ozone formed per gram of product (excluding container and packaging). Note: PWMIR is calculated according to equations found in CCR, Title 17, Section 94521 (a). REACTIVE ORGANIC COMPOUND (ROC). Any compound that has the potential, once emitted, to contribute to ozone formation in the troposphere. VOC. A volatile organic compound (VOC) broadly defined as a chemical compound based on carbon chains or rings with vapor pressures greater than 0.1 millimeters of mercury at room temperature. These compounds typically contain hydrogen and may contain oxygen, nitrogen and other elements. See CCR Title 17, Section 94508(a). 4.503 FIREPLACES 4.503.1 GENERAL. Any installed gas fireplace shall be a direct-vent sealed-combustion type. Any installed woodstove or pellet stove shall comply with U.S. EPA New Source Performance Standards (NSPS) emission limits as applicable, and shall have a permanent label indicating they are certified to meet the emission limits. Woodstoves, pellet stoves and fireplaces shall also comply with applicable local ordinances. 4.504 POLLUTANT CONTROL 4.504.1 COVERING OF DUCT OPENINGS & PROTECTION OF MECHANICAL EQUIPMENT DURING CONSTRUCTION. At the time of rough installation, during storage on the construction site and until final startup of the heating, cooling and ventilating equipment, all duct and other related air distribution component openings shall be covered with tape, plastic, sheet metal or other methods acceptable to the enforcing agency to reduce the amount of water, dust or debris which may enter the system. 4.504.2 FINISH MATERIAL POLLUTANT CONTROL. Finish materials shall comply with this section. 4.504.2.1 Adhesives, Sealants and Caulks. Adhesives, sealant and caulks used on the project shall meet the requirements of the following standards unless more stringent local or regional air pollution or air quality management district rules apply: 1. Adhesives, adhesive bonding primers, adhesive primers, sealants, sealant primers and caulks shall comply with local or regional air pollution control or air quality management district rules where applicable or SCAGMD Rule 1168 VOC limits, as shown in Table 4.504.1 or 4.504.2, as applicable. Such products also shall comply with the Rule 1168 prohibition on the use of certain toxic compounds (chloroform, ethylene dichloride, methylene chloride, perchloroethylene and trichloroethylene), except for aerosol products, as specified in Subsection 2 below. 2. Aerosol adhesives, and smaller unit sizes of adhesives, and sealant or caulking compounds (in units of product, less packaging, which do not weigh more than 1 pound and do not consist of more than 16 fluid ounces) shall comply with statewide VOC standards and other requirements, including prohibitions on use of certain toxic compounds, of <i>California Code of Regulations</i>, Title 17, commencing with section 94507. 4.504.2.2 Paints and Coatings. Architectural paints and coatings shall comply with VOC limits in Table 1 of the ARB Architectural Suggested Control Measure, as shown in Table 4.504.3, unless more stringent local limits apply. The VOC content limit for coatings that do not meet the definitions for the specialty coatings categories listed in Table 4.504.3 shall be determined by classifying the coating as a Flat or Nonflat-High Gloss coating, based on its gloss, as defined in subsections 4.21, 4.36, and 4.37 of the 2007 California Air Resources Board, Suggested Control Measure, and the corresponding Flat, Nonflat or Nonflat-High Gloss VOC limit in Table 4.504.3 shall apply. 4.504.2.3 Aerosol Paints and Coatings. Aerosol paints and coatings shall meet the Product-weighted MIR Limits for ROC in Section 94522(a)(2) and other requirements, including prohibitions on use of certain toxic compounds and ozone depleting substances, in Sections 94522(a)(1) and (f)(1) of <i>California Code of Regulations</i>, Title 17, commencing with Section 94520; and in areas under the jurisdiction of the Bay Area Air Quality Management District additionally comply with the percent VOC by weight of product limits of Regulation 8, Rule 49. 4.504.2.4 Verification. Verification of compliance with this section shall be provided at the request of the enforcing agency. Documentation may include, but is not limited to, the following: 1. Manufacturer's product specification. 2. Field verification of on-site product containers.																																																																		
			<table><tr><th colspan="2">TABLE 4.504.1 - ADHESIVE VOC LIMIT^{1,2}</th></tr><tr><th colspan="2">(Less Water and Less Exempt Compounds in Grams per Liter)</th></tr><tr><th>ARCHITECTURAL APPLICATIONS</th><th>VOC LIMIT</th></tr><tr><td>INDOOR CARPET ADHESIVES</td><td>50</td></tr><tr><td>CARPET PAD ADHESIVES</td><td>50</td></tr><tr><td>OUTDOOR CARPET ADHESIVES</td><td>150</td></tr><tr><td>WOOD FLOORING ADHESIVES</td><td>100</td></tr><tr><td>RUBBER FLOOR ADHESIVES</td><td>60</td></tr><tr><td>SUBFLOOR ADHESIVES</td><td>50</td></tr><tr><td>CERAMIC TILE ADHESIVES</td><td>65</td></tr><tr><td>VCT & ASPHALT TILE ADHESIVES</td><td>50</td></tr><tr><td>DRYWALL & PANEL ADHESIVES</td><td>50</td></tr><tr><td>COVE BASE ADHESIVES</td><td>50</td></tr><tr><td>MULTIPURPOSE CONSTRUCTION ADHESIVE</td><td>70</td></tr><tr><td>STRUCTURAL GLAZING ADHESIVES</td><td>100</td></tr><tr><td>SINGLE-PLY ROOF MEMBRANE ADHESIVES</td><td>250</td></tr><tr><td>OTHER ADHESIVES NOT LISTED</td><td>50</td></tr><tr><td colspan="2">SPECIALTY APPLICATIONS</td></tr><tr><td>PVC WELDING</td><td>510</td></tr><tr><td>CPVC WELDING</td><td>490</td></tr><tr><td>ABS WELDING</td><td>325</td></tr><tr><td>PLASTIC CEMENT WELDING</td><td>250</td></tr><tr><td>ADHESIVE PRIMER FOR PLASTIC</td><td>550</td></tr><tr><td>CONTACT ADHESIVE</td><td>80</td></tr><tr><td>SPECIAL PURPOSE CONTACT ADHESIVE</td><td>250</td></tr><tr><td>STRUCTURAL WOOD MEMBER ADHESIVE</td><td>140</td></tr><tr><td>TOP & TRIM ADHESIVE</td><td>250</td></tr><tr><td colspan="2">SUBSTRATE SPECIFIC APPLICATIONS</td></tr><tr><td>METAL TO METAL</td><td>30</td></tr><tr><td>PLASTIC FOAMS</td><td>50</td></tr><tr><td>POROUS MATERIAL (EXCEPT WOOD)</td><td>50</td></tr><tr><td>WOOD</td><td>50</td></tr><tr><td>FIBERGLASS</td><td>80</td></tr></table> 1. IF AN ADHESIVE IS USED TO BOND DISSIMILAR SUBSTRATES TOGETHER, THE ADHESIVE WITH THE HIGHEST VOC CONTENT SHALL BE ALLOWED. 2. FOR ADDITIONAL INFORMATION REGARDING METHODS TO MEASURE THE VOC CONTENT SPECIFIED IN THIS TABLE, SEE SOUTH COAST AIR QUALITY MANAGEMENT DISTRICT RULE 1168.	TABLE 4.504.1 - ADHESIVE VOC LIMIT ^{1,2}		(Less Water and Less Exempt Compounds in Grams per Liter)		ARCHITECTURAL APPLICATIONS	VOC LIMIT	INDOOR CARPET ADHESIVES	50	CARPET PAD ADHESIVES	50	OUTDOOR CARPET ADHESIVES	150	WOOD FLOORING ADHESIVES	100	RUBBER FLOOR ADHESIVES	60	SUBFLOOR ADHESIVES	50	CERAMIC TILE ADHESIVES	65	VCT & ASPHALT TILE ADHESIVES	50	DRYWALL & PANEL ADHESIVES	50	COVE BASE ADHESIVES	50	MULTIPURPOSE CONSTRUCTION ADHESIVE	70	STRUCTURAL GLAZING ADHESIVES	100	SINGLE-PLY ROOF MEMBRANE ADHESIVES	250	OTHER ADHESIVES NOT LISTED	50	SPECIALTY APPLICATIONS		PVC WELDING	510	CPVC WELDING	490	ABS WELDING	325	PLASTIC CEMENT WELDING	250	ADHESIVE PRIMER FOR PLASTIC	550	CONTACT ADHESIVE	80	SPECIAL PURPOSE CONTACT ADHESIVE	250	STRUCTURAL WOOD MEMBER ADHESIVE	140	TOP & TRIM ADHESIVE	250	SUBSTRATE SPECIFIC APPLICATIONS		METAL TO METAL	30	PLASTIC FOAMS	50	POROUS MATERIAL (EXCEPT WOOD)	50	WOOD	50	FIBERGLASS	80
TABLE 4.504.1 - ADHESIVE VOC LIMIT ^{1,2}																																																																					
(Less Water and Less Exempt Compounds in Grams per Liter)																																																																					
ARCHITECTURAL APPLICATIONS	VOC LIMIT																																																																				
INDOOR CARPET ADHESIVES	50																																																																				
CARPET PAD ADHESIVES	50																																																																				
OUTDOOR CARPET ADHESIVES	150																																																																				
WOOD FLOORING ADHESIVES	100																																																																				
RUBBER FLOOR ADHESIVES	60																																																																				
SUBFLOOR ADHESIVES	50																																																																				
CERAMIC TILE ADHESIVES	65																																																																				
VCT & ASPHALT TILE ADHESIVES	50																																																																				
DRYWALL & PANEL ADHESIVES	50																																																																				
COVE BASE ADHESIVES	50																																																																				
MULTIPURPOSE CONSTRUCTION ADHESIVE	70																																																																				
STRUCTURAL GLAZING ADHESIVES	100																																																																				
SINGLE-PLY ROOF MEMBRANE ADHESIVES	250																																																																				
OTHER ADHESIVES NOT LISTED	50																																																																				
SPECIALTY APPLICATIONS																																																																					
PVC WELDING	510																																																																				
CPVC WELDING	490																																																																				
ABS WELDING	325																																																																				
PLASTIC CEMENT WELDING	250																																																																				
ADHESIVE PRIMER FOR PLASTIC	550																																																																				
CONTACT ADHESIVE	80																																																																				
SPECIAL PURPOSE CONTACT ADHESIVE	250																																																																				
STRUCTURAL WOOD MEMBER ADHESIVE	140																																																																				
TOP & TRIM ADHESIVE	250																																																																				
SUBSTRATE SPECIFIC APPLICATIONS																																																																					
METAL TO METAL	30																																																																				
PLASTIC FOAMS	50																																																																				
POROUS MATERIAL (EXCEPT WOOD)	50																																																																				
WOOD	50																																																																				
FIBERGLASS	80																																																																				

Y	NA	RESPON. PARTY		Y	NA	RESPON. PARTY																																																																																														
<table><tr><td colspan="2">TABLE 4.504.2 - SEALANT VOC LIMIT</td></tr><tr><td colspan="2">(Less Water and Less Exempt Compounds in Grams per Liter)</td></tr><tr><td>SEALANTS</td><td>VOC LIMIT</td></tr><tr><td>ARCHITECTURAL</td><td>250</td></tr><tr><td>MARINE DECK</td><td>760</td></tr><tr><td>NONMEMBRANE ROOF</td><td>300</td></tr><tr><td>ROADWAY</td><td>250</td></tr><tr><td>SINGLE-PLY ROOF MEMBRANE</td><td>450</td></tr><tr><td>OTHER</td><td>420</td></tr><tr><td colspan="2">SEALANT PRIMERS</td></tr><tr><td>ARCHITECTURAL</td><td></td></tr><tr><td>NON-POROUS</td><td>250</td></tr><tr><td>POROUS</td><td>775</td></tr><tr><td>MODIFIED BITUMINOUS</td><td>500</td></tr><tr><td>MARINE DECK</td><td>760</td></tr><tr><td>OTHER</td><td>750</td></tr></table>							TABLE 4.504.2 - SEALANT VOC LIMIT		(Less Water and Less Exempt Compounds in Grams per Liter)		SEALANTS	VOC LIMIT	ARCHITECTURAL	250	MARINE DECK	760	NONMEMBRANE ROOF	300	ROADWAY	250	SINGLE-PLY ROOF MEMBRANE	450	OTHER	420	SEALANT PRIMERS		ARCHITECTURAL		NON-POROUS	250	POROUS	775	MODIFIED BITUMINOUS	500	MARINE DECK	760	OTHER	750																																																														
TABLE 4.504.2 - SEALANT VOC LIMIT																																																																																																				
(Less Water and Less Exempt Compounds in Grams per Liter)																																																																																																				
SEALANTS	VOC LIMIT																																																																																																			
ARCHITECTURAL	250																																																																																																			
MARINE DECK	760																																																																																																			
NONMEMBRANE ROOF	300																																																																																																			
ROADWAY	250																																																																																																			
SINGLE-PLY ROOF MEMBRANE	450																																																																																																			
OTHER	420																																																																																																			
SEALANT PRIMERS																																																																																																				
ARCHITECTURAL																																																																																																				
NON-POROUS	250																																																																																																			
POROUS	775																																																																																																			
MODIFIED BITUMINOUS	500																																																																																																			
MARINE DECK	760																																																																																																			
OTHER	750																																																																																																			
<table><tr><td colspan="2">TABLE 4.504.3 - VOC CONTENT LIMITS FOR ARCHITECTURAL COATINGS:¹</td></tr><tr><td colspan="2">GRAMS OF VOC PER LITER OF COATING, LESS WATER & LESS EXEMPT COMPOUNDS</td></tr><tr><td>COATING CATEGORY</td><td>VOC LIMIT</td></tr><tr><td>FLAT COATINGS</td><td>50</td></tr><tr><td>NON-FLAT COATINGS</td><td>100</td></tr><tr><td>NONFLAT-HIGH GLOSS COATINGS</td><td>150</td></tr><tr><td colspan="2">SPECIALTY COATINGS</td></tr><tr><td>ALUMINUM ROOF COATINGS</td><td>400</td></tr><tr><td>BASEMENT SPECIALTY COATINGS</td><td>400</td></tr><tr><td>BITUMINOUS ROOF COATINGS</td><td>50</td></tr><tr><td>BITUMINOUS ROOF PRIMERS</td><td>350</td></tr><tr><td>BOND BREAKERS</td><td>350</td></tr><tr><td>CONCRETE CURING COMPOUNDS</td><td>350</td></tr><tr><td>CONCRETE/MASONRY SEALERS</td><td>100</td></tr><tr><td>DRIVEWAY SEALERS</td><td>50</td></tr><tr><td>DRY FOG COATINGS</td><td>150</td></tr><tr><td>FAUX FINISHING COATINGS</td><td>350</td></tr><tr><td>FIRE RESISTIVE COATINGS</td><td>350</td></tr><tr><td>FLOOR COATINGS</td><td>100</td></tr><tr><td>FORM-RELEASE COMPOUNDS</td><td>250</td></tr><tr><td>GRAPHIC ARTS COATINGS (SIGN PAINTS)</td><td>500</td></tr><tr><td>HIGH TEMPERATURE COATINGS</td><td>420</td></tr><tr><td>INDUSTRIAL MAINTENANCE COATINGS</td><td>250</td></tr><tr><td>LOW SOLIDS COATINGS¹</td><td>120</td></tr><tr><td>MAGNESITE CEMENT COATINGS</td><td>450</td></tr><tr><td>MASTIC TEXTURE COATINGS</td><td>100</td></tr><tr><td>METALLIC PIGMENTED COATINGS</td><td>500</td></tr><tr><td>MULTICOLOR COATINGS</td><td>250</td></tr><tr><td>PRETREATMENT WASH PRIMERS</td><td>420</td></tr><tr><td>PRIMERS, SEALERS, & UNDERCOATERS</td><td>100</td></tr><tr><td>REACTIVE PENETRATING SEALERS</td><td>350</td></tr><tr><td>RECYCLED COATINGS</td><td>250</td></tr><tr><td>ROOF COATINGS</td><td>50</td></tr><tr><td>RUST PREVENTATIVE COATINGS</td><td>250</td></tr><tr><td>SHELLACS</td><td></td></tr><tr><td>CLEAR</td><td>730</td></tr><tr><td>OPAQUE</td><td>550</td></tr><tr><td>SPECIALTY PRIMERS, SEALERS & UNDERCOATERS</td><td>100</td></tr><tr><td>STAINS</td><td>250</td></tr><tr><td>STONE CONSOLIDANTS</td><td>450</td></tr><tr><td>SWIMMING POOL COATINGS</td><td>340</td></tr><tr><td>TRAFFIC MARKING COATINGS</td><td>100</td></tr><tr><td>TUB & TILE REFINISH COATINGS</td><td>420</td></tr><tr><td>WATERPROOFING MEMBRANES</td><td>250</td></tr><tr><td>WOOD COATINGS</td><td>275</td></tr><tr><td>WOOD PRESERVATIVES</td><td>350</td></tr><tr><td>ZINC-RICH PRIMERS</td><td>340</td></tr></table>							TABLE 4.504.3 - VOC CONTENT LIMITS FOR ARCHITECTURAL COATINGS: ¹		GRAMS OF VOC PER LITER OF COATING, LESS WATER & LESS EXEMPT COMPOUNDS		COATING CATEGORY	VOC LIMIT	FLAT COATINGS	50	NON-FLAT COATINGS	100	NONFLAT-HIGH GLOSS COATINGS	150	SPECIALTY COATINGS		ALUMINUM ROOF COATINGS	400	BASEMENT SPECIALTY COATINGS	400	BITUMINOUS ROOF COATINGS	50	BITUMINOUS ROOF PRIMERS	350	BOND BREAKERS	350	CONCRETE CURING COMPOUNDS	350	CONCRETE/MASONRY SEALERS	100	DRIVEWAY SEALERS	50	DRY FOG COATINGS	150	FAUX FINISHING COATINGS	350	FIRE RESISTIVE COATINGS	350	FLOOR COATINGS	100	FORM-RELEASE COMPOUNDS	250	GRAPHIC ARTS COATINGS (SIGN PAINTS)	500	HIGH TEMPERATURE COATINGS	420	INDUSTRIAL MAINTENANCE COATINGS	250	LOW SOLIDS COATINGS ¹	120	MAGNESITE CEMENT COATINGS	450	MASTIC TEXTURE COATINGS	100	METALLIC PIGMENTED COATINGS	500	MULTICOLOR COATINGS	250	PRETREATMENT WASH PRIMERS	420	PRIMERS, SEALERS, & UNDERCOATERS	100	REACTIVE PENETRATING SEALERS	350	RECYCLED COATINGS	250	ROOF COATINGS	50	RUST PREVENTATIVE COATINGS	250	SHELLACS		CLEAR	730	OPAQUE	550	SPECIALTY PRIMERS, SEALERS & UNDERCOATERS	100	STAINS	250	STONE CONSOLIDANTS	450	SWIMMING POOL COATINGS	340	TRAFFIC MARKING COATINGS	100	TUB & TILE REFINISH COATINGS	420	WATERPROOFING MEMBRANES	250	WOOD COATINGS	275	WOOD PRESERVATIVES	350	ZINC-RICH PRIMERS	340
TABLE 4.504.3 - VOC CONTENT LIMITS FOR ARCHITECTURAL COATINGS: ¹																																																																																																				
GRAMS OF VOC PER LITER OF COATING, LESS WATER & LESS EXEMPT COMPOUNDS																																																																																																				
COATING CATEGORY	VOC LIMIT																																																																																																			
FLAT COATINGS	50																																																																																																			
NON-FLAT COATINGS	100																																																																																																			
NONFLAT-HIGH GLOSS COATINGS	150																																																																																																			
SPECIALTY COATINGS																																																																																																				
ALUMINUM ROOF COATINGS	400																																																																																																			
BASEMENT SPECIALTY COATINGS	400																																																																																																			
BITUMINOUS ROOF COATINGS	50																																																																																																			
BITUMINOUS ROOF PRIMERS	350																																																																																																			
BOND BREAKERS	350																																																																																																			
CONCRETE CURING COMPOUNDS	350																																																																																																			
CONCRETE/MASONRY SEALERS	100																																																																																																			
DRIVEWAY SEALERS	50																																																																																																			
DRY FOG COATINGS	150																																																																																																			
FAUX FINISHING COATINGS	350																																																																																																			
FIRE RESISTIVE COATINGS	350																																																																																																			
FLOOR COATINGS	100																																																																																																			
FORM-RELEASE COMPOUNDS	250																																																																																																			
GRAPHIC ARTS COATINGS (SIGN PAINTS)	500																																																																																																			
HIGH TEMPERATURE COATINGS	420																																																																																																			
INDUSTRIAL MAINTENANCE COATINGS	250																																																																																																			
LOW SOLIDS COATINGS ¹	120																																																																																																			
MAGNESITE CEMENT COATINGS	450																																																																																																			
MASTIC TEXTURE COATINGS	100																																																																																																			
METALLIC PIGMENTED COATINGS	500																																																																																																			
MULTICOLOR COATINGS	250																																																																																																			
PRETREATMENT WASH PRIMERS	420																																																																																																			
PRIMERS, SEALERS, & UNDERCOATERS	100																																																																																																			
REACTIVE PENETRATING SEALERS	350																																																																																																			
RECYCLED COATINGS	250																																																																																																			
ROOF COATINGS	50																																																																																																			
RUST PREVENTATIVE COATINGS	250																																																																																																			
SHELLACS																																																																																																				
CLEAR	730																																																																																																			
OPAQUE	550																																																																																																			
SPECIALTY PRIMERS, SEALERS & UNDERCOATERS	100																																																																																																			
STAINS	250																																																																																																			
STONE CONSOLIDANTS	450																																																																																																			
SWIMMING POOL COATINGS	340																																																																																																			
TRAFFIC MARKING COATINGS	100																																																																																																			
TUB & TILE REFINISH COATINGS	420																																																																																																			
WATERPROOFING MEMBRANES	250																																																																																																			
WOOD COATINGS	275																																																																																																			
WOOD PRESERVATIVES	350																																																																																																			
ZINC-RICH PRIMERS	340																																																																																																			
<table><tr><td>1. GRAMS OF VOC PER LITER OF COATING, INCLUDING WATER & EXEMPT COMPOUNDS</td></tr><tr><td>2. THE SPECIFIED LIMITS REMAIN IN EFFECT UNLESS REVISED LIMITS ARE LISTED IN SUBSEQUENT COLUMNS IN THE TABLE.</td></tr><tr><td>3. VALUES IN THIS TABLE ARE DERIVED FROM THOSE SPECIFIED BY THE CALIFORNIA AIR RESOURCES BOARD, ARCHITECTURAL COATINGS SUGGESTED CONTROL MEASURE, FEB. 1, 2008. MORE INFORMATION IS AVAILABLE FROM THE AIR RESOURCES BOARD.</td></tr></table>							1. GRAMS OF VOC PER LITER OF COATING, INCLUDING WATER & EXEMPT COMPOUNDS	2. THE SPECIFIED LIMITS REMAIN IN EFFECT UNLESS REVISED LIMITS ARE LISTED IN SUBSEQUENT COLUMNS IN THE TABLE.	3. VALUES IN THIS TABLE ARE DERIVED FROM THOSE SPECIFIED BY THE CALIFORNIA AIR RESOURCES BOARD, ARCHITECTURAL COATINGS SUGGESTED CONTROL MEASURE, FEB. 1, 2008. MORE INFORMATION IS AVAILABLE FROM THE AIR RESOURCES BOARD.																																																																																											
1. GRAMS OF VOC PER LITER OF COATING, INCLUDING WATER & EXEMPT COMPOUNDS																																																																																																				
2. THE SPECIFIED LIMITS REMAIN IN EFFECT UNLESS REVISED LIMITS ARE LISTED IN SUBSEQUENT COLUMNS IN THE TABLE.																																																																																																				
3. VALUES IN THIS TABLE ARE DERIVED FROM THOSE SPECIFIED BY THE CALIFORNIA AIR RESOURCES BOARD, ARCHITECTURAL COATINGS SUGGESTED CONTROL MEASURE, FEB. 1, 2008. MORE INFORMATION IS AVAILABLE FROM THE AIR RESOURCES BOARD.																																																																																																				

CHAPTER 7

INSTALLER & SPECIAL INSPECTOR QUALIFICATIONS

02 QUALIFICATIONS

02.1 INSTALLER TRAINING.

HVAC system installers shall be trained and certified in the proper installation of HVAC systems including ducts and equipment by a nationally or regionally recognized training or certification program. Uncertified persons may perform HVAC installations when under the direct supervision and responsibility of a person trained and certified to install HVAC systems or contractor licensed to install HVAC systems. Examples of acceptable HVAC training and certification programs include but are not limited to the following.

1. State certified apprenticeship programs.
2. Public utility training programs.
3. Training programs sponsored by trade, labor or statewide energy consulting or verification organizations.
4. Programs sponsored by manufacturing organizations.
5. Other programs acceptable to the enforcing agency.

02.2 SPECIAL INSPECTION [HCD].

When required by the enforcing agency, the owner or the responsible entity acting as the owner's agent shall employ one or more special inspectors to provide inspection or verification of the installation of HVAC systems. Special inspectors shall demonstrate competence in the particular type of inspection or task to be performed. In addition to the satisfaction of the enforcing agency for the particular type of inspection or task to be performed. In addition to their certifications or qualifications acceptable to the enforcing agency, the following certifications or education may be considered by the enforcing agency when evaluating the qualifications of a special inspector:

1. Certification by a national or regional green building program or standard publisher.
2. Certification by a statewide energy consulting or verification organization, such as HERS raters, building performance contractors, and home energy auditors.
3. Successful completion of a third party apprentice training program in the appropriate trade.
4. Other programs acceptable to the enforcing agency.

Notes:

1. Special inspectors shall be independent entities with no financial interest in the materials or the project they are inspecting for compliance with this code.
2. HERS raters are special inspectors certified by the California Energy Commission (CEC) to rate homes in California according to the Home Energy Rating System (HERS).

[GSC] When required by the enforcing agency, the owner or the responsible entity acting as the owner's agent shall employ one or more special inspectors to provide inspection or other duties necessary to substantiate compliance with this code. Special inspectors shall demonstrate competence to the satisfaction of the enforcing agency for the particular type of inspection or task to be performed. In addition, the special inspector shall have a certification from a recognized state, national or international association, as determined by the local agency. The area of certification shall be closely related to the primary job function, as determined by the local agency.

Note: Special inspectors shall be independent entities with no financial interest in the materials or the project they are inspecting for compliance with this code.

03 VERIFICATIONS

03.1 DOCUMENTATION.

Documentation used to show compliance with this code shall include but is not limited to, construction documents, plans, specifications, bulder or installer certification, inspection reports, or other methods acceptable to the enforcing agency which demonstrate substantial conformance. When specific documentation or special inspection is necessary to verify compliance, that method of compliance will be specified in the appropriate section or identified applicable checklist.

[illegible]

BASIL AMMARI P.E.
202 AMBLING DR.
BREA, CA 92821
TEL: 714-332-0087

PROPOSED ROOM ADDITION FOR:
YURI SALMERON
5866 PANAMA DR.
BUENA PARK, CA 90620



BASIL ANMAR:


DRAWN BY
D.R.

CONSULTANT / DESIGNER SIGNATURE

DATE
12/20/2024
SCALE
NTS
JOB NO.

SHEET

GC2

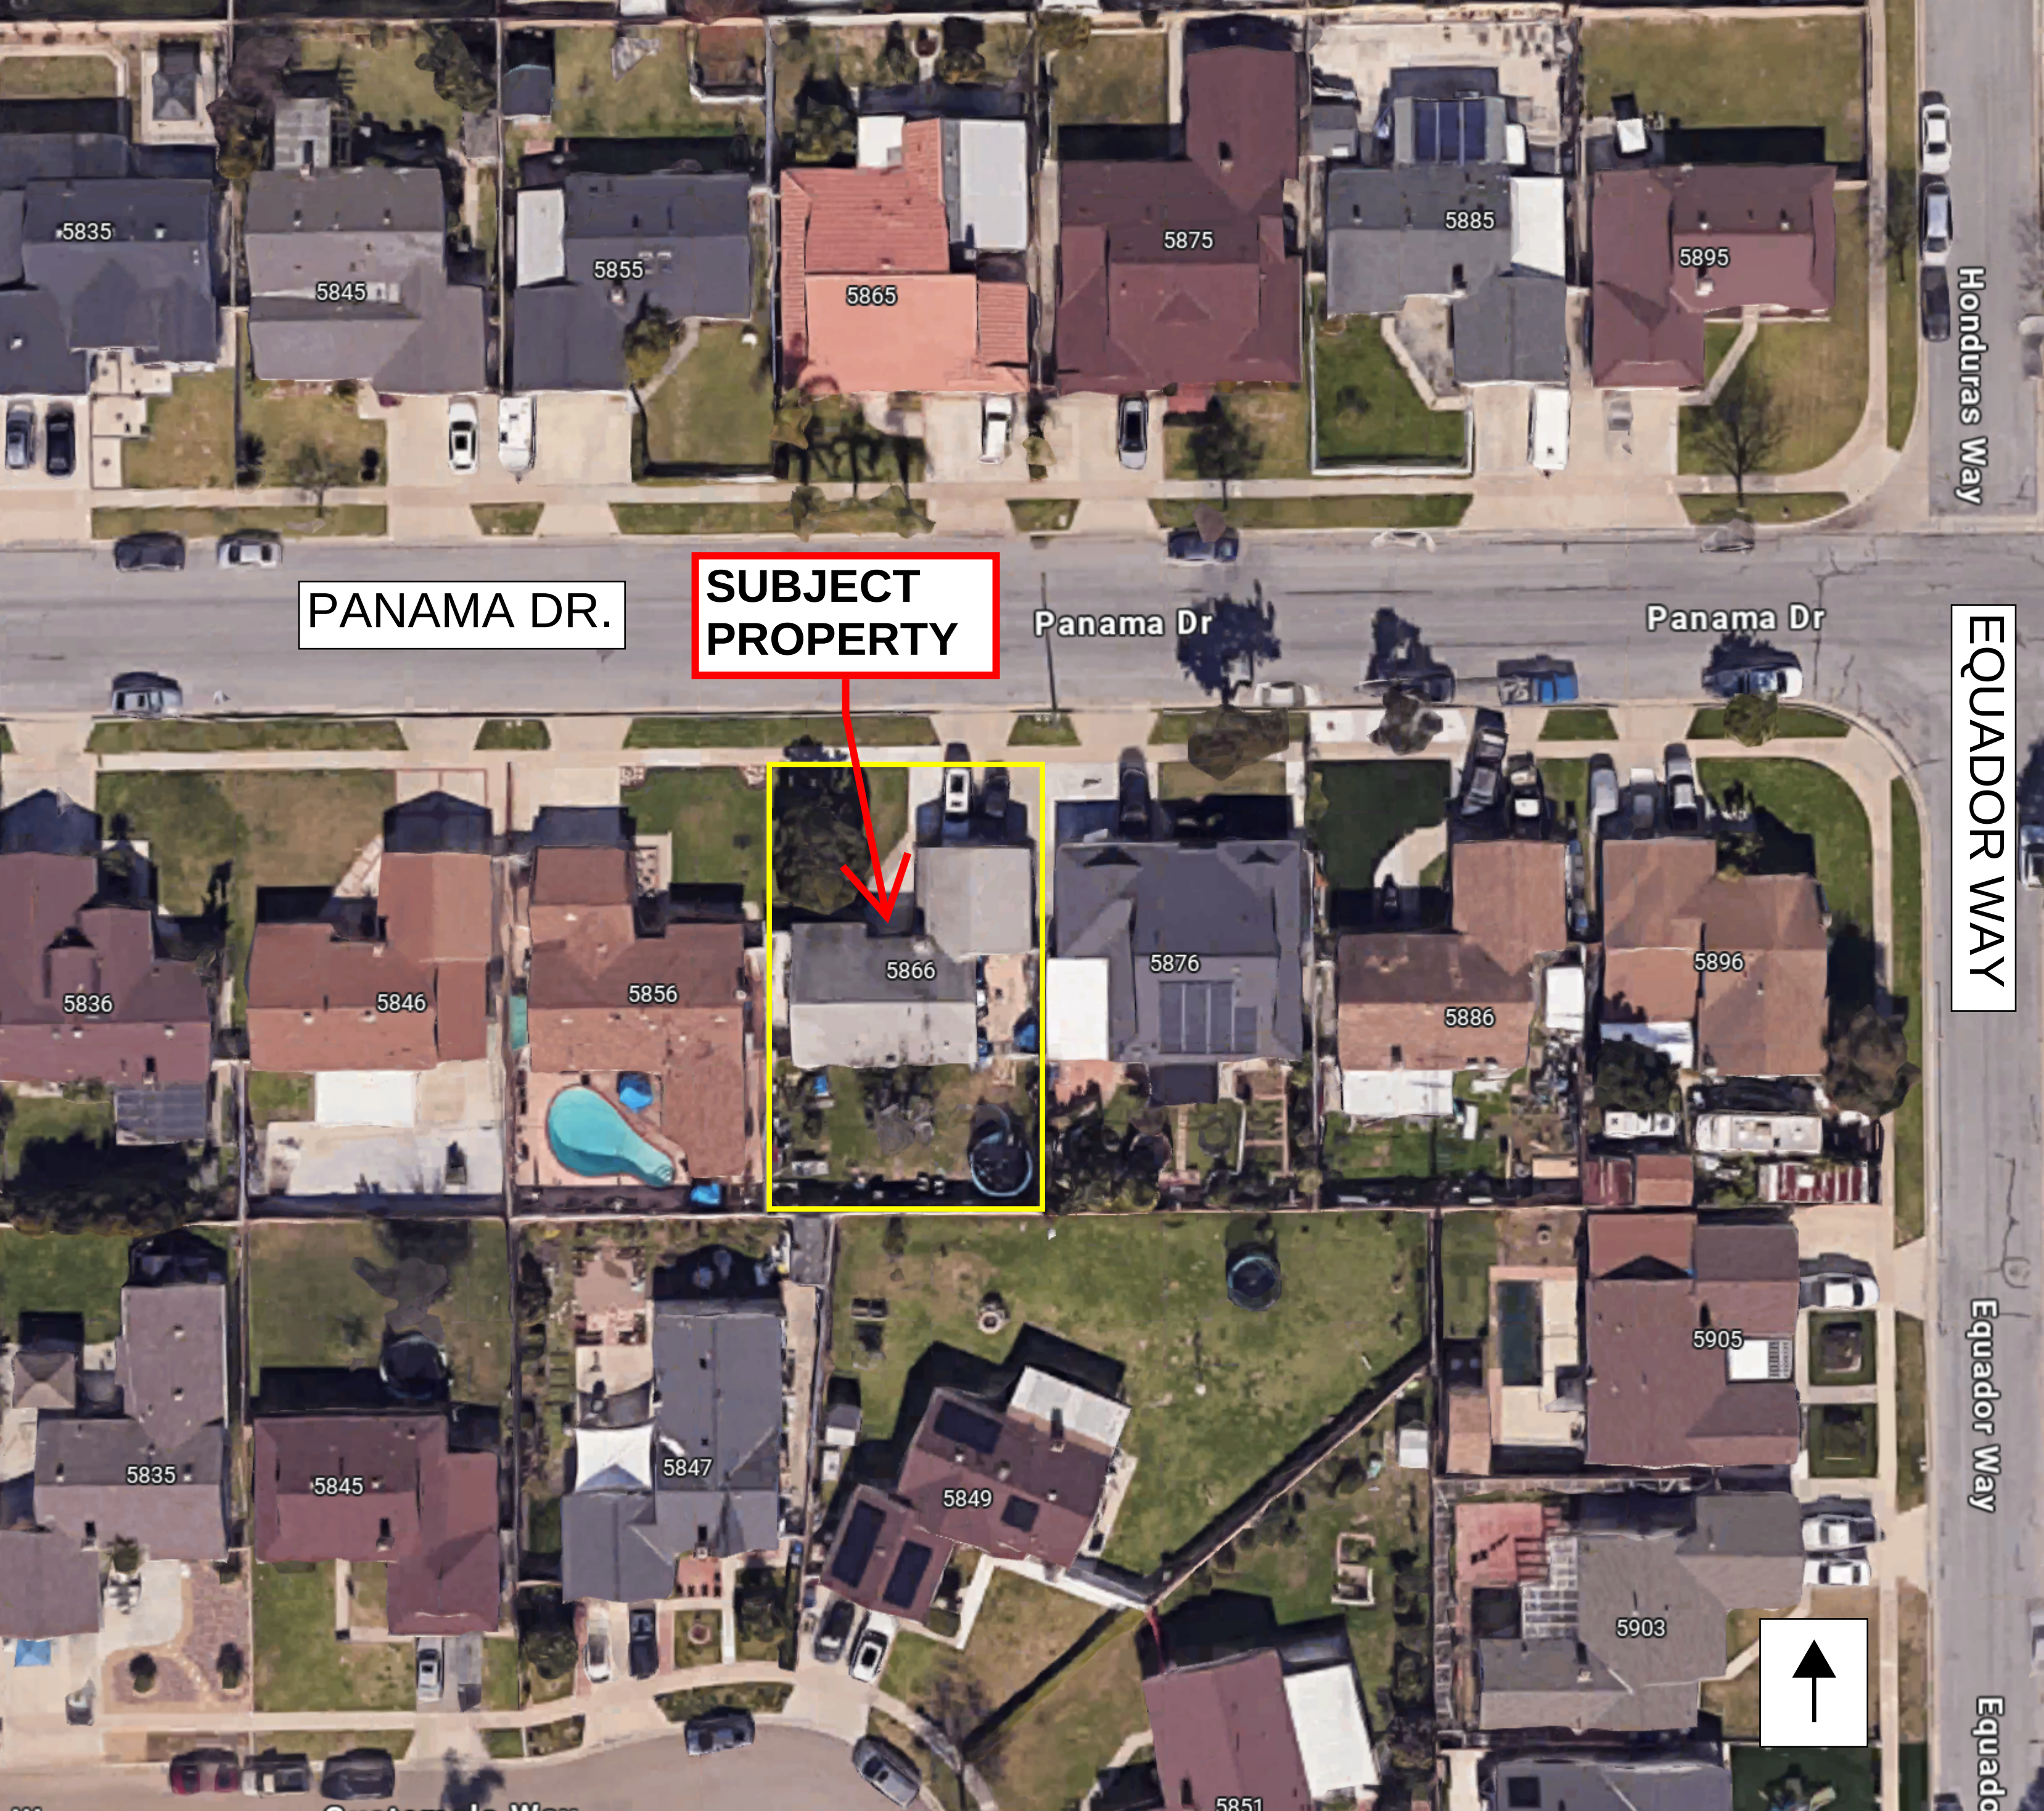

Honduras Way

PANAMA DR.

**SUBJECT
PROPERTY**

Panama Dr

Panama Dr

EQUADOR WAY

Equador Way

Equado





July 17, 2025
PUBLIC HEARING
Item No. 2B.

Zoning Administrator Agenda Report

SITE PLAN NO. SP-25-9

PREPARED BY	PRESENTED BY
JOSHUA ALVAREZ, ASSISTANT PLANNER	JOSHUA ALVAREZ, ASSISTANT PLANNER
REVIEWED AND APPROVED BY	DIRECTOR APPROVAL
HARALD LUNA, PLANNING MANAGER	MATT FOULKES, DIRECTOR OF COMMUNITY AND ECONOMIC DEVELOPMENT

RECOMMENDED ACTION

1) Conduct a public hearing; and 2) thereafter, based on the analysis provided in this agenda report and facts and findings provided in the attached Resolution, Staff recommends that the Zoning Administrator adopt the attached Resolution approving Site Plan Review No. SP-25-9 and find that the project is Categorically Exempt, per Section 15301 (Existing Facilities) Class 1 of the California Environmental Quality Act (CEQA) Guidelines based on the findings of fact and conditions provided herein.

PROPERTY INFORMATION:

Address / Assessor Parcel Number (APN):	5962 Rand Street 066-203-24
Lot Area:	7,182 square feet
Street Frontage:	57 feet 6 inches
Zoning District:	RS-6 (One-Family Residential Zone)
General Plan Designation:	Low Density Residential
Existing Development:	824 square-foot single-story, single-family dwelling with a detached 360 square-foot two-car garage

SURROUNDING LAND USE CHARACTERISTICS:

	GENERAL PLAN	ZONING	EXISTING LAND USE
North	Low Density Residential	RS-6 (One-Family Residential)	Single-family dwelling
South	Low Density Residential	RS-6 (One-Family Residential)	Single-family dwelling
East	Low Density Residential	RS-6 (One-Family Residential)	Single-family dwelling
West	Low Density Residential	RS-6 (One-Family Residential)	Single-family dwelling

APPLICATION ANALYSIS:

Project Description:

The Applicant is requesting to construct a 353 square-foot single-story addition to the rear (east) elevation, a new 37 square-foot rear porch and a new 80 square-foot front porch to an existing 824 square-foot single-story, single-family dwelling. The addition will bring the total size of the single-family dwelling to 1,177 square feet with a total of three (3) bedrooms, two (2) bathrooms, and a 360 square-foot detached two-car garage.

Development Standards Analysis:

Development Standards	Required	Proposed
Lot Coverage:	40% maximum	23%
Rear Yard Coverage:	30% maximum	0%
Setbacks:	Front: 20 ft. minimum Side: 5 ft. minimum (not abutting a street) Rear: 25 ft. minimum	Front: 26 ft. Side: North 11 ft. South 9 ft. 4 in. Rear: 59 ft.
Parking:	2-car garage	2-car detached garage 360 square feet
Front Yard Landscape:	30% minimum	69.6%

Discussion:

Section 19.128.040 (Site Plan Review) of the Buena Park Municipal Code (BPMC) requires Zoning Administrator review and approval of any addition or conversion of non-habitable areas into habitable area that causes the total residential floor area to exceed 1,100 square feet, via the Site Plan Review process.

The goal of the Site Plan Review process is to ensure that the project meets all development standards of the zoning district, and is in “reasonable harmony with the architectural character of the area” and not “detrimental to the existing and intended character” of the surrounding neighborhood. This process furthers the General Plan Policy LU-7.1 to “maintain and enhance the character of single-family residential neighborhoods.”

The proposed expansion complies with all development standards for single-family residences within the RS-6 (One-Family Residential) zone such as setbacks, height, lot coverage, and parking.

Guidelines for Single-Family Residential Additions:

The proposed architectural design of the addition to the existing single-story single-family dwelling will be consistent with the character of the existing single-family residence and residential neighborhood. The request complies with the Guidelines for Single-Family Residential Additions adopted by City Council for promoting high-quality additions compatible with adjacent properties, as listed below.

Roofs: New roofs shall blend with existing rooflines and be of unified materials.

The roof design and rooflines of the addition will consist of a gable-roof design to match the gable-roof found on the south elevation of the single-family dwelling. The roof materials of the addition to the single-family dwelling will be comprised of composition asphalt shingle roof to match the roof of the existing dwelling.

Enhanced Exteriors: Elevations to include superior finished, materials, and colors.

The proposed addition area provides a stucco finish to match the existing house that will be painted to match. The front (west) elevation of the single-family dwelling will feature new horizontal wood siding that wraps a minimum of three feet to the north and south elevations. Decorative wood shutters are proposed on the two windows located on the front (west) elevation in addition to ornamental molding. The proposed 80 square-foot front porch will feature a hip-roof design, with composition asphalt shingle roof material, stucco finish, and four decorative fixed square windows to allow natural lighting into the front entryway. No additional enhancements are required for the front elevation.

Balconies: Balconies shall include appropriate design and/or location for screening or obscuring the balcony to minimize the loss of privacy for neighboring properties.

The proposed project does not include balconies.

Windows: Windows shall include decorative treatment and windows located on the same elevation shall be consistent in design, style, and materials.

The proposed white vinyl trim windows will be consistent in style, design, operation, and materials throughout the residence. In addition to the proposed single-hung windows, a new decorative sidelight window is proposed next to the front door.

Landscape: Sufficient size and quantities shall be installed to provide screening and to protect the privacy of adjacent properties.

The proposed expansion is setback at the required distances to protect privacy of adjacent properties. The applicant has proposed to landscape the front yard area with a combination of natural grass and approximately 410 square feet of artificial turf. A separate Artificial Turf application will be required for the proposed artificial turf installation. Additionally, a pair of concrete ribbons are proposed, adjacent to the north property line, leading to a screened and paved parking space within the north side yard area of the property and behind the front yard area. A separate Driveway Modification and Artificial Turf, as conditioned, application will be required for the proposed concrete ribbons and artificial turf. No additional landscaping is required.

After reviewing the applicant's request and plans, staff visited the property and reviewed the site and building configuration as well as layout of the surrounding properties, and has determined that the site can accommodate the proposed expansion of the existing single-story single-family dwelling. When completed, the materials and color scheme of the proposed expansions of the single-story single-family dwelling will blend with the overall architectural character of the surrounding area; therefore, preserving the residential integrity of the existing residential neighborhood and will not impose any adverse impacts on adjacent properties.

ENVIRONMENTAL ASSESSMENT:

The project is Categorically Exempt, pursuant to Section 15301 (Existing Facilities) Class 1 of the State of California Environmental Quality Act (CEQA) Guidelines, because the project consists of the addition of floor area to an existing single-family residence.

PUBLIC HEARING NOTIFICATION:

Notice of public hearing was posted at the Buena Park City Hall, the Buena Park Library, and Ehlers Event Center on July 7, 2025; and seven (7) Notices were mailed to adjacent property owners of the subject property on July 7, 2025. As of the date of publication of this report, the City has not received any inquiries or letters regarding the proposed action.

Reviewed and Approved by: Harald Luna, Planning Manager

Attachments

[Proposed Zoning Administrator Resolution for Site Plan No. SP-25-9.pdf](#)

[SP-25-9 DEVELOPMENT PLANS 6.8.25.pdf](#)

[SP-25-9 VICINITY MAP.pdf](#)

RESOLUTION NO.
SITE PLAN NO. SP-25-9

A RESOLUTION OF THE ZONING ADMINISTRATOR OF THE CITY OF BUENA PARK APPROVING A SITE PLAN REQUEST TO ALLOW FOR THE DEVELOPMENT OF A 353 SQUARE-FOOT SINGLE-STORY ADDITION TO THE REAR (EAST) ELEVATION OF AN EXISTING 824 SQUARE-FOOT SINGLE-STORY, SINGLE-FAMILY DWELLING LOCATED AT 5962 RAND STREET, WITHIN THE RS-6 (ONE-FAMILY RESIDENTIAL) ZONE, WITH FINDINGS

A. Recitals.

(i) Irais L. and Sandra J. Verduzco, the applicant and property owner of 5962 Rand Street, Buena Park, CA 90621, have filed an application for the issuance of Site Plan No. SP-25-9 to construct a 353 square-foot single-story addition to the rear (east) elevation, a new 37 square-foot rear porch and a new 80 square-foot front porch to an existing 824 square foot single-story single-family dwelling. The proposed project will result in a 1,177 square-foot single-story, single-family dwelling with three (3) bedrooms, two (2) bathrooms, and a 360 square-foot detached 2-car garage on a property located at 5962 Rand Street, Buena Park, CA 90621 (APN: 066-203-24) in the County of Orange. Hereinafter in this Resolution, the subject Site Plan request is referred to as the "Application."

(ii) On July 17, 2025, the Zoning Administrator conducted a hearing on the application and concluded said hearing prior to the adoption of this Resolution.

(iii) All legal prerequisites to the adoption of this Resolution have occurred.

B. Resolution.

NOW THEREFORE, it is found, determined, and resolved by the Zoning Administrator of the City of Buena Park as follows:

1. The Zoning Administrator hereby specifically finds that all the facts set forth in Recitals, Part A, of this Resolution are true and correct.

2. Based upon substantial evidence presented to the Zoning Administrator during the above-referenced hearing, including written staff reports, verbal testimony, and development plans dated "RECEIVED JUN 8 2025 PLANNING DIV", the Zoning Administrator hereby specifically finds as follows:

a. **FINDING:** The proposed development meets all applicable requirements of this Title and other laws.

FACT: The proposed addition to the single-family dwelling comply with all applicable requirements of the General Plan and Zoning Ordinance including lot coverage, setbacks, floor plan, parking, and building materials, as conditioned. The architectural design, materials, finishes and color

scheme will blend with the overall character and color palette of the single-family dwellings from the surrounding area.

- b. **FINDING:** The site arrangement and improvements will not be detrimental to the existing and intended character of the area as defined by the General Plan, any applicable specific plans, and this Title.

FACT: The site arrangement and improvements will not be detrimental to the existing and intended character of the residential neighborhood since the proposed addition to the single-family dwelling comply with the General Plan and the Zoning Ordinance. The design of the proposed addition to the single-family dwelling meets all applicable standards and criteria and will maintain the residential character of the neighborhood.

- c. **FINDING:** Property values will be conserved.

FACT: The proposed addition will not negatively impact the property in question nor will it negatively impact surrounding properties since all improvements meet the Buena Park Municipal Code requirements as well as the Guidelines for Single-Family Residential Additions adopted by City Council for the purpose of promoting high-quality additions compatible with adjacent properties.

- d. **FINDING:** Effective and satisfactory methods are provided to protect nearby structures and activities from noise, vibration, and other adverse environmental effects generated by the subject development.

FACT: The proposed addition will not create any detrimental effects on the environment since the area was planned for residential developments, and the project site will retain the development of a single-family residence.

- e. **FINDING:** The exterior architectural design is in reasonable harmony with the architectural character of the area.

FACT: The exterior architectural design is in reasonable harmony with the architectural character of the surrounding area. All building materials, colors and finishes will match the existing house, as conditioned.

- f. **FINDING:** The arrangement and design for pedestrian and vehicular traffic will minimize congestion and protect pedestrian and vehicular safety.

FACT: The arrangement and design for pedestrian and vehicular traffic will continue to minimize congestion and protect pedestrian and vehicular safety for the subject property as well as surrounding properties. No changes are proposed to the existing pedestrian or vehicular access to and from the property.

3. The Zoning Administrator hereby finds and determines that the project identified above in this Resolution is Categorically Exempt from the requirements of the California

Environmental Quality Act (CEQA) of 1970, as amended, and the Guidelines promulgated thereunder pursuant to Class 1 Section 15301 (Existing Facilities) of Division 6 of Title 14 of the California Code of Regulations.

4. Based upon the findings and conclusions set forth in paragraphs 1, 2, and 3 above, this Zoning Administrator hereby approves the application subject to the plans dated "RECEIVED JUN 8 2025 PLANNING DIV" as modified herein and the following reasonable conditions set forth in paragraph 5 of this Resolution.

5. The following conditions are deemed necessary to protect the public health, safety, and general welfare and are reasonable and proper in accordance with the purpose and intent of the Buena Park City Code.

BUILDING DIVISION:

1. The project shall comply with the California Building Codes as adopted and amended by the City of Buena Park Municipal Code Title 15.
2. After the public hearing appeal period ends, applicant shall submit three (3) sets of construction plans to the Building Division for plan check in order to obtain required building permits.

PLANNING DIVISION:

1. This approval shall permit the construction of a 353 square-foot single-story addition to the rear (east) elevation, a new 37 square-foot rear porch and a new 80 square-foot front porch to an existing 824 square-foot single-story single-family dwelling in substantial compliance with the plans dated "RECEIVED JUN 8 2025 PLANNING DIV" and as conditioned herein.
2. The applicant and/or property owner shall ensure that a copy of the Zoning Administrator Resolution, including all conditions of approval, be reproduced on the first pages of construction drawings and shall be distributed to all design professionals, contractors, and subcontractors participating in the construction phase of the project.
3. Plans submitted for plan check shall include the remodel and addition to the single-family residence, generally consistent with the submitted plans. Specifications and samples of the following shall be submitted to the Planning Division for approval prior to issuance of building permits:
 - a. Paint colors for stucco and siding
 - b. Roofing material consisting of composition shingles
 - c. Door and window trims
 - d. Wood siding
4. The applicant shall require a separate fence/wall permit approval by the Planning Division for any proposed fences/walls to be located within the property.
5. Any fencing shown on plans shall comply with the Buena Park Municipal Code (BPMC) Chapter 19.328 (Development Standards – Fences, Walls, Hedges, and Berms) of the

City of Buena Park Zoning Ordinance and shall require separate approval by the Planning Division, as necessary.

6. Any driveway modifications including concrete ribbons shall require separate Planning Division review and shall comply with Section 19.336.040 (Residential Driveway Standards) of the Buena Park Municipal Code.
7. The applicant shall demonstrate that proposed building materials, and other architectural/site features are rated for appropriate durability and longevity. Final plans shall incorporate all changes as conditioned herein and shall recognize all easements or deed restrictions pertaining to the subject property. Any appreciable modification shall require the prior approval of the Planning Division.
8. The proposed decorative wood siding shall wrap around from the front (west) elevation to the north and south elevations a minimum of three (3) feet.
9. All on-site landscaping, including the front yard and parkway areas, which are damaged during construction shall be revitalized upon completion of construction, as necessary, prior to final building permits. All landscaping, including the parkway, shall be maintained in a healthy, green, pruned, growing condition.
10. Any installation of artificial turf shall require a separate Planning Division review and shall comply with BPMC Section 19.332.010 (Landscape Provisions for Residential Uses).
11. No roof-mounted mechanical equipment shall be permitted unless such equipment is not visible from adjacent and surrounding properties and streets from a height of five (5) feet above ground level. The installation and screening of air conditioning and similar equipment shall comply with existing design criteria and BPMC Section 19.340.020 (Visual Screening of Mechanical Equipment).
12. Interior access to all rooms/areas of the single-family dwelling shall be maintained at all times as a condition of use. No sections shall be partitioned off and provided solely with exterior access. In addition, no secondary kitchen or other cooking facilities shall be provided.
13. The construction authorized by the Site Plan shall be started within one (1) year of the expiration of the appeal period and thereafter diligently advanced until completion of the project.
14. This approval may be revoked for any violation of noncompliance with any of these conditions in accordance with BPMC Section 19.132.030 (Revocation) of the Zoning Ordinance.
15. Prior to final inspection, these conditions and all improvements shall be completed to the satisfaction of the City.
16. The project and/or use authorized by this approval shall at all times comply with all applicable local, state, and federal ordinances, statutes, standards, codes, laws, policies, and regulations.

17. The applicant and/or property owner shall sign an Affidavit of Acceptance of all conditions of approval and return it to the Planning Division within thirty (30) days after the effective date of this approval or prior to the issuance of a building permit or certificate of occupancy, whichever may occur first.
18. The applicant shall indemnify, defend, and hold harmless the City, its officers, agents, and employees from any claims and losses whatsoever occurring or resulting to any and all persons, firms, or corporations furnishing or supplying work, services, materials, or supplies in connection with the performance of the use permitted hereby or the exercise of the rights granted herein, any and all claims, lawsuits or actions arising from the granting of or exercise of the rights permitted by this approval and from any and all claims and losses occurring or resulting to any person, firm, or corporation, or property damage, injury, or death arising out of or connected with the performance of the use permitted hereby. Applicant's obligation to indemnify, defend, and hold harmless the City as stated hereinabove shall include, but not be limited to, paying all fees and costs incurred by legal counsel of the City's choice in representing the City in connection with any such claims, losses, lawsuits, or actions, and any award of such damages, judgments, verdicts, court costs or attorneys' fees in any such lawsuit or action.

PASSED AND ADOPTED this 17th day of July 2025.

Eddie Fenton
Zoning Administrator

ATTEST:

Harald Luna, Planning Manager

Resolution No.
Site Plan No. SP-25-9
July 17, 2025

AFFIDAVIT OF ACCEPTANCE:

I/ We do hereby accept all of the conditions contained in this document and all other conditions imposed by Site Plan No. SP-25-9 and do agree that I/We shall conform with and abide by all such conditions.

Date: _____

Printed Name and Signature
Owner/Applicant

DRAFT

CITY OF BUENA PARK
PROPOSED 1- STORY ADD TO (E)1-STORY S.F.D.

5962 RAND ST.BUENA PK,CA.90621
IRAIS & SANDRA VERDUZCO/OWNERS
(323)371-7769

BEST MANAGEMENT PRACTICES FOR CONSTRUCTION ACTIVITIES

Storm Water Pollution Control Requirements for Construction Activities
Minimum Water Quality Protection Requirements for All Development Construction
Projects/Certification Statement

The following is intended minimum notes or as an attachment for construction all grading plans and represent the minimum standards of good housekeeping which must be implemented on all construction sites regardless of size. (Applies to all permits)

- Eroded sediments and other pollutants must be retained on site and may not be transported from the site via sheetflow, swales, area drains, natural drainage courses or wind.
- Stockpiles of earth and other construction related materials must be protected from being transported from the site by the forces of wind or water.
- Fuels, oils, solvents, and other toxic materials must be stored in accordance with their listing and are not to contaminate the soil and surface waters. All approved storage containers are to be protected from the weather. Spills must be cleaned up immediately and disposed of in a proper manner. Spills may not be washed into the drainage system.
- Non-storm water runoff from equipment and vehicle washing and any other activity shall be contained at the project site.
- Excess or waste concrete may not be washed into the public way or any other drainage system. Provisions shall be made to retain concrete washes on site until they can be disposed of as solid waste.
- Trash and construction related solid wastes must be deposited into a covered receptacle to prevent contamination of rainwater and dispersal by wind.
- Sediments and other materials may not be tracked from the site by vehicle traffic. The construction entrance roadways must be stabilized so as to inhibit sediments from being deposited into the public way. Accidental depositions must be swept up immediately and may not be washed down by rain or other means.
- Any slopes with disturbed soils or denuded of vegetation must be stabilized so as to inhibit erosion by wind and water.
- Other:

As the project owner or authorized agent of the owner, I have read and understand the requirements listed above, necessary to control storm water pollution from sediments, erosion, and construction materials, and I certify that I will comply with these requirements.

Print Name _____
(Owner or authorized agent of the owner)

Signature _____ Date _____
(Owner or authorized agent of the owner)

GENERAL NOTES :

1. THE DISCHARGE OF POLLUTANTS TO ANY STORM DRAINAGE SYSTEM IS PROHIBITED. NO SOLID WASTE, PETROLEUM BY-PRODUCTS, SOIL PARTICULATE, CONSTRUCTION WASTE MATERIALS, OR WASTEWATER, GENERATED ON CONSTRUCTION SITES OR BY CONSTRUCTION ACTIVITIES SHALL BE PLACED, CONVEYED OR DISCHARGED INTO THE STREET, GUTTER OR STORM DRAIN SYSTEM.

- The plans shall provide a statement specifically listing all required special inspections for the project. Special inspections shall be as required by Section 1704 of the CBC.
- Show on the Building Elevations the Grade Plane for this project as defined in CRC Section R202. Finish grade around the structure/addition shall slope away from the foundation a minimum of 5% for a minimum distance of 10 feet.
- On graded sites, the top of any exterior foundation detail shall extend above the elevation of the street gutter at point of discharge at the inlet of an approved drainage device a minimum 12 inches plus 2%. Provide elevation on the site plan to show compliance. CBC 1808.7.4

Provide a specific statement on the cover sheet of the plans in the code analysis stating "This project is subject to the requirements of Chapter 7A of the California Building Code".

EXTERIOR COVERING. The exposed siding or cladding material applied to the exterior side of an exterior wall, roof eave soffit, floor projection or exposed underfloor framing.

IGNITION-RESISTANT MATERIAL. A type of building material that resists ignition or sustained flaming combustion sufficiently so as to reduce losses from wildland-urban interface configuration under worst-case weather and fuel conditions with wildfire exposure of burning embers and small flames, as prescribed in Section 703A and SFAI Standard 12-7A-5, Ignition-Resistant Material.

RAFTER TAIL. The portion of roof rafter framing in a sloping roof assembly that projects beyond and overhangs an exterior wall.


ROOF EAVE. The lower portion of a sloping roof assembly that projects beyond and overhangs an exterior wall at the lower end of the rafter tails. Roof eaves may be either "open" or "enclosed". Open roof eaves have exposed rafter tails and an unenclosed space on the underside of the roof deck. Enclosed roof eaves have a boxed-in roof eave soffit with a horizontal underside or sloping rafter tails with an exterior covering applied to the underside of the rafter tails.

ROOF EAVE SOFFIT. An enclosed boxed-in soffit under a roof eave with exterior covering material applied to the soffit framing creating a horizontal surface on the exposed underside.

FIRE-RETARDANT TREATED WOOD shall be tested in accordance with ASTM D 2898 "Standard Practice for Accelerated Weathering of Fire-Retardant Treated Wood for Fire Testing (Method A)" and the requirements of Section 2303.2.

HEAVY TIMBER CONSTRUCTION. A type of construction classification specified in Section 602. For use in this chapter, heavy timber shall be sawn lumber or glue-laminated wood with the smallest minimum nominal dimension of 4". Heavy timber walls or floors shall be sawn or glue-laminated planks, splined, tongue-and-groove or set close together and well spiked.

WILDLAND-URBAN INTERFACE FIRE AREA is a geographical area identified by the state as a "Fire Hazard Security Zone" in accordance with the Public Resources Code Sections 4201 thru 4204 and the Government Code Sections 51175 thru 51189 or other areas designated by the enforcing agency to be at significant risk from wildfire. See Section 716A for the applicable referenced sections of the government Code and the Public Resources Code.

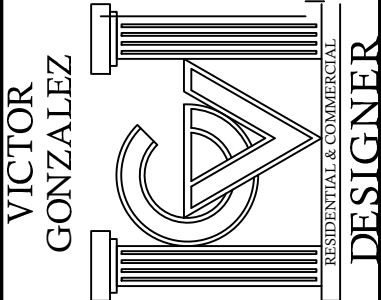

DRAFTING DESIGN

15545 BELLFLOWER BLVD. SUITE G
BELLFLOWER, CA 90706
PHONE (562) 928-5444 victor_drafting@yahoo.com
DESIGNER: VICTOR GONZALEZ

PROPOSED 1-STORY ADD.TO
(E)1-STORY S.F.D..
W/(E)2-CAR DETACHED

5962 RAND ST.BUENA PK,CA.90621
IRAIS & SANDRA VERDUZCO/OWNERS
(323)371-7769

DESIGNER
VICTOR GONZALEZ

DRAWN
V. G.-S.R.

DATE
06.7.25

SCALE
AS SHOWN

SHEET

T

OF

SHEETS

RECEIVED

JUN 8 2025

PLANNING DIV

UNIT A

SP-25-9

PROJECT DATA

LOT SIZE = IRREGULAR
LOT AREA = 7,182 SF .
ZONING = RS-6
(E) 1-STORY S.F.D. = 824 SF
(E) TWO-CAR GARAGE = 360 SF
(E)MTL. PATIO COVER TO BE REMOVED = 308 SF
(E) PORCH = 36 SF

PROPOSED : S.F.D.

(P) 1-STORY ADD. = 353 SF
(P) REMODEL KITCHEN = 115 SF
(N)REMODEL PORCH = 80 SF
(N) TOTAL LIVING = 1,177 SF

PROPOSED : ADU(ADU-25-23)UNDER SEPARATE PERMIT
(N)ADU = 986 SF
(N) PORCH = 25 SF

FAR = 1,177 = 1,177 / 7,312.5 : 16.09 %

OCCUPANCY :R3/U

FIRE SPRINKLES : NO

TYPE OF CONSTRUCTION = VB

USE : RESIDENTIAL

MAX. HEIGHT = 14'-1"

= LOT COVERAGE :

= 1,177 +360+80+27 = 1,644/ 7,182 = 22.89 %

LEGAL DESCRIPTION :

TRACT NO 1190 M.M.38-12
A.P.N.066-203-24

CODE COMPLAINE

NOTE : "THE EXISTING BUILDING IS NOT BY
AUTOMATIC SPRINKLER SYSTEM"

2023 BUENA PARK MUNICIPAL CODE(AMC)
2023 CALIFORNIA RESIDENTIAL CODE(CRC)
2023 CALIFORNIA BUILDING CODE (CBC)
2023 CALIFORNIA MECHANICAL CODE(CMC)
2023 CALIFORNIA PLUMBING CODE(CPC)
2023 CALIFORNIA ELECTRICAL CODE(CEC)
2023 CALIFORNIA FIRE CODE(CFC)
2023 ENERGY EFFICIENCY STD.
2023 CALIFORNIA GREEN STANDARDS .CODE(CALGREEN)

NOTE : STUCCO COLOR/FINISH TO MATCH (E)FIELD

SCOPE TO WORK :

PROPOSED 353 SF ADDITION AND 37 SF PORCH AND 115 SF KITCHEN
REMODEL WITH 80 SF PORCH TO (E)1-STORY S.F.D.
PROPOSED(N)ADU : (ADU-25-23)UNDER SEPARATE PERMIT.

CONSULTANTS

OWNER
IRAIS & SANDRA VERDUZCO
5962 RAND ST.
BUENA PARK,CA.90621
(323) 371-7769

CIVIL ENGINEER ;
CAM CONSULTING ENGINEERS
38100 SAN MATEO AVE.
PALMDALE, CA 93551
(818) 425-7513

CONSULTANTS :
ENERGY CALCULATIONS:
PERFECT DESIGN
RAYMOND ZHONG
2416 W VALLEY BLVD.
ALHAMBRA,CA.91803
(626)289-8808


DESIGNER ;
DRAFTING DESIGN
VICTOR GONZALEZ
15545 BELLFLOWER BLVD. SUITE G
BELLFLOWER, CA 90706
(562)928-5444

VICINITY MAP

FIRE DEPARTMENT NOTE : "BUILDING ADDRESS
SHALL BE PROVIDED ON THE BUILDING IN SUCH A
POSITION AS TO BE PLAINLY VISIBLE AND LEGIBLE
FROM THE STREET OR ROAD FRONTING THE PROPERTY NUMBERS SHALL
CONTRAST W/BACKGROUND.BE ARABIC OR ALPHABETICAL LETTERS AND BE
A MIN. OF 4" HIGH W/A MIN. STROKE OF 1/2"

LEGAL DESCRIPTION :
TRACT NO 1190 M.M.38-12
A.P.N.066-203-24




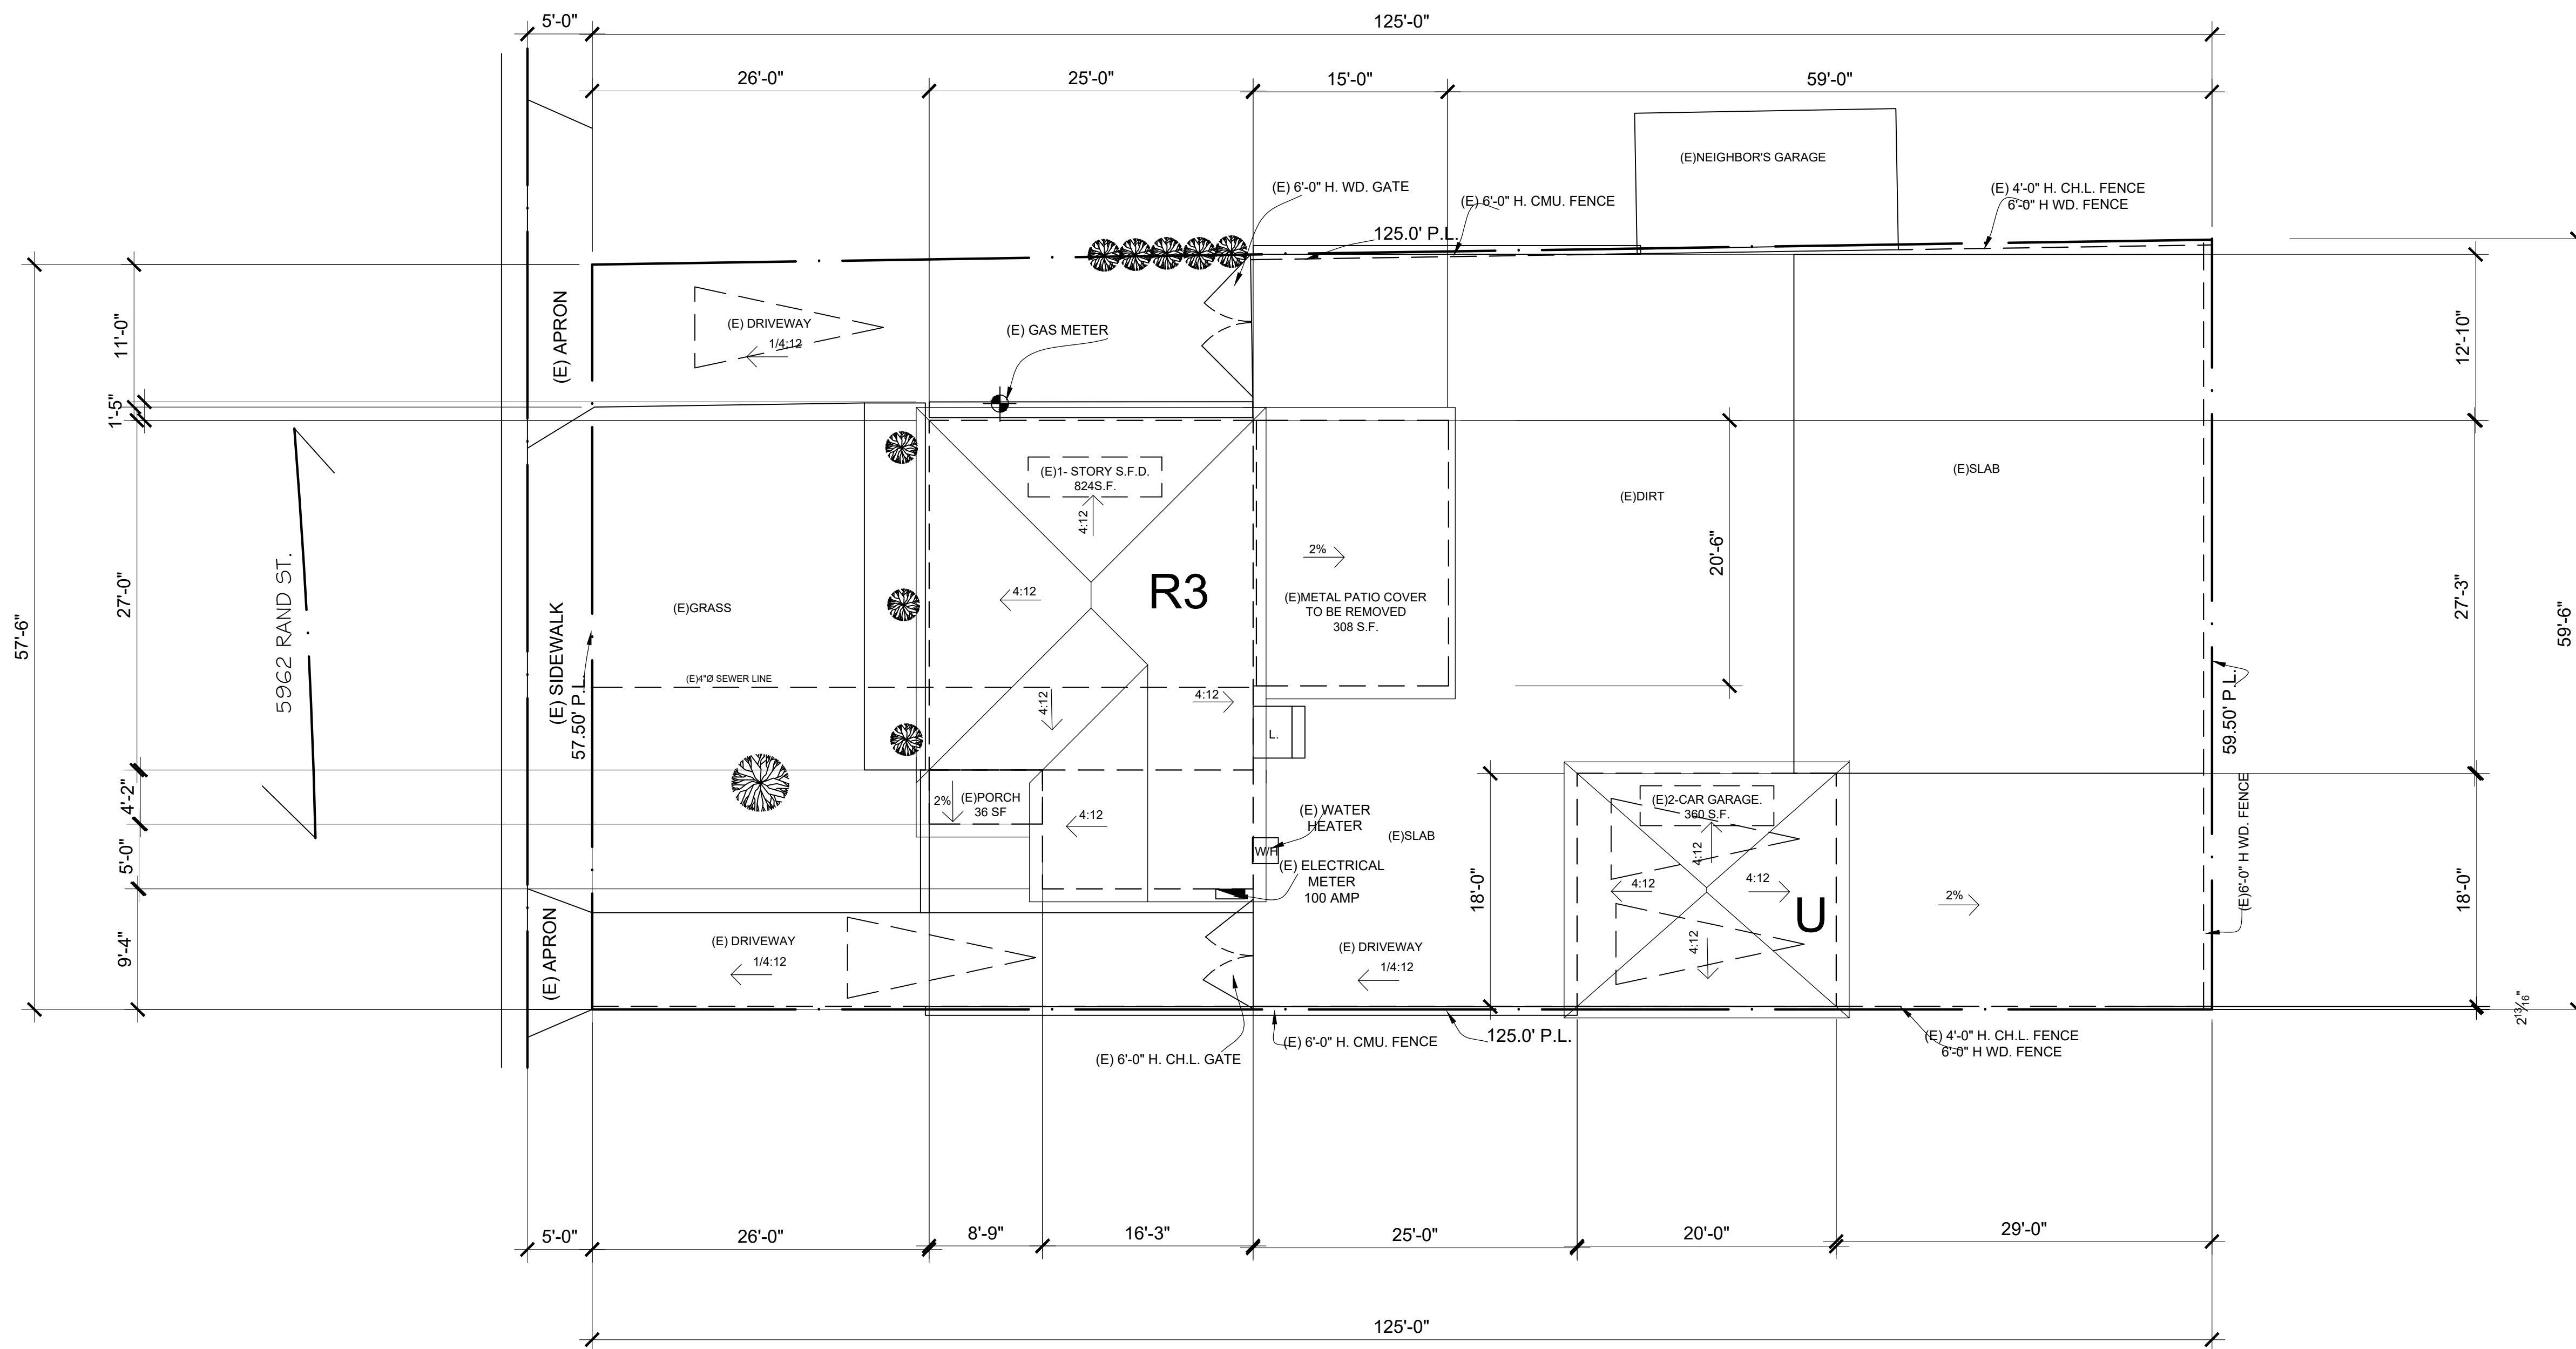


(E) SITE & ROOF PLAN

SITE DRAINAGE NOTE : DRAINAGE SHALL BE CONVEYED TO THE STREET VIA NON-EROSIVE DEVICES.

SC. 1/8" = 1'-0"

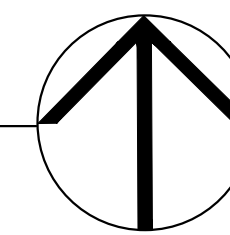

UNIT A

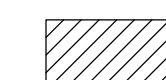

NEW ADDITION - LIVING AREA
HERS INSPECTION REQUIRED


- (E) EXISTING (STRUCTURE, FENCE, DRIVEWAY OR TREE...)
- (N) NEW STRUCTURE ADDITION
- (P) PROPOSED
- S.F.D. SINGLE FAMILY DWELLING
- MTL. METAL
- WD. WOOD

- 1 ORIGINAL VIRTUAL LINE OF HOUSE (GABLE ROOF 4:12)
- 2 HOUSE EXTENSION: KITCHEN, BEDROOM, BATHROOM, ROOF EXT. 2:12 PITCH (SEE EAST & WEST ELEVATIONS)
- 3 PROPOSED FOR NEW ADDITION GABLE ROOF SEPARATE FROM EXIST. TO AVOID MORE LOAD OVER EXISTING STRUCTURE AND PROPOSED WD. CRICKET TO CONDUCT RAIN WATER TO SIDE OTHER REASON FOR ECONOMICAL SITUATION AND NOT CONFLICT WITH FRONT VIEWS

NO WORK SHALL BE PERFORMED IN THE PUBLIC RIGHT OF WAY WITHOUT FIRST OBTAINING A PERMIT FROM PUBLIC WORKS ENGINEERING DIV. ALL WORK SHALL BE TO STANDARD SPECIFICATIONS.

NOTE: "THE DISCHARGE OF POLLUTANTS TO ANY STORM DRAINAGE SYSTEM IS PROHIBITED. NO SOLID WASTE, PETROLEUM BYPRODUCTS, SOILS PARTICULATE, CONSTRUCTION WASTE MATERIALS, OR WASTEWATER GENERATED ON CONSTRUCTION SITES OR BY CONSTRUCTION ACTIVITIES SHALL BE PLACED, CONVEYED OR DISCHARGED INTO THE STREET, GUTTER OR STORM DRAIN SYSTEM."

DRAFTING DESIGN

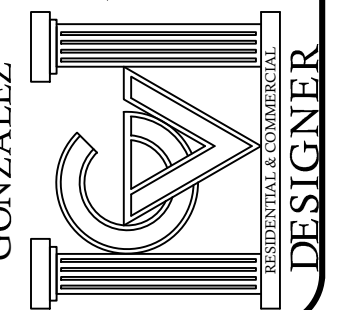

PROPOSED 1-STORY ADD. AND PATIO COVER TO (E) 1-STORY S.F.D.

5962 RAND ST. BUENA PK, CA 90621
IRAI & SANDRA VERDUZCO/OWNERS
(323) 371-7769

DESIGNER
VICTOR GONZALEZ


DRAWN
V. G./S.R.

DATE
06.7.25




SCALE
AS SHOWN

SHEET
A-1

OF SHEETS

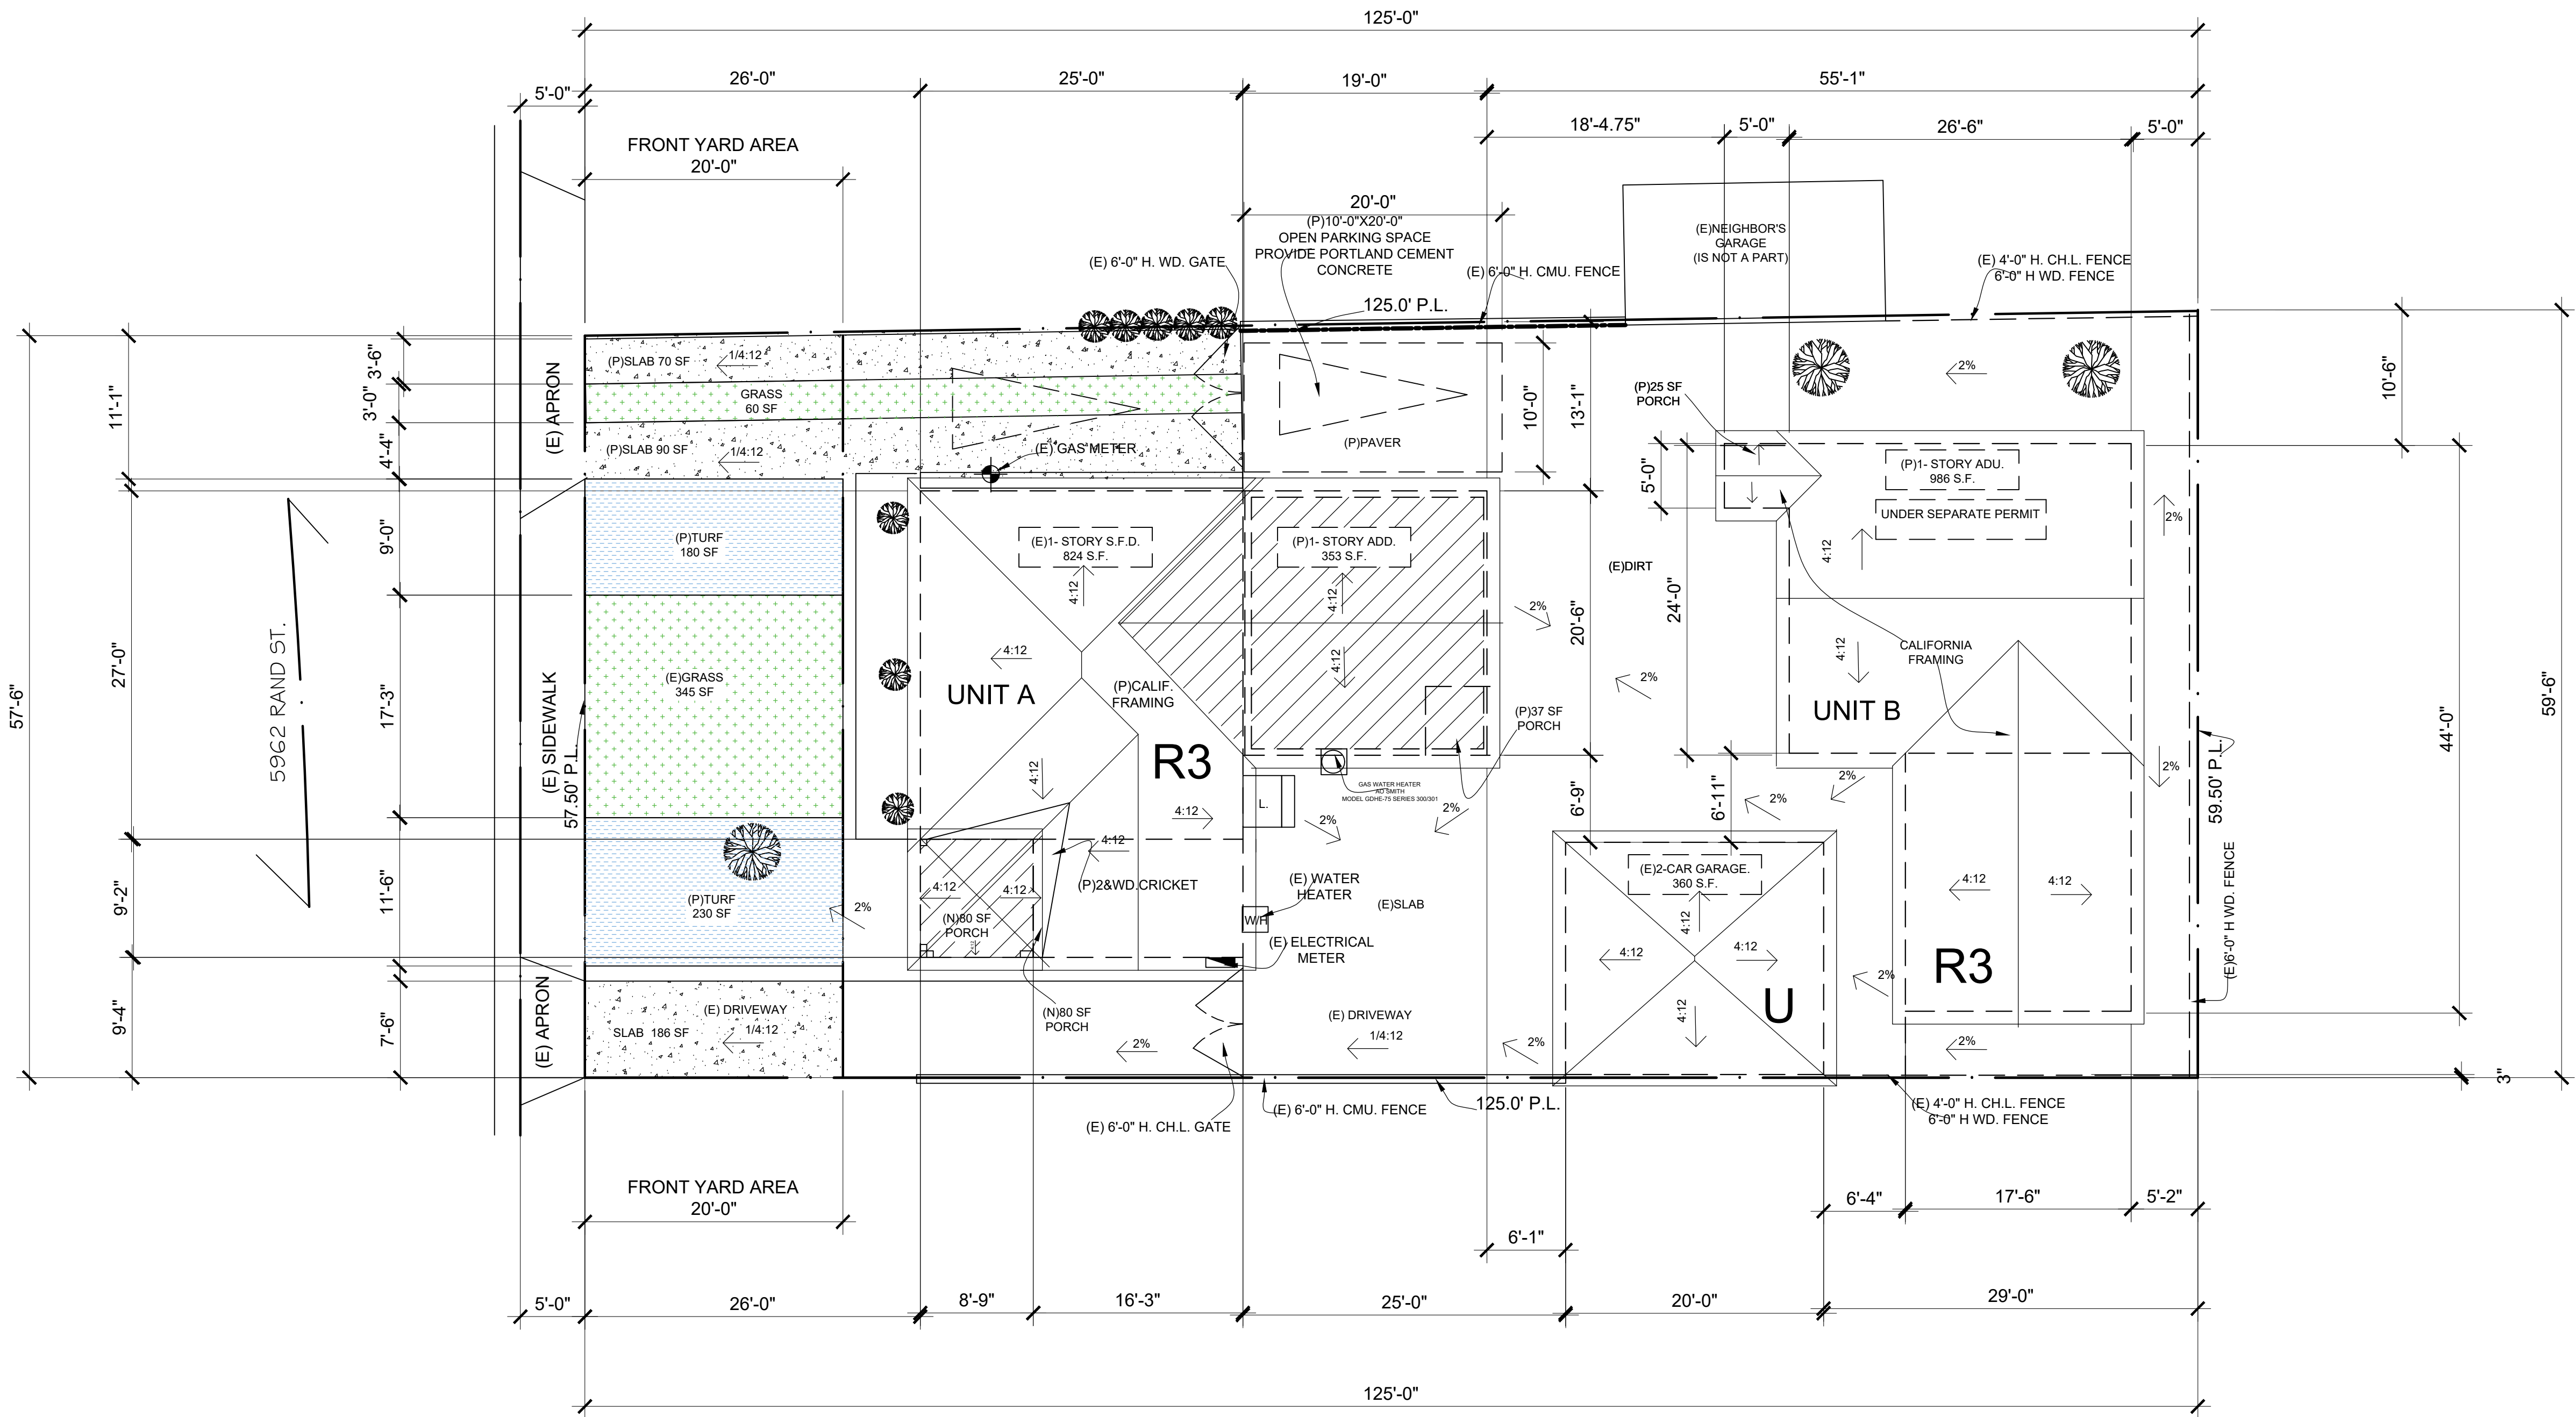


LANDSCAPE FRONT SET BACK:

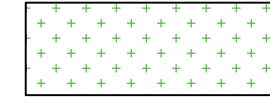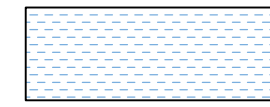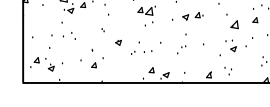	57.50 X 20 =1,150 SF = 100%
	GRASS 20 X 17.25 = 345 SF = 30% MIN 20 X 3 = 60 SF = 4%
	TURF 20 X 11.5 = 230 SF = 20 % 20 X 9 = 180 SF = 15.6%
	SLAB 20 X 9.33 = 186 SF = 16.1% 20 X 8 = 160 SF = 13.9%

(E)&(P) SITE & ROOF PLAN

SITE DRAINAGE NOTE : DRAINAGE SHALL BE CONVEYED TO THE STREET VIA NON-EROSIVE DEVICES.

SC. 1/8" = 1'-0"

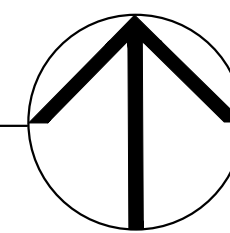

	NEW ADDITION :LIVING AREA HERS INSPECTION REQUIRED
(E)	EXISTING (STRUCTURE, FENCE, DRIVEWAY OR TREE...)
(N)	NEW STRUCTURE ADDITION
(P)	PROPOSED
S.F.D.	SINGLE FAMILY DWELLING
MTL.	METAL
WD.	WOOD

UNIT A

- 1 ORIGINAL VIRTUAL LINE OF HOUSE(GABLE ROOF 4:12)
- 2 HOUSE EXTENSION;KITCHEN;BEDROOM;BATHROOM(ROOF EXT.2:12 PITCH)SEE EAST & WEST ELEVATIONS
- 3 PROPOSED FOR NEW ADDITION GABLE ROOF SEPARATE FROM EXIST. TO AVOID MORE LOAD OVER EXISTING STRUCTURE AND PROPOSED WD.CRICKET TO CONDUCT RAIN WATER TO SIDE OTHER REASON FOR ECONOMICAL SITUATION AND NOT CONFLICT WITH FRONT VIEWS

NO WORK SHALL BE PERFORMED IN THE PUBLIC RIGHT OF WAY WITHOUT FIRST OBTAINING A PERMIT FROM PUBLIC WORKS ENGINEERING DIV. ALL WORK SHALL BE TO STANDARD SPECIFICATIONS.

NOTE: "THE DISCHARGE OF POLLUTANTS TO ANY STORM DRAINAGE SYSTEM IS PROHIBITED.NO SOLID WASTE,PETROLEUM BYPRODUCTS,SOILS, PARTICULATE,CONSTRUCTION WASTE MATERIALS,OR WASTEWATER GENERATED ON CONSTRUCTION SITES OR BY CONSTRUCTION ACTIVITIES SHALL BE PLACED,CONVEYED OR DISCHARGED INTO THE STREET,GUTTER OR STORM DRAIN SYTEM "


PROPOSED 1-STORY ADD. AND PATIO COVER TO
(E)1-STORY S.F.D.

DRAFTING DESIGN

15545 BELLFLOWER BLVD. SUITE G
BELLFLOWER, CA 90706
PHONE (562) 928-5444 victor_drafting@yahoo.com
DESIGNER: VICTOR GONZALEZ

DESIGNER
VICTOR GONZALEZ


DRAWN
V. G./S.R.
DATE
06.7.25
SCALE
AS SHOWN
SHEET
A-1.1
OF SHEETS

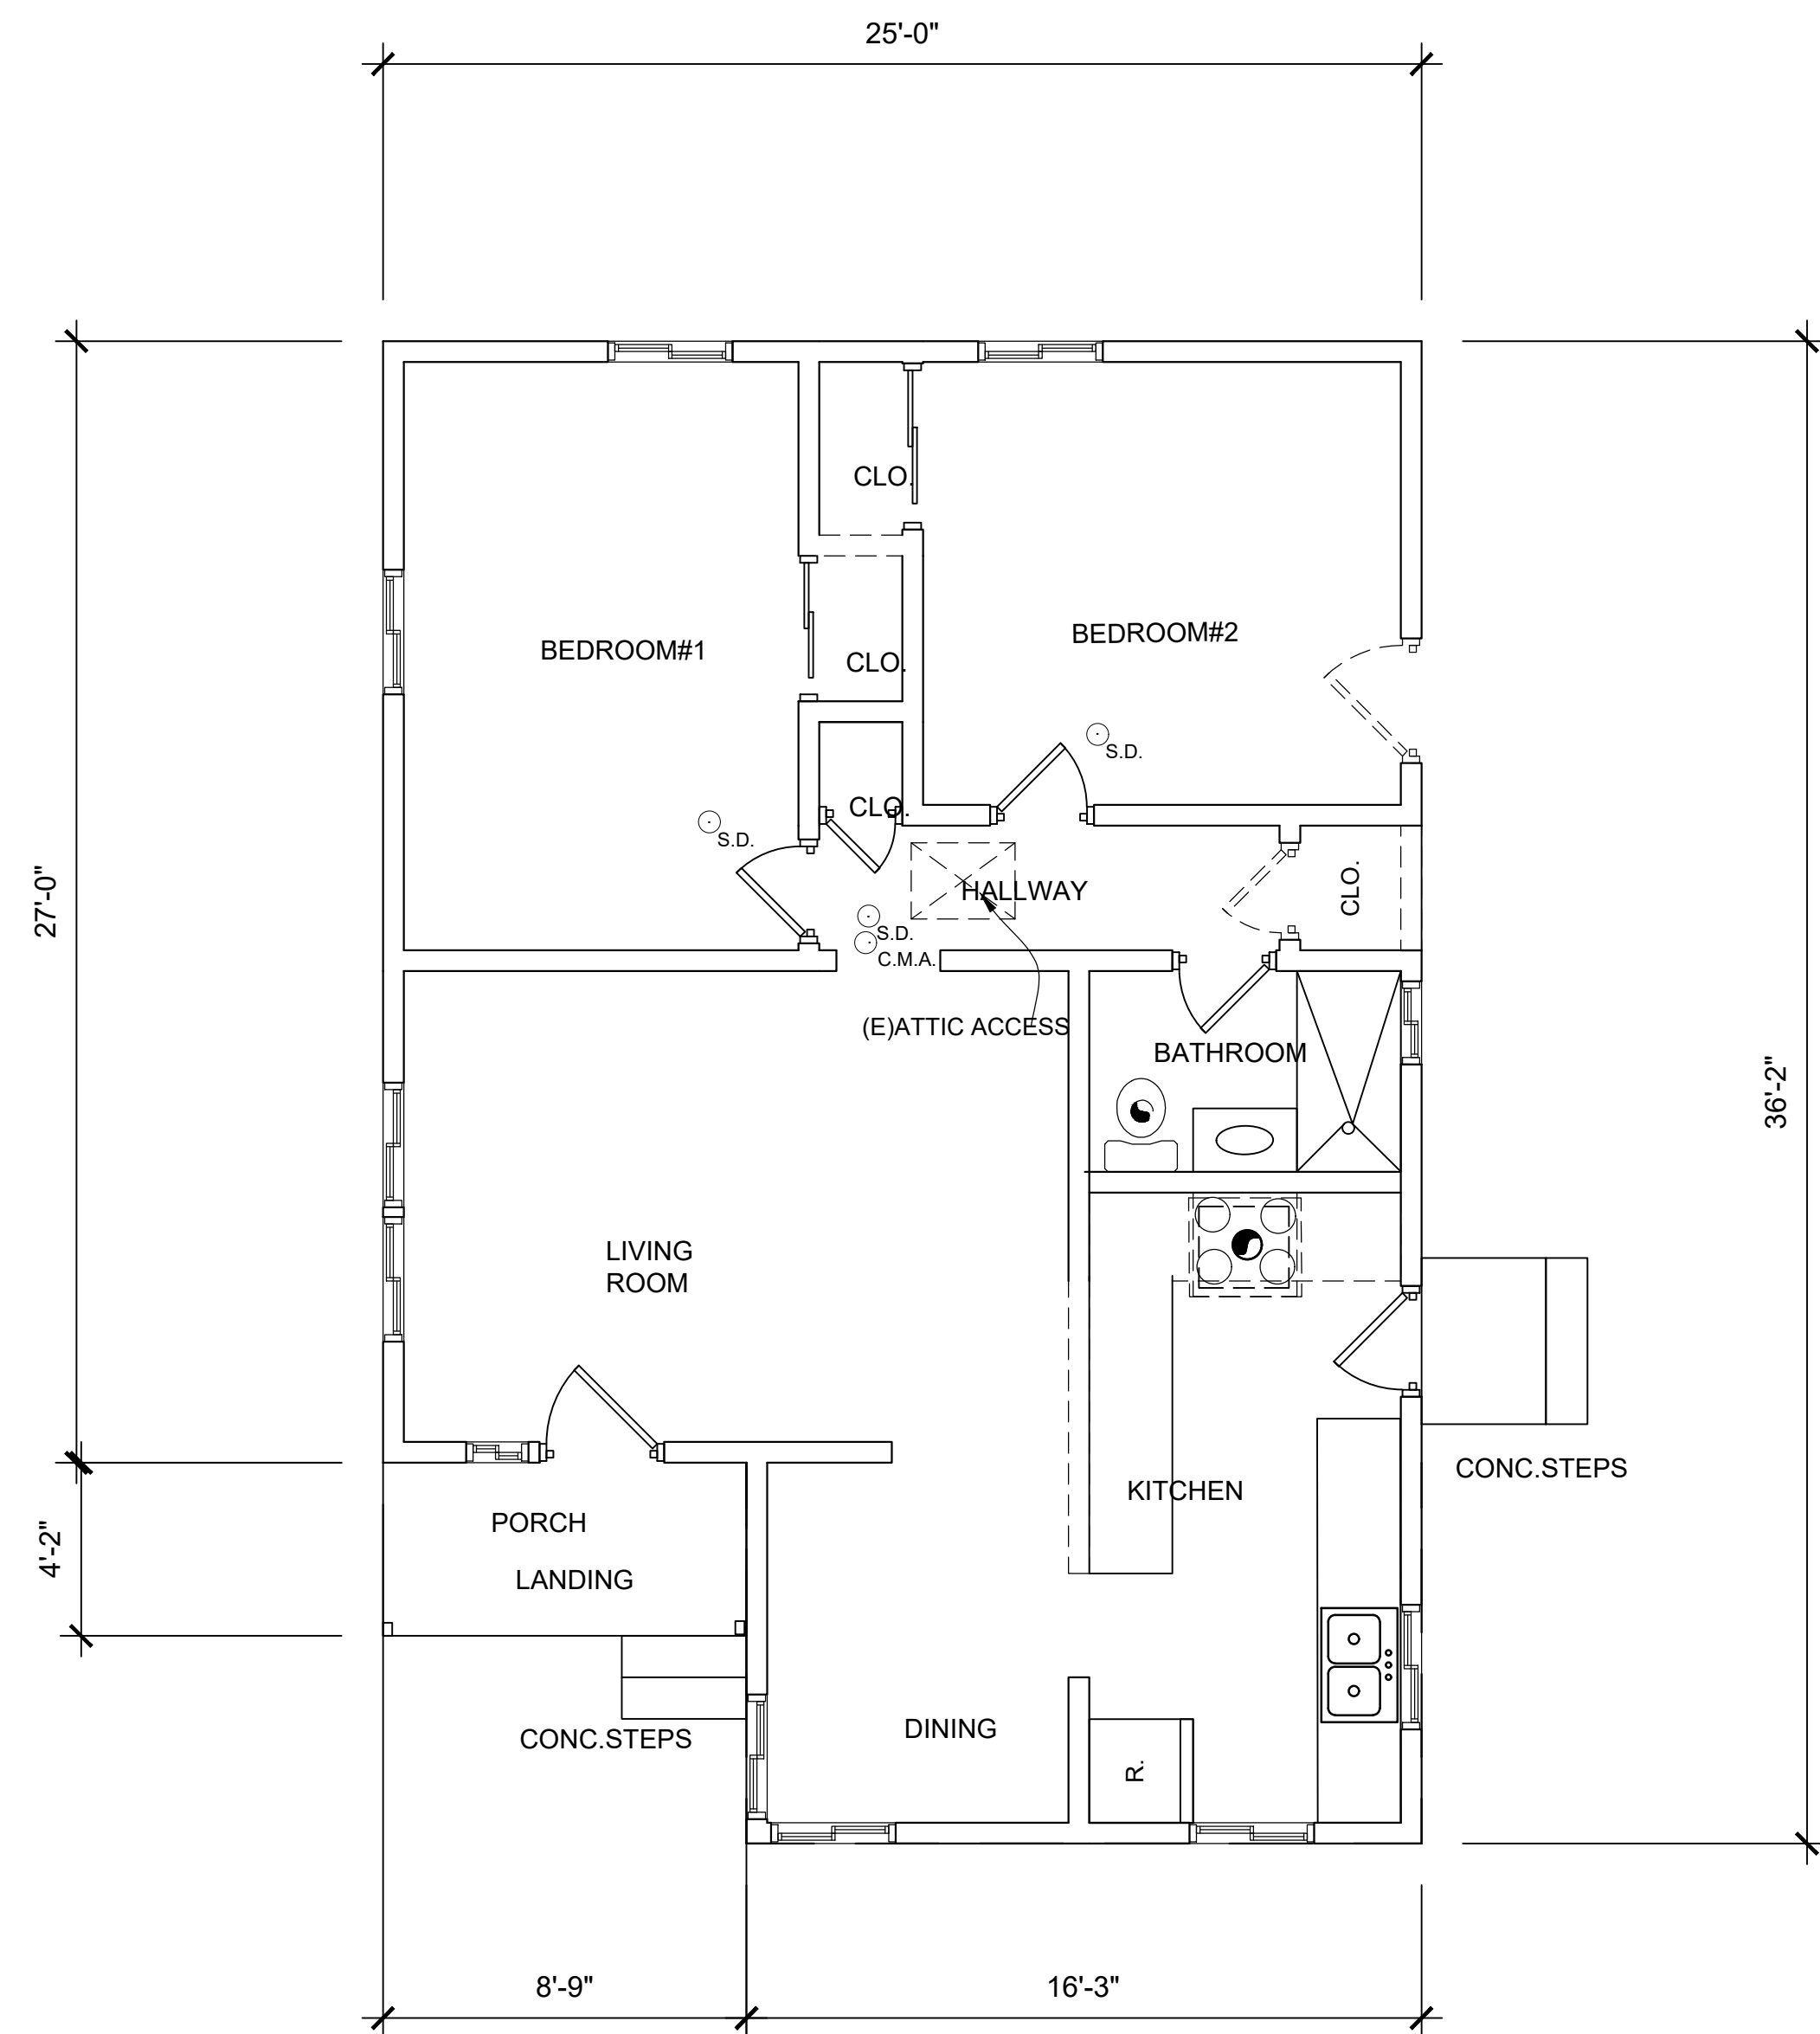

(E) GROUND FLOOR PLAN(S.F.D.)

GROSS AREA = 824 SF

SC. 1/4" = 1'-0"

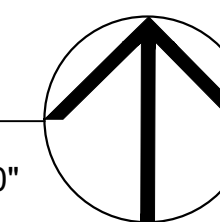


UNIT A

WALL LEGEND

(E) 2X WALL TO REMAIN

1-STORY ADD.

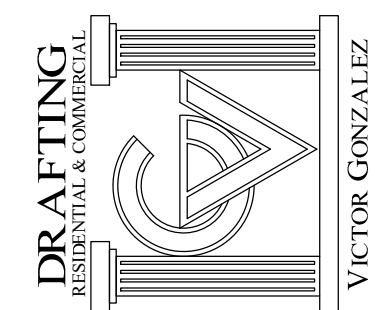

DRAFTING DESIGN

15545 BELLFLOWER BLVD. SUITE G
BELLFLOWER, CA 90706
PHONE (562) 928-5444 victor_drafting@yahoo.com
DESIGNER: VICTOR GONZALEZ

PROPOSED 1-STORY ADD. AND
PATIO COVER TO
(E)1-STORY S.F.D.

5962 RAND ST. BUENA PK. CA 90621
IRAI & SANDRA VERDUZCO/OWNERS
(323)371-7769

DESIGNER
VICTOR GONZALEZ

DRAWN
V.G.-S.R.

DATE
05.30.25

SCALE
AS SHOWN

SHEET

A-2

OF SHEETS

WINDOW SCHEDULE

ALL WINDOWS ARE DOUBLE GLAZED

	SIZE	MAT.	GLAZING	ACTION	REMARKS	QTY.
A	3'-0" X 4'-6"	VINYL	5/8" INS.	S.HUNG	(N)X O	8
B	6'-0" X 4'-0"	VINYL	5/8" INS.	S.HUNG	(N)X O	1
C	2'-6" X 2'-0"	VINYL	5/8" INS.	S.HUNG	(N)XO T.G.	1
D	1'-6" X 2'-0"	VINYL	5/8" INS.	S.HUNG	(N)XO T.G.	1
E	3'-0" X 3'-0"	VINYL	5/8" INS.	S.HUNG	(N) T.G.	1

NOTE: ALL WINDOW & PATIO DOOR BY MILDGARD WDW'S OR EQUAL. COLOR TO MATCH (E). ALL GLAZING TO BE DUAL GLAZED AND TEMPERED GLASS AS NEEDED.

NOTE: " ALL NEW GLAZING WILL BE INSTALLED WITH LABELS TO REMAIN IN PLACE FOR INSPECTION"

NOTE: THE LOAD RESISTANCE OF GLASS UNDER UNIFORM LOAD SHALL BE DETERMINED IN ACCORDANCE WITH ASTM E1300

NOTE: "THE NFRC TEMPORARY LABEL DISPLAYED ON WINDOWS MUST REMAIN ON THE UNTIL FINAL INSPECTION HAS BEEN COMPLETED"

Electrical Legends

	CENTER LIGHT		EXHAUST FAN SEE NOTE
	BLDG. WALL LIGHT		WATER PROOF OUTLET
	S.D.		RECEPTACLE OUTLET
	CAM		RECEPTACLE OUTLET
	SINGLE SWITCH		SINGLE SWITCH WIDIMMER
	SINGLE SWITCH W/VACANCY SENSOR		THREE WAY SWITCH
	SINGLE SWITCH W/MOTION SENSOR		RECESS DOWNLIGHT

SMOKE ALARMS NOTE:
"WHERE MORE THAN ONE MORE SMOKE ALARM IS REQ. TO BE INSTALLED, THE SMOKE ALARM SHALL BE INTERCONNECTED IN SUCH A MANNER THAT THE ACTIVATION OF ONE ALARM WILL ACTIVATE ALL OF THE ALARMS"

Smoke alarms shall be provided as follows :
a.- In new construction smoke alarms shall receive their primary power source from the building wiring and shall be equipped with battery back.
c.- CARBON MONOXIDE ALARM IS REQUIRED UL2034/2075

FIRE PROTECTION :

1.- IN EACH SLEEPING ROOM, ON THE CEILING OR WALL IMMEDIATELY OUTSIDE OF EACH SLEEPING ROOM, AND ON EACH STORY AND BASEMENT FOR DWELLING WITH MORE THAN ONE STORY.

2.-THE POWER SOURCE FOR SMOKE DETECTORS SHALL BE AS FOLLOWS :

SMOKE ALARMS:
a) SMOKE ALARM SHALL BE TESTED & MAINTAINED IN ACCORDANCE INTERCONNECTED HARD-WIRED WITH MANUFACTURER INSTRUCTIONS. SMOKE ALARMS SHALL BE REPLACED AFTER 10 YEARS FROM THE DATE OF MANUFACTURE MARKED ON THE UNIT.
b) CONVENTIONAL IONIZATION SMOKE ALARMS THAT ARE SOLELY BATTERY POWERED SHALL BE EQUIPPED WITH A 10 YEARS BATTERY AND HAVE A SILENCE FEATURE.

NOTE : CARBON MONOXIDE ALARM SHALL BE INTERCONNECTED HARD-WIRED WITH BATTERY BACKUP"

NOTE : PROVIDE RECEPTACLES SHALL BE LISTED AS TAMPER-RESISTANT FOR ALL 15 AND 20 AMP. IN ALL AREAS SPECIFIED IN 210.52. ALL NON-LOCKING-TYPE PER CE SECTION 406.12.

NOTE : All outdoor lightings shall be controlled by a manual ON and OFF switch that does not override to ON and one of the following : Controlled by photocell and motion sensor, Photo control and automatic switch control, Astronomical time clock or Energy management control system.

NOTE : Provide the intermittent local exhaust airflow rates of 50 cfm for Bathrooms and 20 cfm continuous. Table 150.0-E and Table 150.0-F.

1 CLOTHES DRYER MOISTURE EXHAUST DUCT MUST BE A 4 INCHES IN DIAMETER, AND LENGTH IS LIMITED TO 14 FEET WITH 2 ELBOWS. THE DUCT LENGTH SHALL BE REDUCED BY 2 FT. FOR EVERY ELBOW IN EXCESS OF TWO. CLOTHES DRYER AND ELECTRICAL RANGES SHALL HAVE 4-WIRE GROUNDED ELECTRICAL OUTLET PER CEC250.140. ELECTRICAL RANGE REQUIRES A MINIMUM OF 40-AMP WIRE (#6 COPPER OR #4 ALUMINUM) PER 220-19.

2 NEW OR REPLACEMENT WATER HEATERS SHALL BE STRAPPED TO THE WALL IN TWO PLACES. ONE IN THE UPPER 1/3 OF THE TANK AND ONE IN THE LOWER 1/3 OF THE TANK. THE LOWER POINT SHALL BE A MINIMUM OF 4 INCHES ABOVE THE CONTROLS. (P.C. 510.5)

3 PROVIDE FOR BATHROOMS (EXHAUST FAN WITH SHALL BE A MIN. 50 CFM. WITH HUMIDISTAT CONTROLS SHALL BE DUCTED TO TERMINATE OUTSIDE

4 PROVIDE EXHAUST FAN HALLWAY & LAUNDRY (CONTINUOUSLY OPERATING) w/ MINIMUM CAPACITY OF 60 CFM. "THIS FAN TO REMAIN ON DURING ALL HOURS THE HOUSE IS OCCUPIED"

5 HOOD AND EXHAUST FAN KITCHEN SHALL EXHAUST TO THE EXTERIOR W/ENERGY STAR AND CONTROLLED BY HUMIDISTAT w/ MINIMUM CAPACITY OF 100CFM. MAX SOUND RATING OF 3 SONES @ 280 CMF PER CALGREEN 2022 MIN & VENTING DIRECTLY TO THE OUTSIDE WITH A BACK-DRAFT DAMPER

NOTE "ALL HOSE BIBS MUST HAVE AN APPROVED ANTI-SIPHON DEVICE. (CPC 603.5.7)"

DOOR SCHEDULE

ALL WINDOWS ARE DOUBLE GLAZED

	SIZE	MAT.	GLAZING	ACTION	REMARKS	QTY.
1	3'-0" X 6'-8"x1 ³ / ₈ "	WD.S.C.		SWING	(N)THRESHOLD	1
2	2'-8" X 6'-8"x1 ³ / ₈ "	WD.H.C		SWING	(N)	3
3	2'-8" X 6'-8"x1 ³ / ₈ "	WD.S.C.	⁵ / ₈ " INS.	SWING	PATIO DOOR T.G.	1
4	2'-8" X 6'-8"x1 ³ / ₈ "	WD.S.C	⁵ / ₈ " INS	SWING	T.G.	1
5	6'-0" X 6'-8"	ALUM.	¹ / ₄ " T.G.	SLIDING	T.G.	1
6	8'-0" X 6'-8"	ALUM.	¹ / ₄ " T.G.	SLIDING	T.G.	1

PLUMBING SCHEDULE :
WATER CLOSETS : 1.28 GPF PER FLUSH
SINGLE SHOWERHEAD & MULTIPLE SHOWERHEADS : 1.80 GPM @ 80 psi
NOTE: A HAND-HELD SHOWER SHALL BE CONSIDERED A SHOWERHEAD
LAVATORY FAUCETS : 1.2 GPM @ 60 psi AND
MIN. 0.80 GAL/MINUTE AT 20 PSI
KITCHEN FAUCETS : 1.8 GPM @ 60psi

NOTES PIPE MATERIALS:
1.-WATER COLD AND HOT WILL USED
3/4"Ø COOPER
2.GAS : 3/4"Ø GREEN PIPE
3.-SEWER 4"Ø P.V.C WITH MIN SLOPE TO BE 2%
4.PLASTIC AND COPPER PIPING RUN THROUGH FRAMING MEMBERS TO WITHIN ONE INCH OF THE EXPOSED FRAMING SHALL BE PROTECTED BY STEEL NAIL PLATES NOT LESS THAN 18 GAUGE.

NOTE : WATER PIPING MATERIALS WITHIN A BUILDING SHALL BE IN ACCORDANCE WITH SEC. 604.1 OF THE CALIFORNIA PLUMBING CODE. PE, CPVC AND OTHER PLASTIC WATER PIPING SYSTEM SHALL BE INSTALLED IN ACCORDANCE WITH THE REQUIREMENTS OF SEC. 604 OF THE CPC. INSTALLATION STANDARD 5 OF APPENDIX I OF THE CPC AND MANUFACTURERS RECOMMENDED INSTALLATION STANDARDS. CPVC WATER PIPING REQUIRES A CERTIFICATION OF COMPLIANCE AS SPECIFIED IN SEC 604.1.1(a).

NOTE: SHOWER FLOOR AND WALLS ABOVE SHOWER COMPARTMENT SHALL BE FINISHED WITH A NON ABSORBENT SURFACE TO A HEIGHT OF 6"FT ABOVE THE FLOOR (R307.2 CRC)

T1. All new residential units are required to be Energy Storage System (ESS) ready. Provide the following on the plans per CEnergy C150.0(u):
a) At least one of the following shall be provided:
i) ESS ready interconnection equipment with a minimum backed-up capacity of 60 amps and a minimum of four ESS-supplied branch circuits, or
b) A dedicated raceway from the main service to a panelboard (subpanel) that supplies the branch circuits in Section I 50.0(a)(2). All branch circuits are permitted to be supplied by the main service panel prior to the installation of an ESS. The trade size of the raceway shall be not less than 1 inch. The panelboard that supplies the branch circuits (subpanel) must be labeled "Subpanel shall include all back up load circuits."

c) A minimum of four branch circuits shall be identified and have their source of supply collocated at a single panelboard suitable to be supplied by the ESS. At least one circuit shall supply the refrigerator, one lightning circuit shall be located near the primary egress and at least one circuit shall supply a sleeping room receptacle outlet.
d) The main panelboard shall have a minimum busbar rating of 225 amps.

e) Sufficient space shall be reserved to allow future installation of a system isolation equipment/transfer switch within 3 feet of the main panelboard. Raceway shall be installed between the panelboard and the system isolation equipment/transfer switch location to allow the connection of backup power source.
T2. System using gas or propane furnace to serve individual dwelling units shall include the following per CEnergy C150.0(t):
a) A dedicated 240 volt branch circuit wiring shall be installed within 3 feet from the furnace and accessible to the furnace with no obstructions. The branch circuit conductors shall be rated at 30 amps minimum. The blank cover shall be identified as "240V ready." All electrical components shall be installed in accordance with the California Electrical Code.

b) The main electrical service panel shall have a reserved space to allow for the installation of a double pole circuit breaker for a future heat pump space heater installation. The reserved space shall be permanently marked as "For Future 240V use."


T3. Systems using gas or propane cooktop to serve individual dwelling units shall include the following per CEnergy C150.0(u):
a) A dedicated 240 volt branch circuit wiring shall be installed within 3 feet from the cooktop and accessible to the cooktop with no obstructions. The branch circuit conductors shall be rated at 50 amps minimum. The blank cover shall be identified as "240V ready." All electrical components shall be installed in accordance with the California Electrical Code.
b) The main electrical service panel shall have a reserved space to allow for the installation of a double pole circuit breaker for a future electric cooktop installation. The reserved space shall be permanently marked as "For Future 240V use."

T4. Clothes dryer locations with gas or propane plumbing to serve individual dwelling units shall include the following per CEnergy C150.0(v):
a) A dedicated 240 volt branch circuit wiring shall be installed within 3 feet from the clothes dryer location and accessible to the clothes dryer location with no obstructions. The branch circuit conductors shall be rated at 30 amps minimum. The blank cover shall be identified as "240V ready." All electrical components shall be installed in accordance with the California Code.
b) The main electrical service panel shall have a reserved space to allow for the installation of a double pole circuit breaker for a future electric clothes dryer installation. The reserved space shall be permanently marked as "For Future 240V use."

T5. On the cover sheet, list all HERs inspection features and special features required. Please coordinate with the Energy Report.
T6. Energy design was designed based on a tank type water heater. Plans show a tankless water heater. Please coordinate plans with energy design.
T7. Kitchens require exhaust fans to comply with table 150.0-G. Show exhaust fan on a ducted range hood and specify CFM rating on plans. Exhaust fan must be ducted to exterior of the building.

NOTE: ALL FIXTURES, EQUIPMENTS, PIPING AND MATERIALS SHALL BE LISTED.


FIBER-CEMENT HARDY BACKER, FIBER-MAT REINFORCED, GLASS MAT GYPSUM OR FIBER-REINFORCED GYPSUM BACKERS FOR A BASE WALL TILE IN SHOWER AREAS AND WALL & CEILING PANELS IN SHOWER AREAS

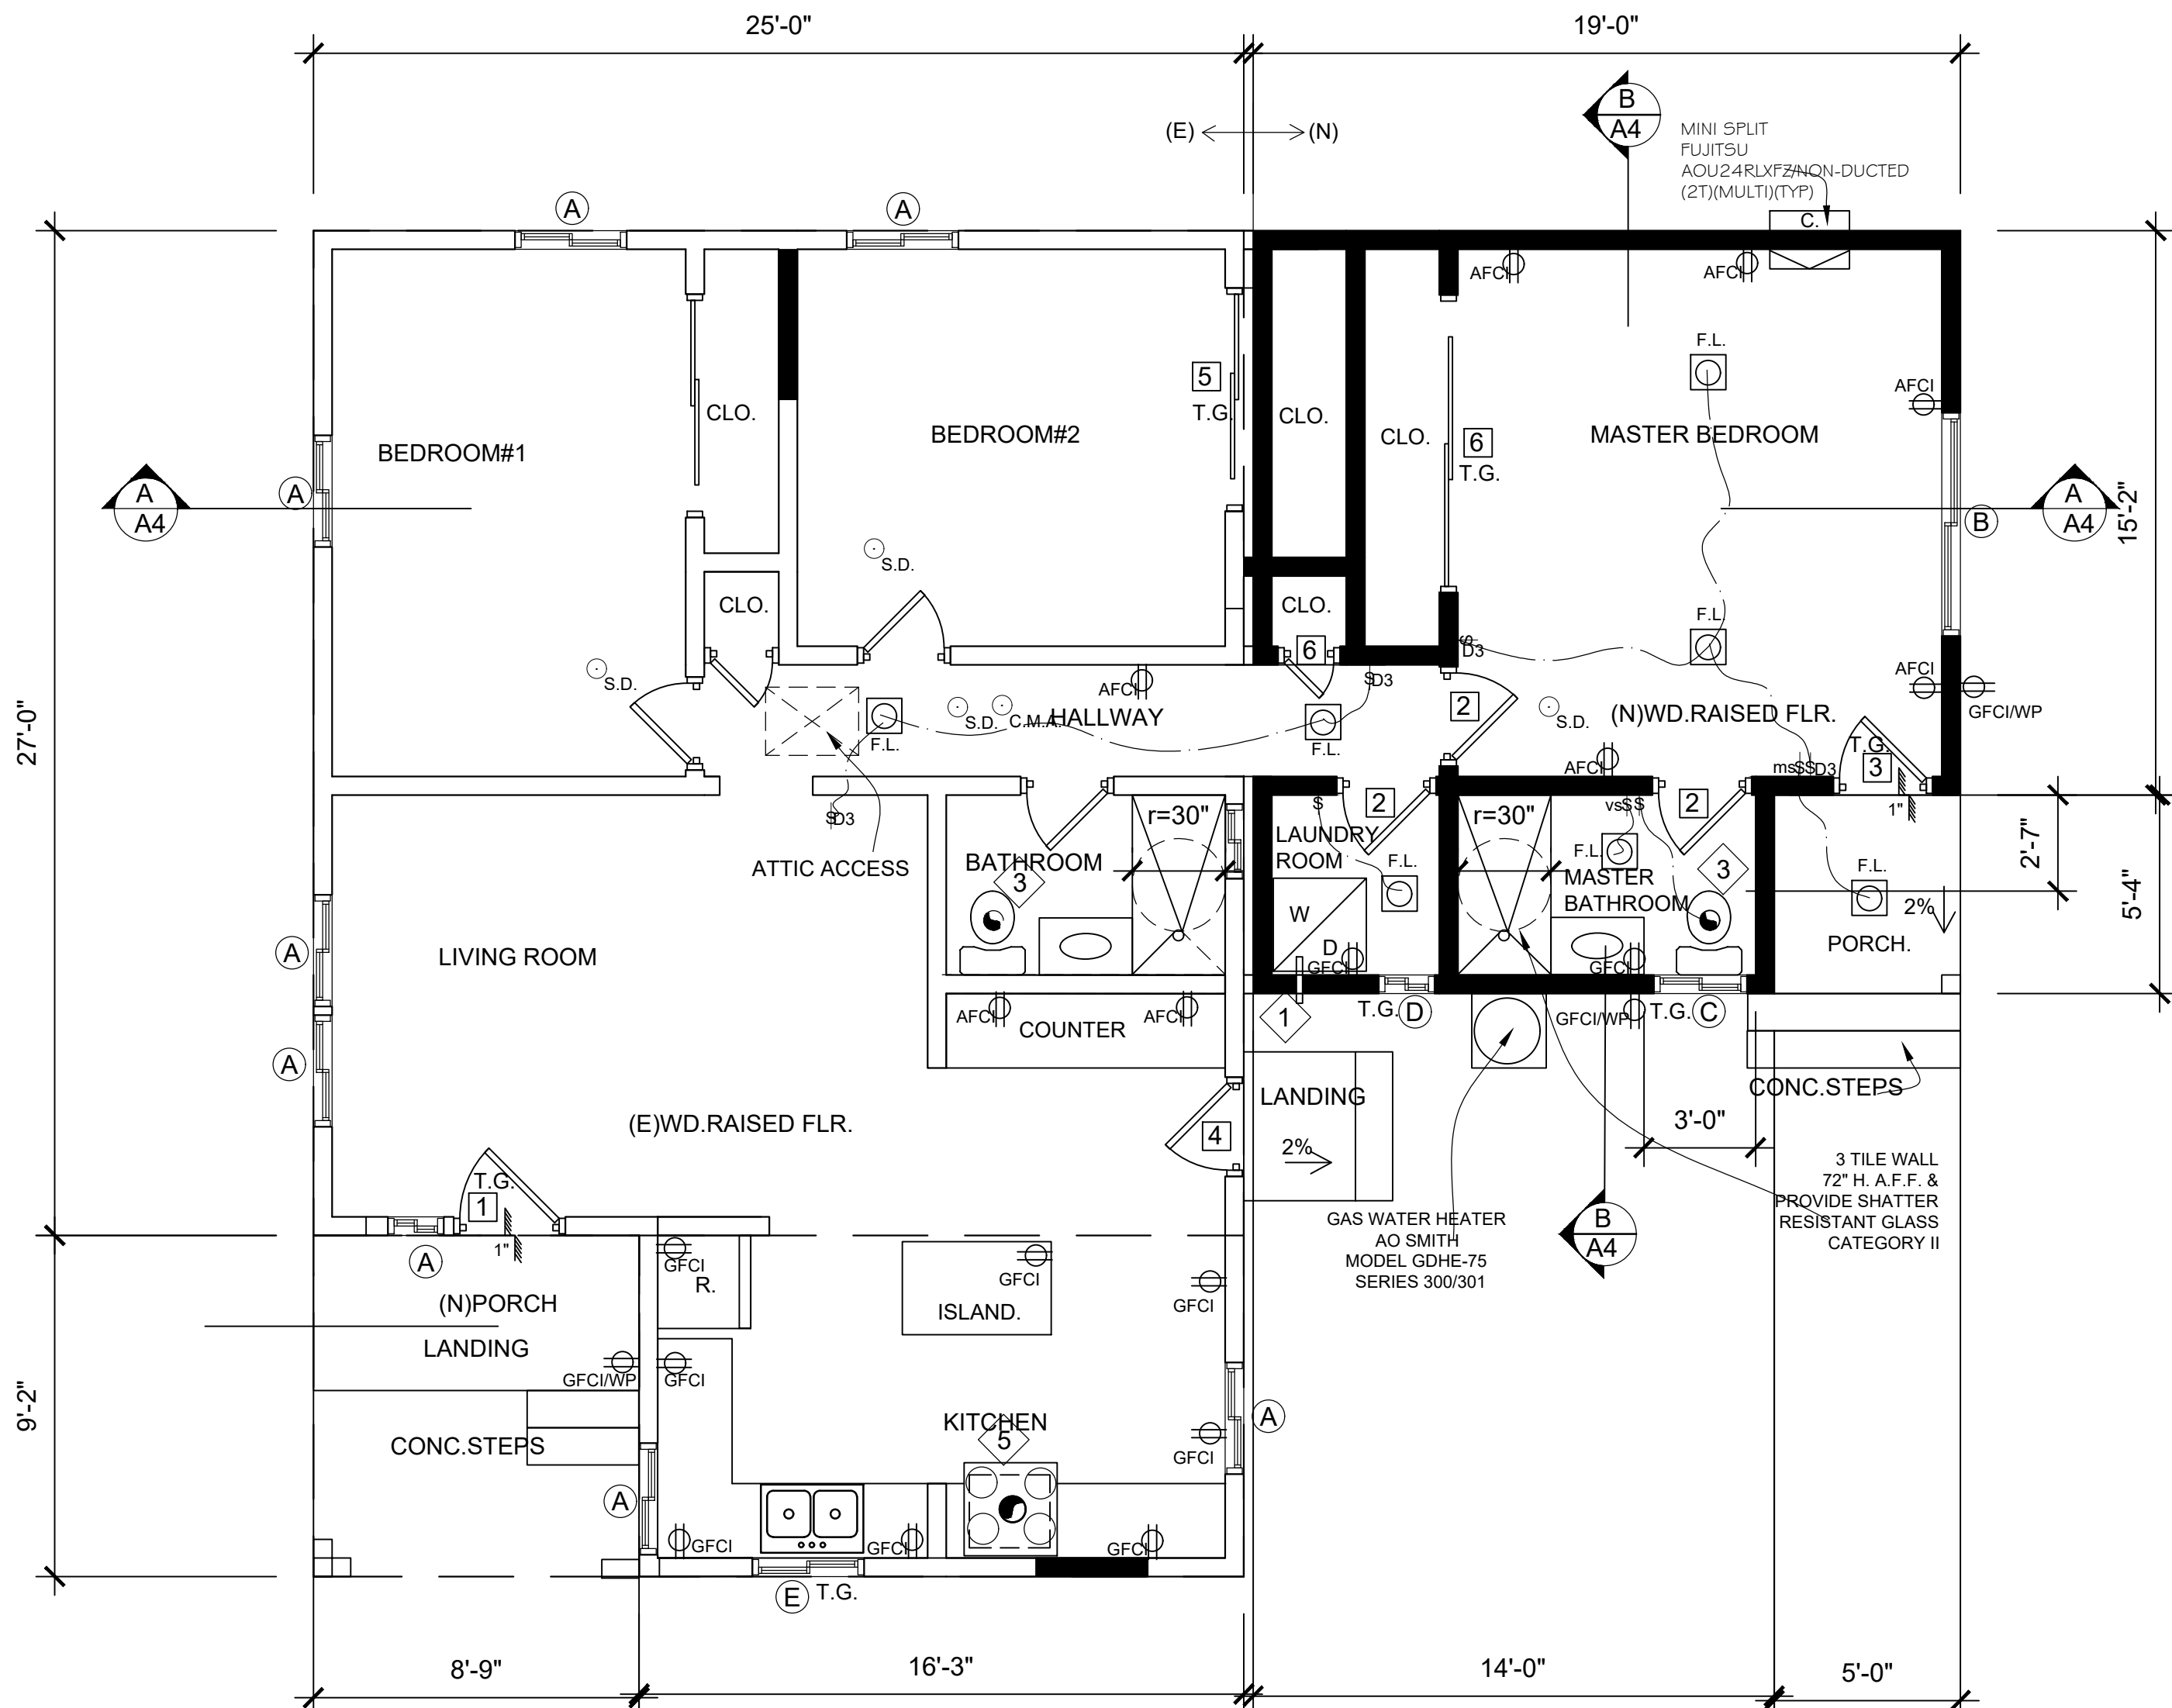

(E)&(P)GROUND FLOOR PLAN

GROSS AREA = 1,253 SF
(E)LIVING AREA = 824 SF
(P)LIVING AREA = 353 SF
(N)TOTAL LIVING = 1,177 SF
KITCHEN REMODEL = 115 SF
(P)PORCH AREA = 27 SF
(P)REMODEL PORCH AREA = 80 SF

SC. 1/4" = 1'-0"

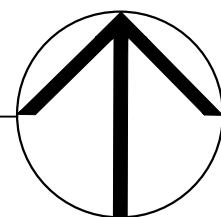

UNIT A

WALL LEGEND

(E) 2X WALL TO REMAIN

(N) 2X4 WD. STUD @ 16" O.C.
2X6 WD. (PLUMBING WALL)

1-STORY ADD.

DESIGNER
VICTOR GONZALEZ

PROPOSED 1-STORY ADD. AND
PATIO COVER TO
(E) 1-STORY S.F.D.

5962 RAND ST. BUENA PK. CA. 90621
IRAI & SANDRA VERDUZCO/OWNERS
(323) 371-7769

DRAFTING
RESIDENTIAL & COMMERCIAL



15545 BELLFLOWER BLVD., SUITE G
BELLFLOWER, CA 90706
PHONE (562) 928-5444 victor_drafting@yahoo.com
DESIGNER: VICTOR GONZALEZ

DRAWN V.G.-S.R.
DATE 05.30.25
SCALE AS SHOWN
SHEET A-2.1
OF SHEETS



DRAFTING DESIGN


15545 BELLFLOWER BLVD. SUITE G
BELLFLOWER, CA 90706
PHONE (562) 928-5444 victor_drafting@yahoo.com
DESIGNER: VICTOR GONZALEZ

PROPOSED 1-STORY ADD. AND PATIO COVER TO (E)1-STORY S.F.D.

5962 RAND ST. BUENA PARK, CA 90621
IRAI S & SANDRA VERDUZCO/OWNERS
(323)371-7769

DESIGNER
VICTOR GONZALEZ

DRAWN V.G.-S.R.
DATE 06.27.25
SCALE AS SHOWN
SHEET A-2.2
OF SHEETS

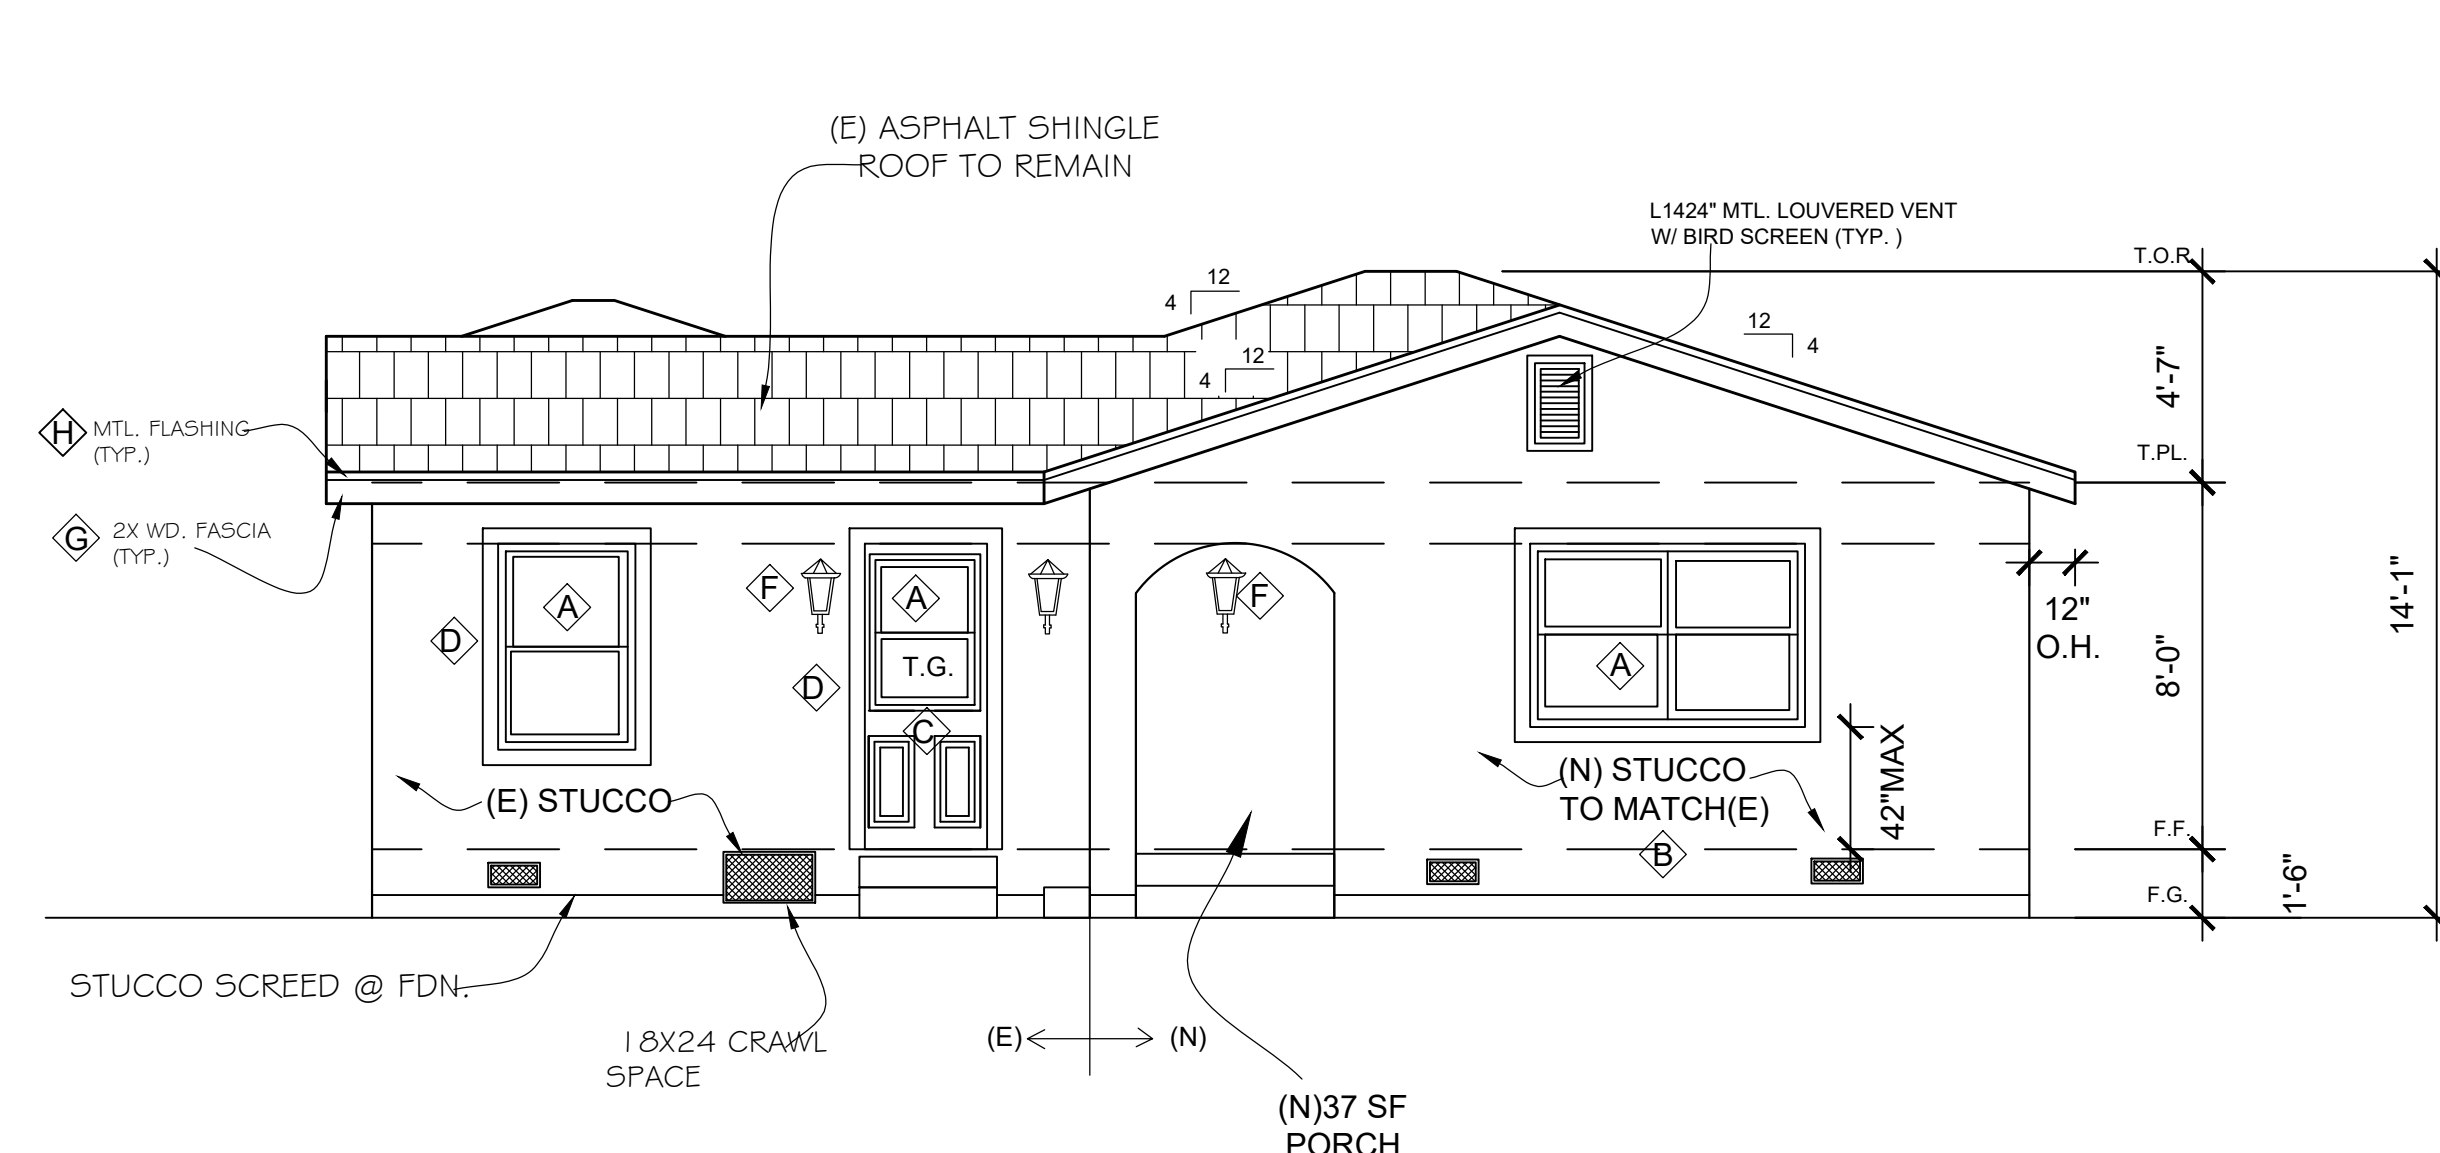

(E)&(P) EAST ELEVATION

SC. 1/4" = 1'-0"


ROOF VENT CALCULATIONS(NFVA):				
FLOOR AREA	363 SF	÷ 150	= 2.42	X 144 = 349 in ²
L1424	168 in ²	X 1	"	= 168 in ²
6x14	40 in ²	X 6	"	= 240 in ²
LR24H	97 in ²	X 2	"	= 194 in ²
602 in ² > 349 O.K.				

FLOOR VENT CALCULATIONS(NFVA):				
FLOOR AREA	363	÷ 150	= 2.42	X 144 = 349 in ²
PROVIDED				
4 X14	56 in ²	56 x 4	PIECES	= 224 in ²
18 X 24	432 in ²	432 X 1	PIECES	= 432 in ²
656 > 349				

NOTE ALL ATTIC VENTS SHALL HAVE
CORROSION-RESISTANT WIRE MESH OR
OTHER APPROVED A MAT. W/1/16 IN MIN. &
1/4-IN MAX. OPENING

NOTE : USE 2 LAYERS OF GRADE D PAPER BARRIER
FOR STUCCO APPLIED OVER WOOD BASED SHEATHING
NOTE : WEEP SCREED FOR EXTERIOR PLASTER SHALL BE
PLACED 4" MIN. ABOVE THE EARTH OR 2" ABOVE PAVED
AREAS
NOTE : TOP OF FOOTING SHALL BE LOCATED 8" MIN. ABOVE
EXPOSED EARTH(UNLESS WD. FRAMING MEMBERS
ARE OF NATURALLY DURABLE OR PRESERVATIVE
TREATED WOOD)


NOTE : A MIN. 26 GA. CORROSION-RESISTANT OR PLASTIC
WEEP SCREED WITH A MIN. VERT. FLANGE OF 3 1/2" SHALL BE PROVIDED AT OR BELOW
FOUNDATION PLATE LINE ON EXTERIOR STUD WALLS. SCREED SHALL BE A MIN OF 4"
ABOVE EARTH OR 2" ABOVE PAVED AREAS AND SHALL BE OF A TYPE THAT WILL ALLOW
TRAPPED WATER TO RAIN TO THE EXTERIOR OF BUILDING(R703.7.2.1 CRC)

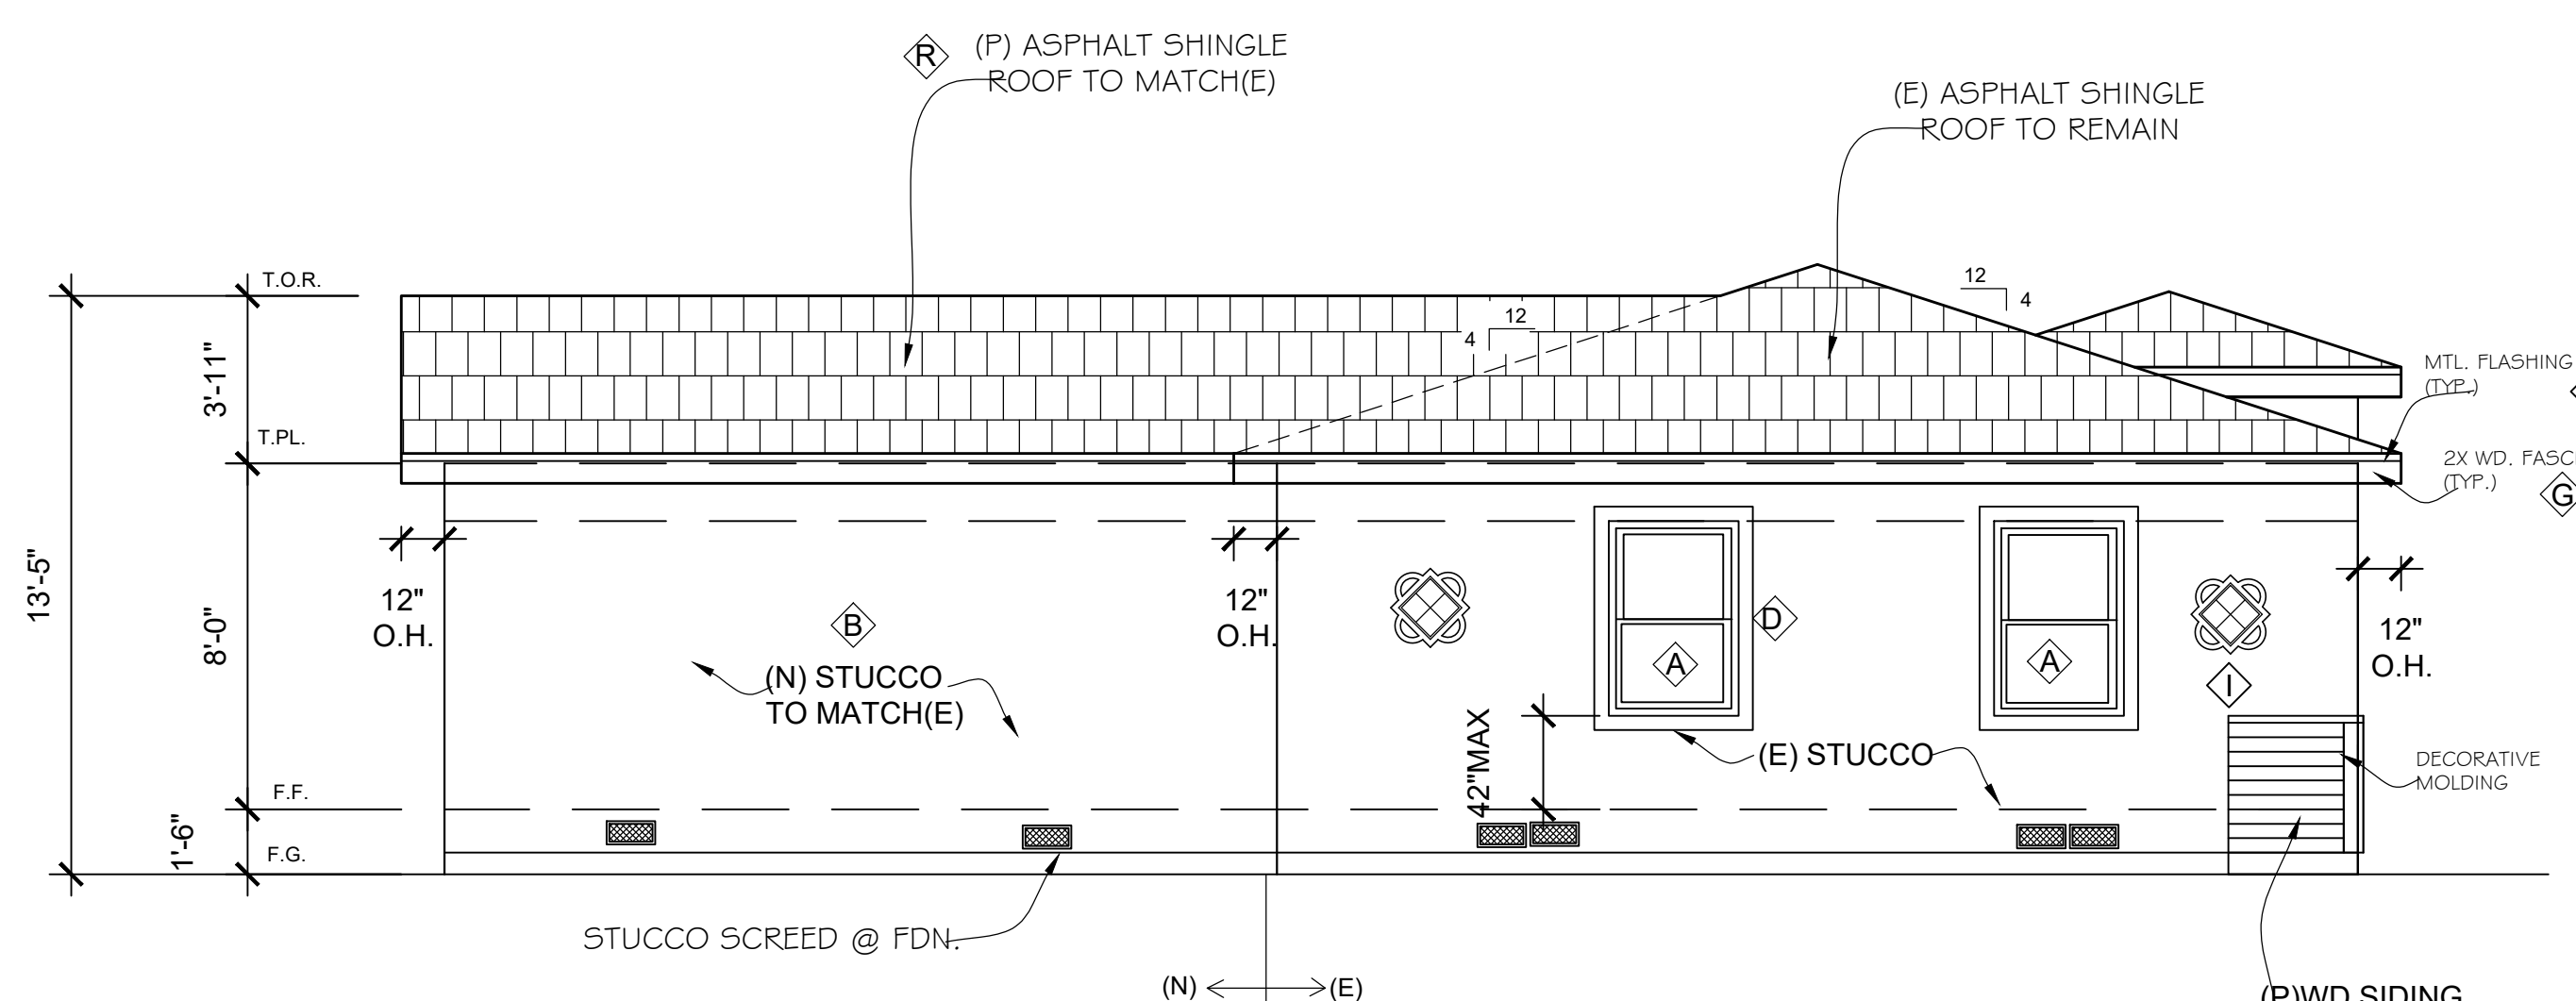

(E)&(P) NORTH ELEVATION


SC. 1/4" = 1'-0"

MATERIAL FINISHES	COLOR FIN.
Ⓡ ASPHALT SHINGLE ROOF TO REMAIN BY MALARKEY OR EQUAL	LIGHT GRAY
ⓐ WINDOWS BY MILGARD TUSCANY SERIES FIX / S.HUNG	WHITE
ⓑ STUCCO BY LA HABRA OR SIM	LIGHT GRAY
ⓓ DOOR : BY OWNER	WHITE
ⓔ WINDOWS AND DOOR WD. TRIM	WHITE
ⓕ WD. SHUTTERS	BLACK
ⓕ LIGHT OUTSIDE : QUITZEL BY LOWES OR EQUAL	BLACK
ⓖ WD. FASCIA	WHITE
ⓗ METAL FLASHING	BLACK
ⓓ DECORATIVE MOULDING	RED/BLACK

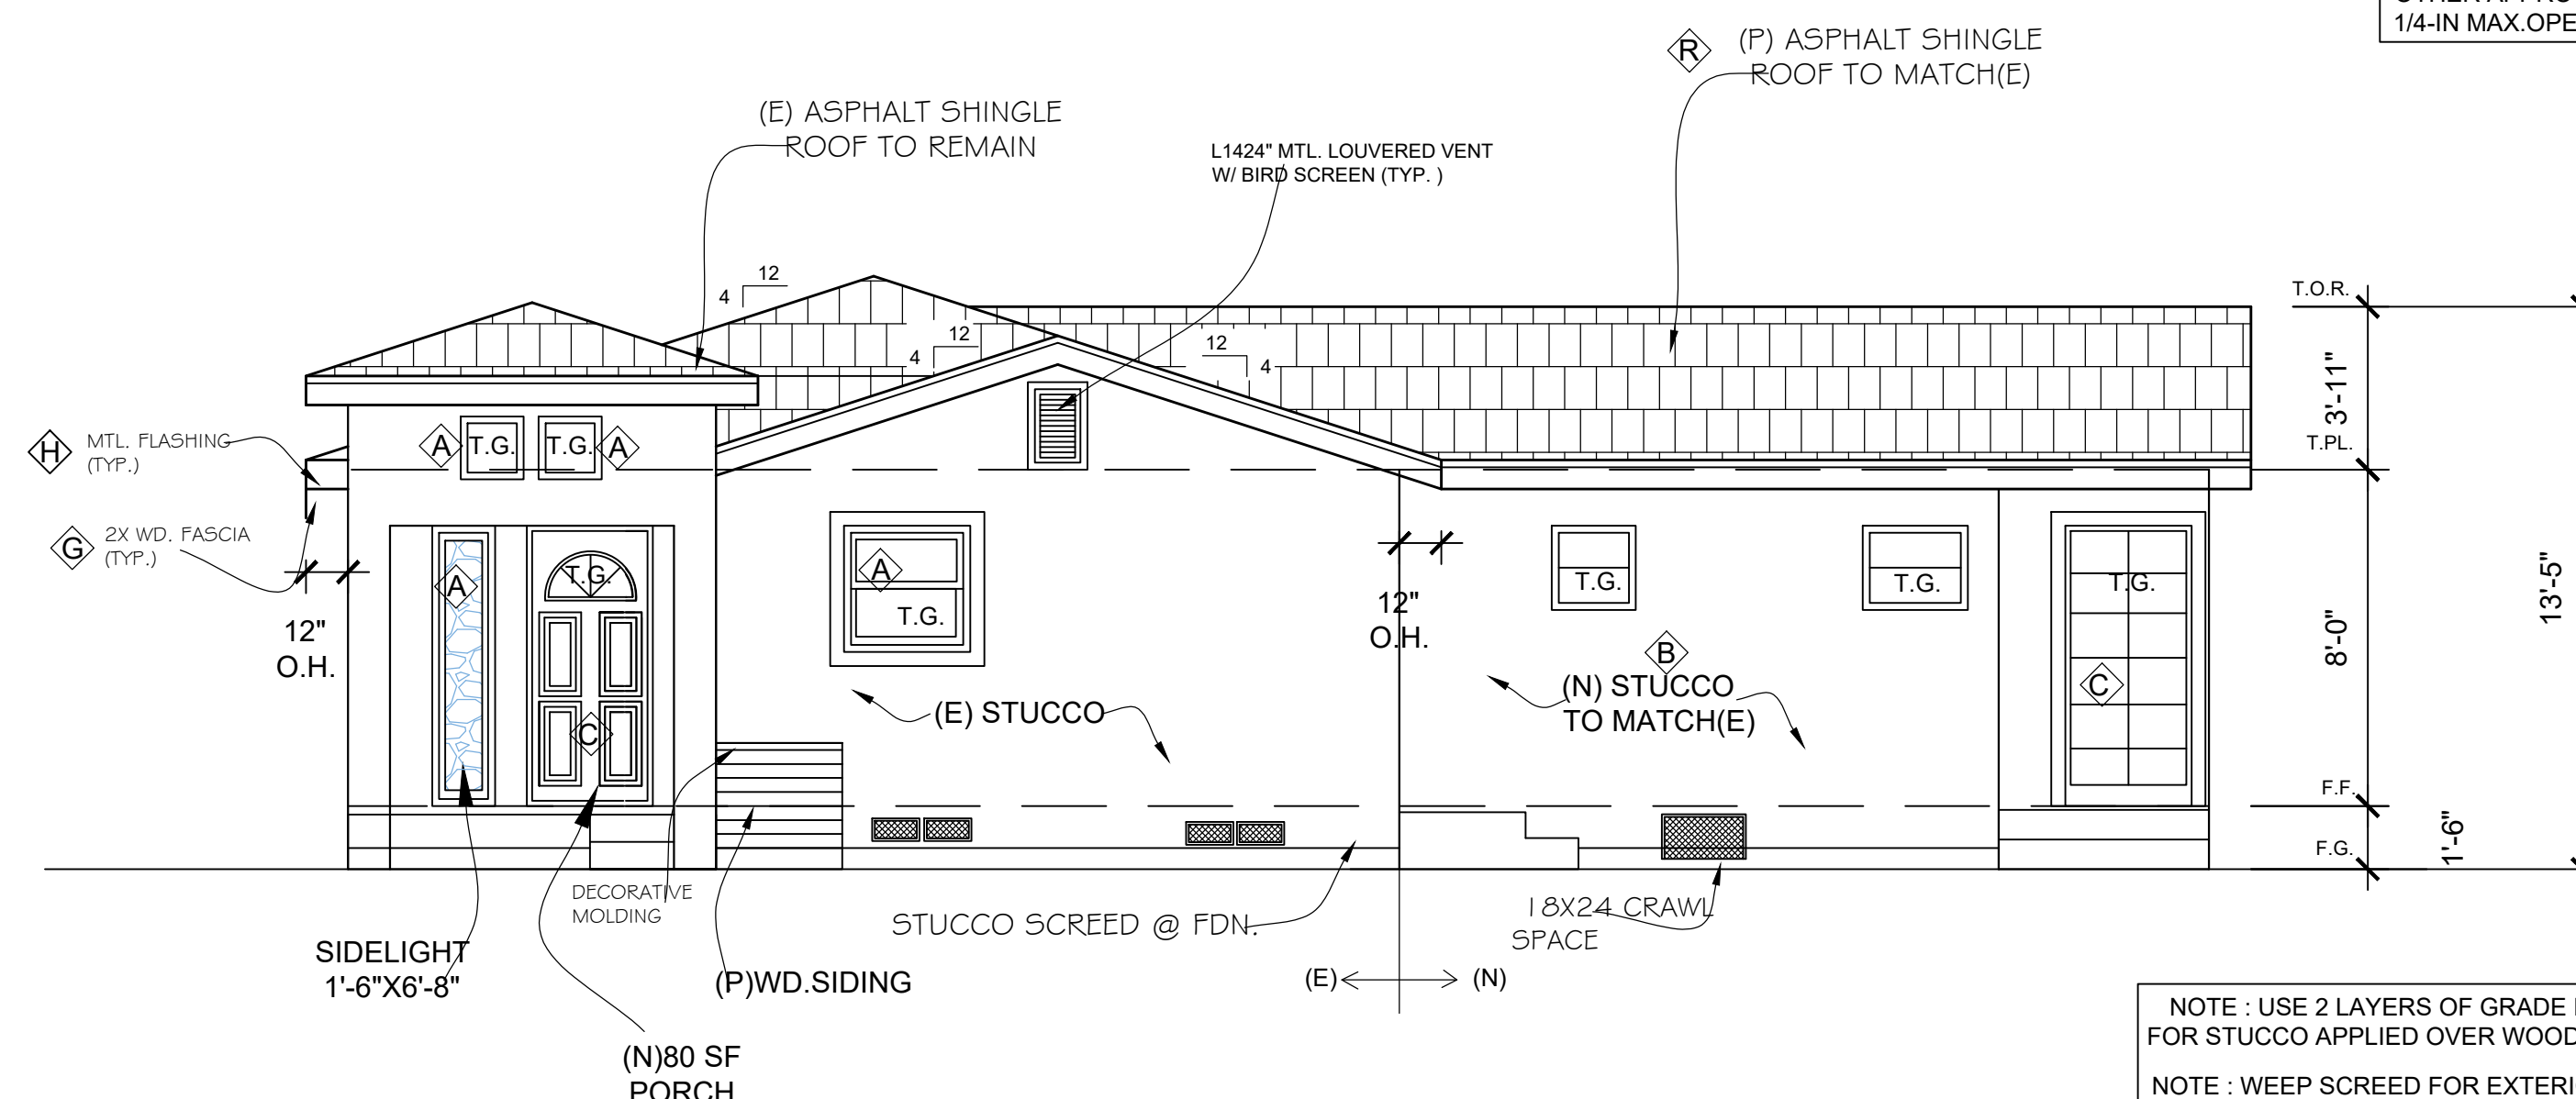

(E)&(P) SOUTH ELEVATION

SC. 1/4" = 1'-0"

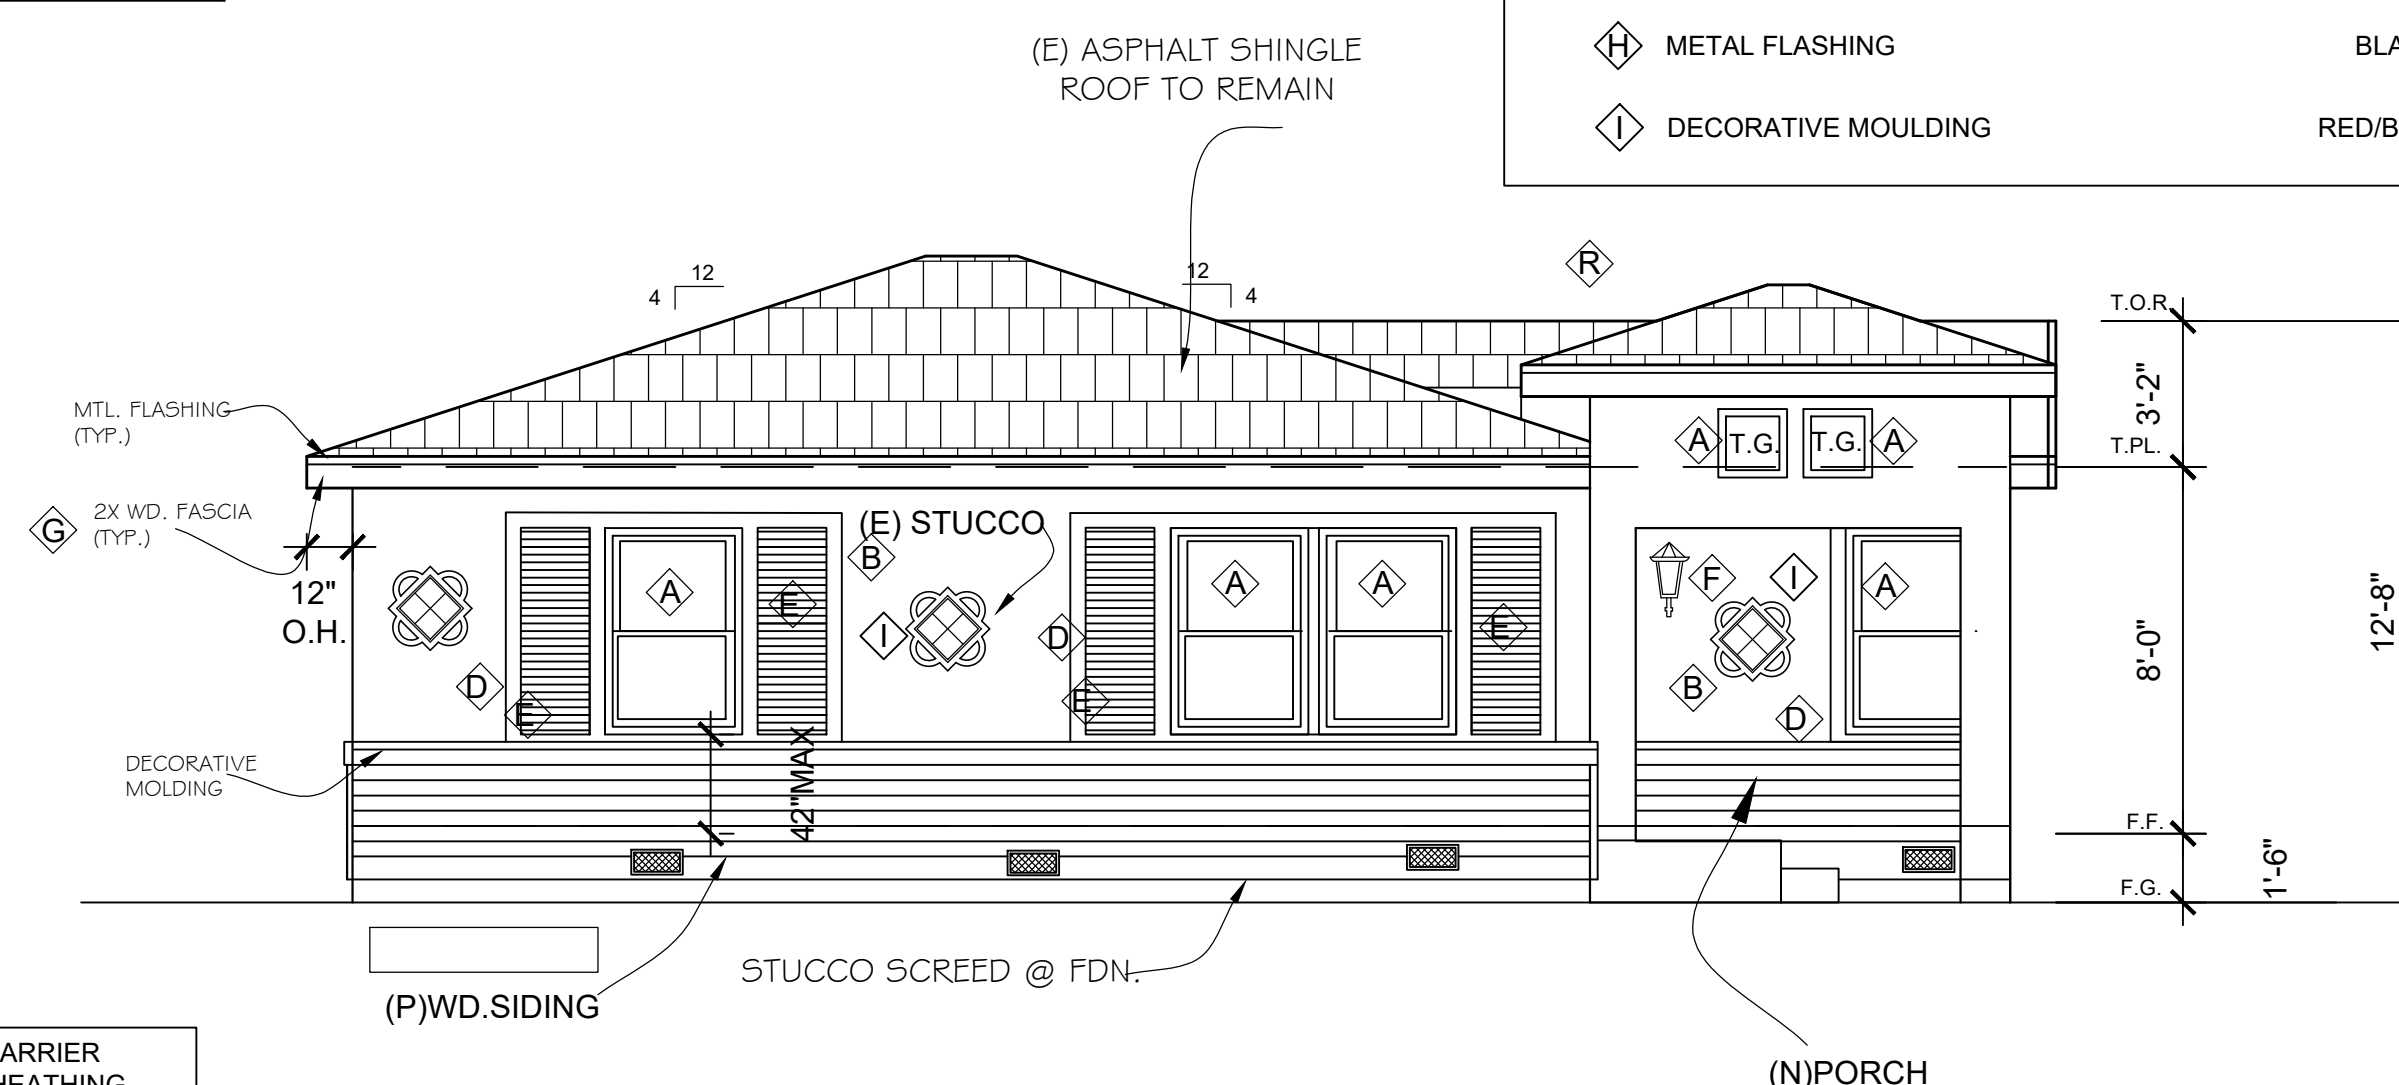

(P)WEST ELEVATION

SC. 1/4" = 1'-0"

UNIT A
1-STORY ADD.



VICINITY MAP



ZONING ADMINISTRATOR

Thursday, July 17, 2025 – 8:30 a.m.

SITE PLAN REVIEW NO. SP-25-9

5962 RAND STREET

APN: 066-203-24