



260 Salem Street Project, Andover, Mass Building Permit Joao Bata, JBG Contracting 857.251.5404 Structural Engineer Larry Olen, 978.352.8318 Designed by LF studio 978.618.9886 / 7 May, 2021

Main Level Layout
 Scale 1/4" = 1'-0"

ANDERSEN WINDOWS
 1000 Main Street, Andover, MA 01810
 978.686.1111
 Main Level Window Head 8'-0" x 7'-0" Rough Opening 8'-0" x 7'-0"
 Upper Level Window Head 8'-0" x 7'-0" Rough Opening 8'-0" x 7'-0"

Window Schedule	Type	Model #	Room	Unit	RO Width / Ht	Head / Sill
A	TP-2556		Gr		34'-0" x 14'-0"	8'-0" x 7'-0"
A-1	TP-2556-2P		Gr		68'-0" x 14'-0"	8'-0" x 7'-0"
A-2	TP-2556-3P		Gr		102'-0" x 14'-0"	8'-0" x 7'-0"
B	TP-2556		Br		26'-0" x 14'-0"	8'-0" x 7'-0"
B-1	TP-2556-2P		Br		52'-0" x 14'-0"	8'-0" x 7'-0"
B-2	TP-2556-3P		Br		78'-0" x 14'-0"	8'-0" x 7'-0"
C	TP-2556		Br		34'-0" x 14'-0"	8'-0" x 7'-0"
C-1	TP-2556-2P		Br		68'-0" x 14'-0"	8'-0" x 7'-0"
C-2	TP-2556-3P		Br		102'-0" x 14'-0"	8'-0" x 7'-0"
D	AW-211		Misc.		28'-0" x 14'-0"	8'-0" x 7'-0"
E	C-13		Br		34'-0" x 14'-0"	8'-0" x 7'-0"
F	TP-2556		Br		26'-0" x 14'-0"	8'-0" x 7'-0"
F-1	TP-2556-2P		Br		52'-0" x 14'-0"	8'-0" x 7'-0"
F-2	TP-2556-3P		Br		78'-0" x 14'-0"	8'-0" x 7'-0"
G	TP-2556		Misc.		28'-0" x 14'-0"	8'-0" x 7'-0"
G-1	TP-2556-2P		Misc.		56'-0" x 14'-0"	8'-0" x 7'-0"
G-2	TP-2556-3P		Misc.		84'-0" x 14'-0"	8'-0" x 7'-0"

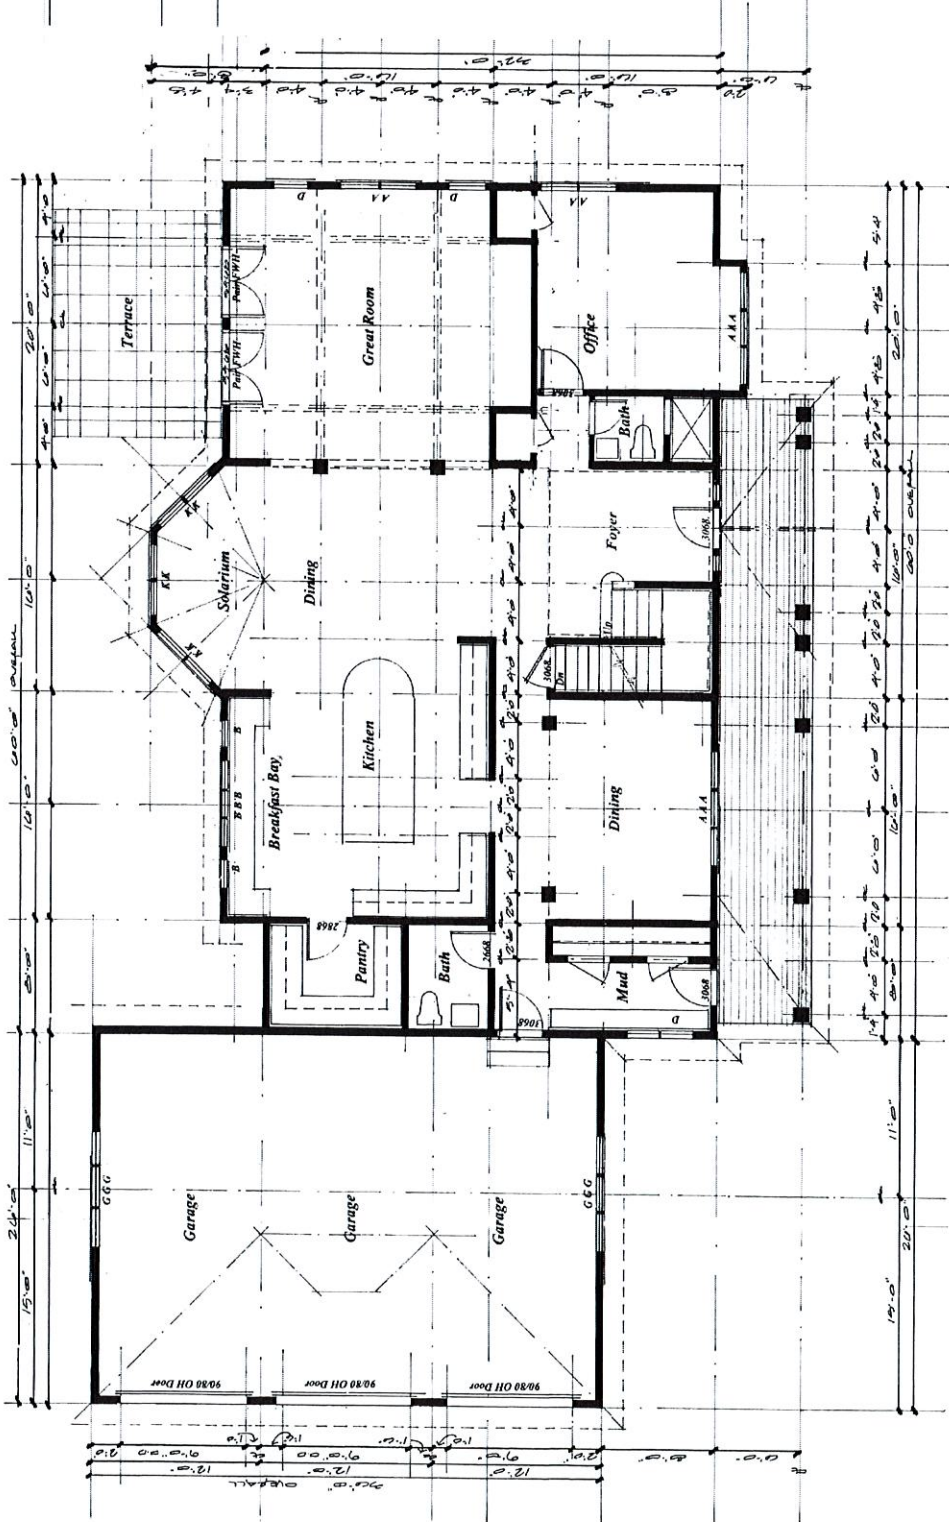

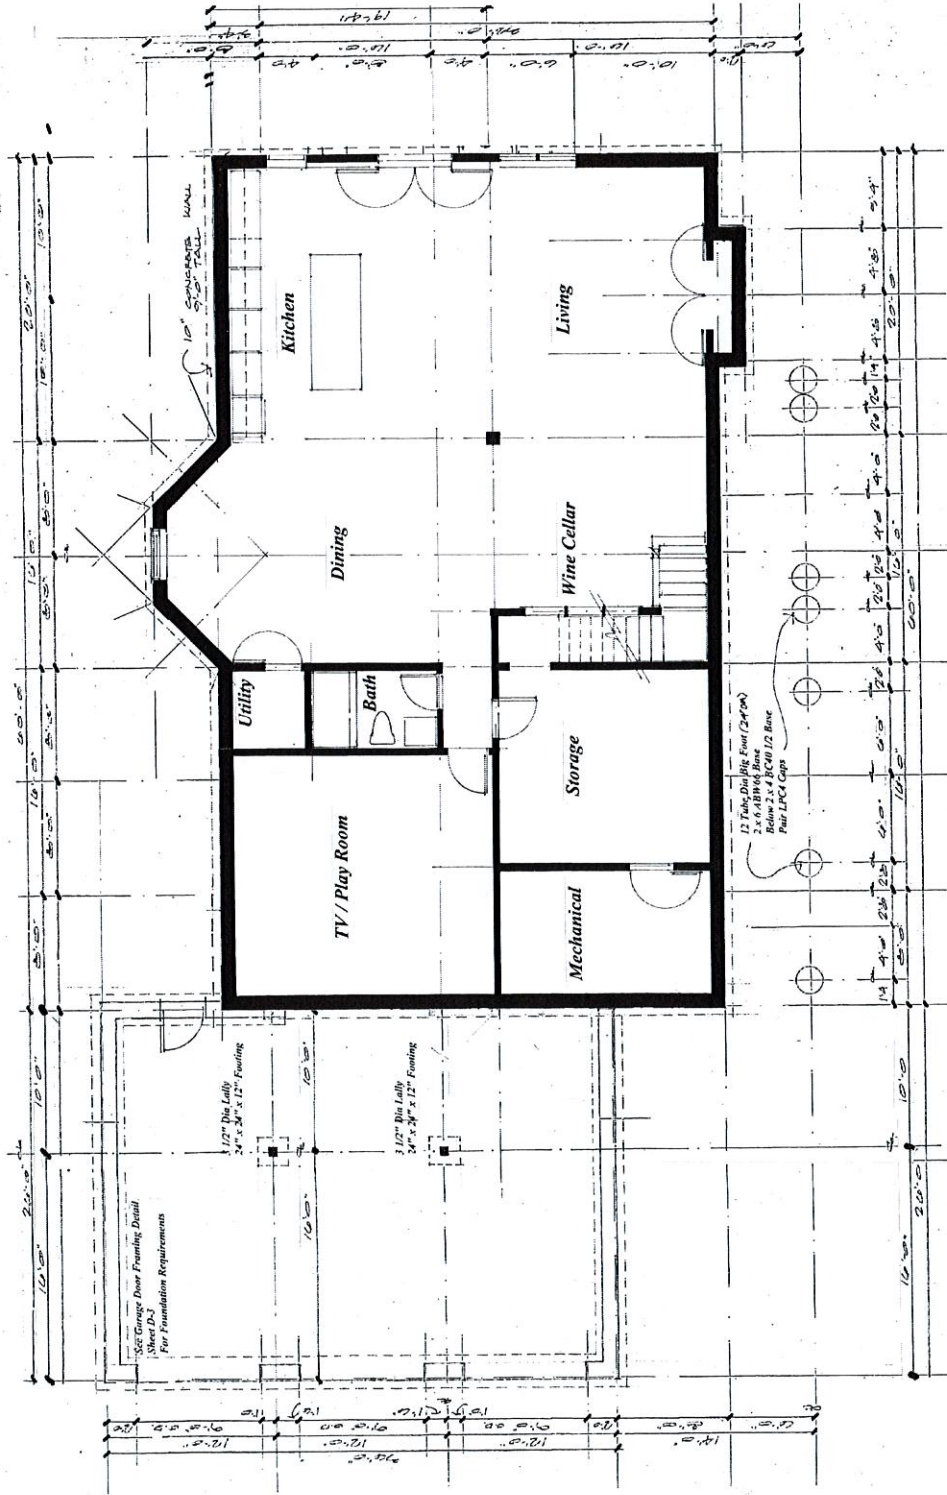

A2

Building Permit

260 Salem Street Project, Andover, Mass

Anderson Architects 305.564.4127 / 154 Main Street, Everett, MA 03149

Structural Engineer: Larry Ogden, 978.352.8318

Designed by LF studio 978.618.9986, 18 June 2023

Upper Level As-Built Layout

Scale 1/4" = 1'-0"

