





Braemar Park Overall Trail System



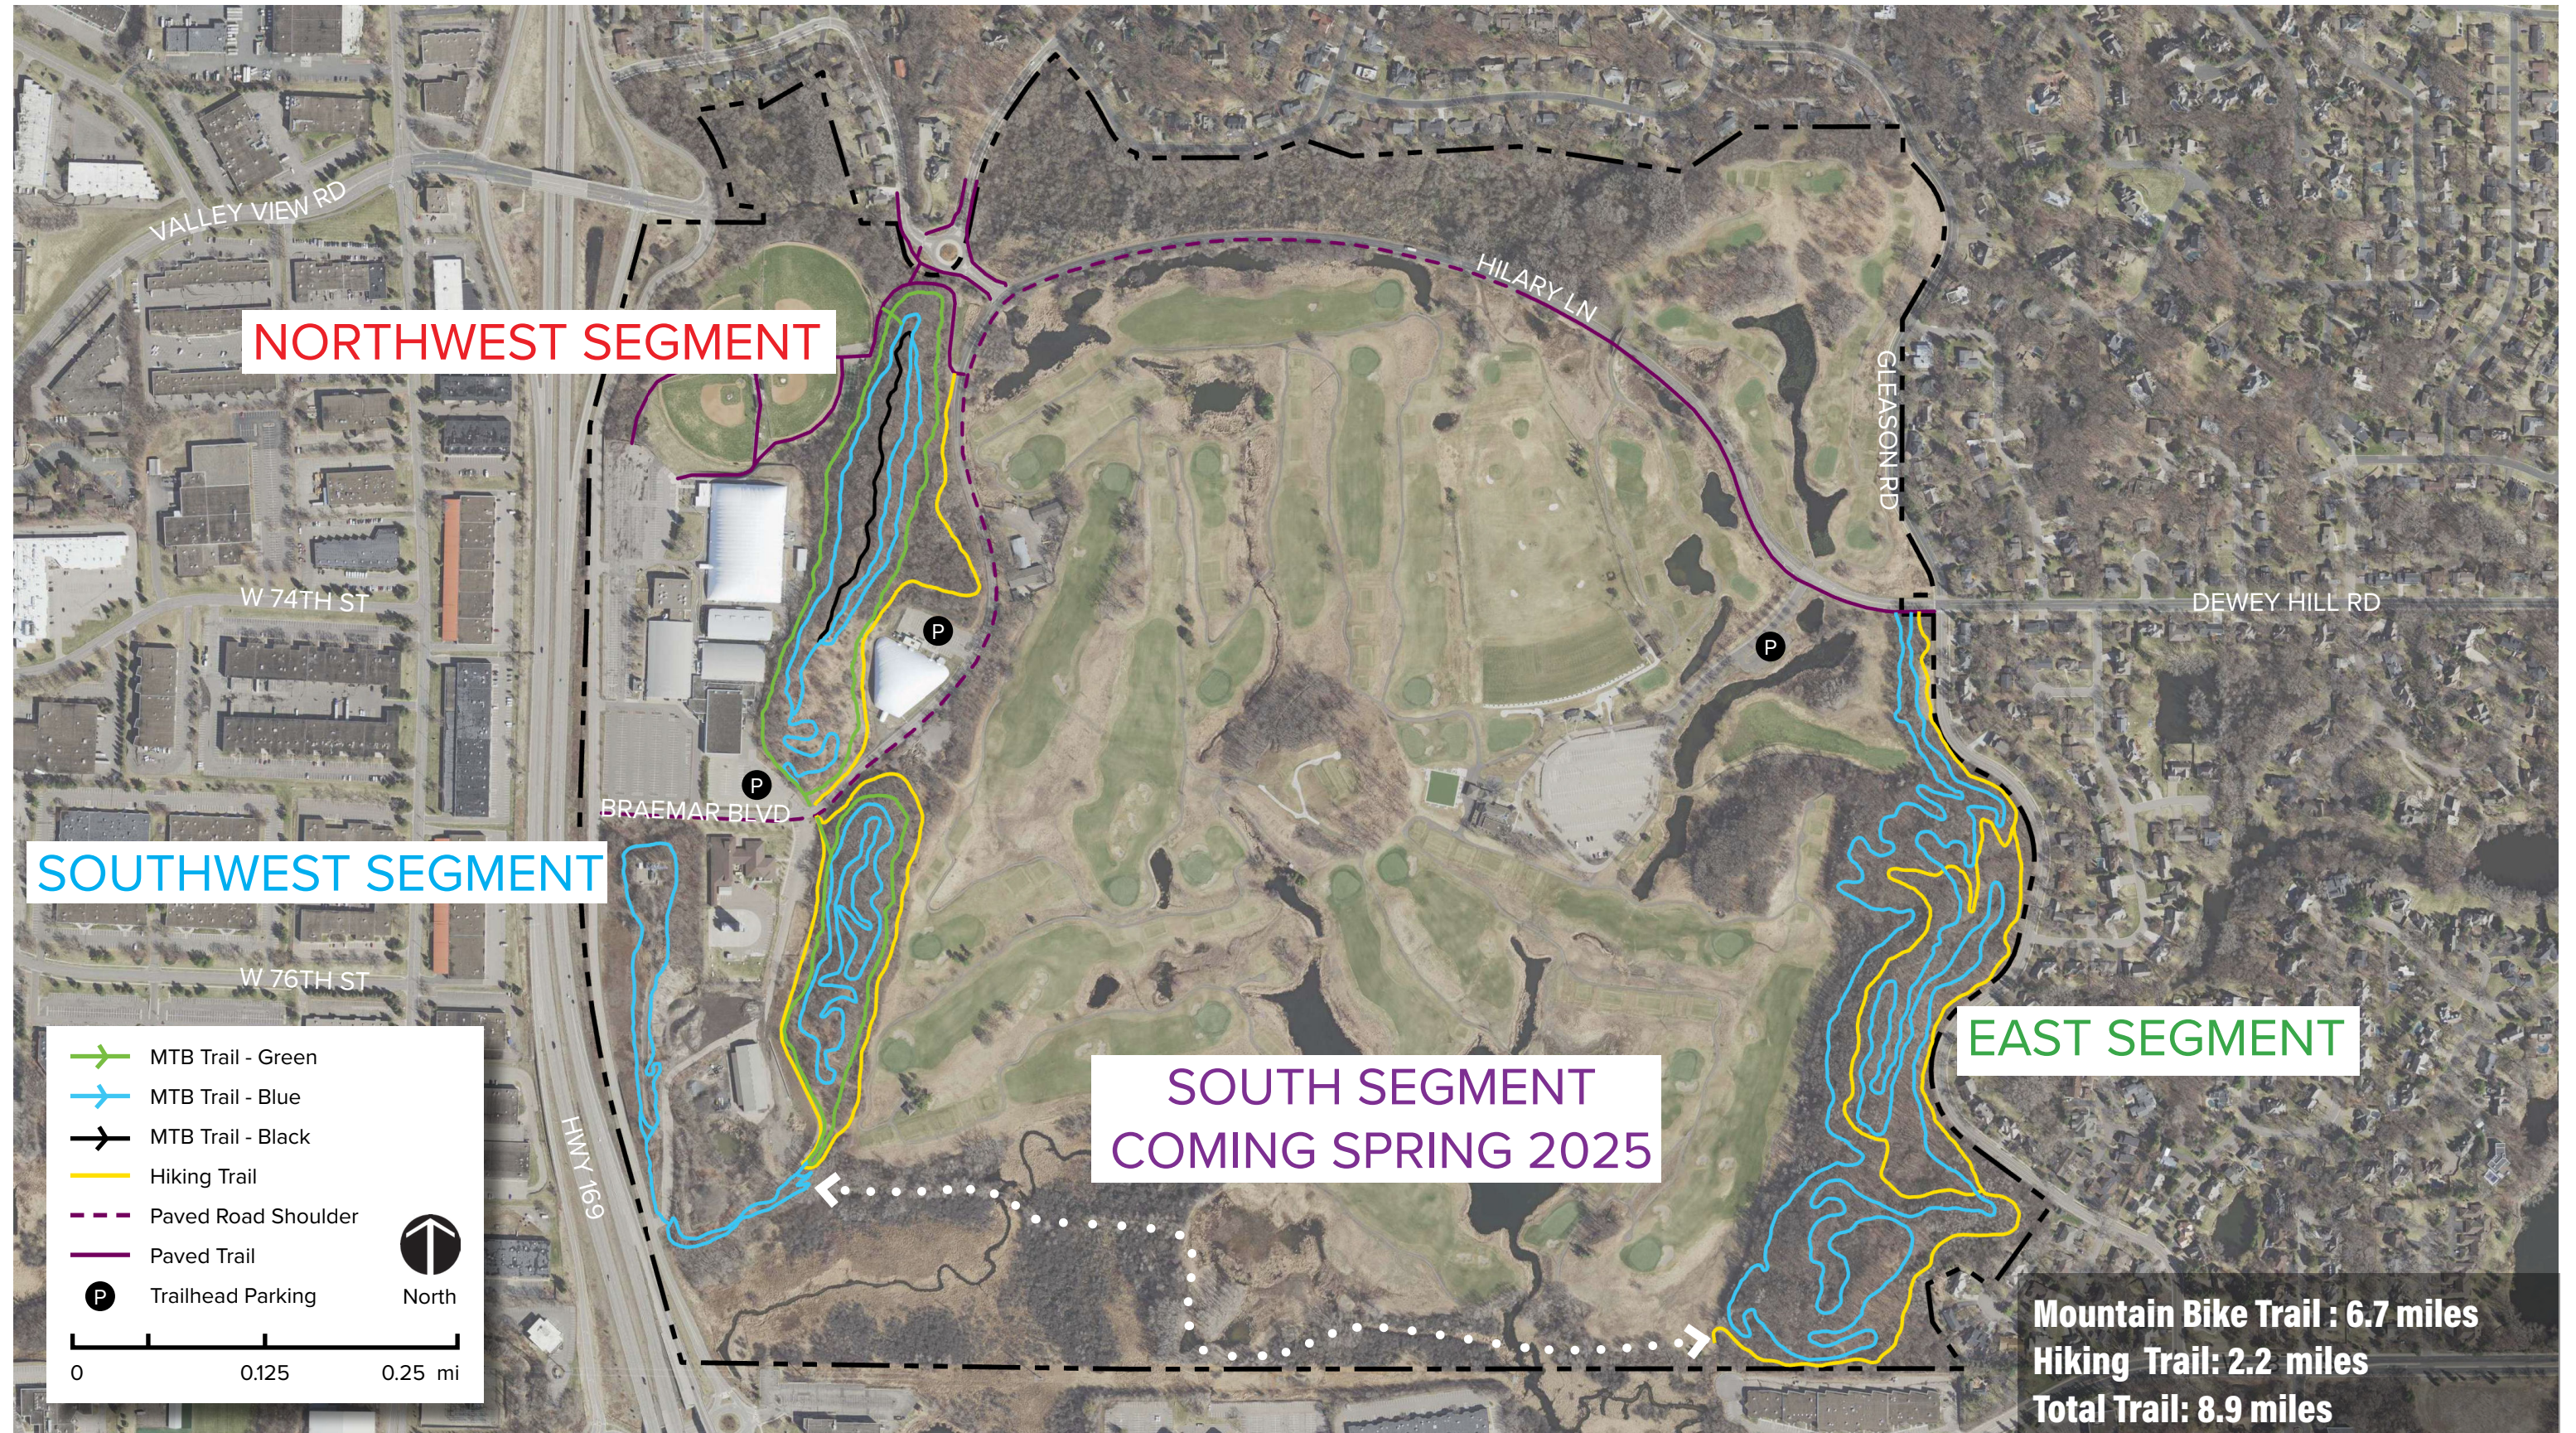


Braemar Park Northwest Segment Trails

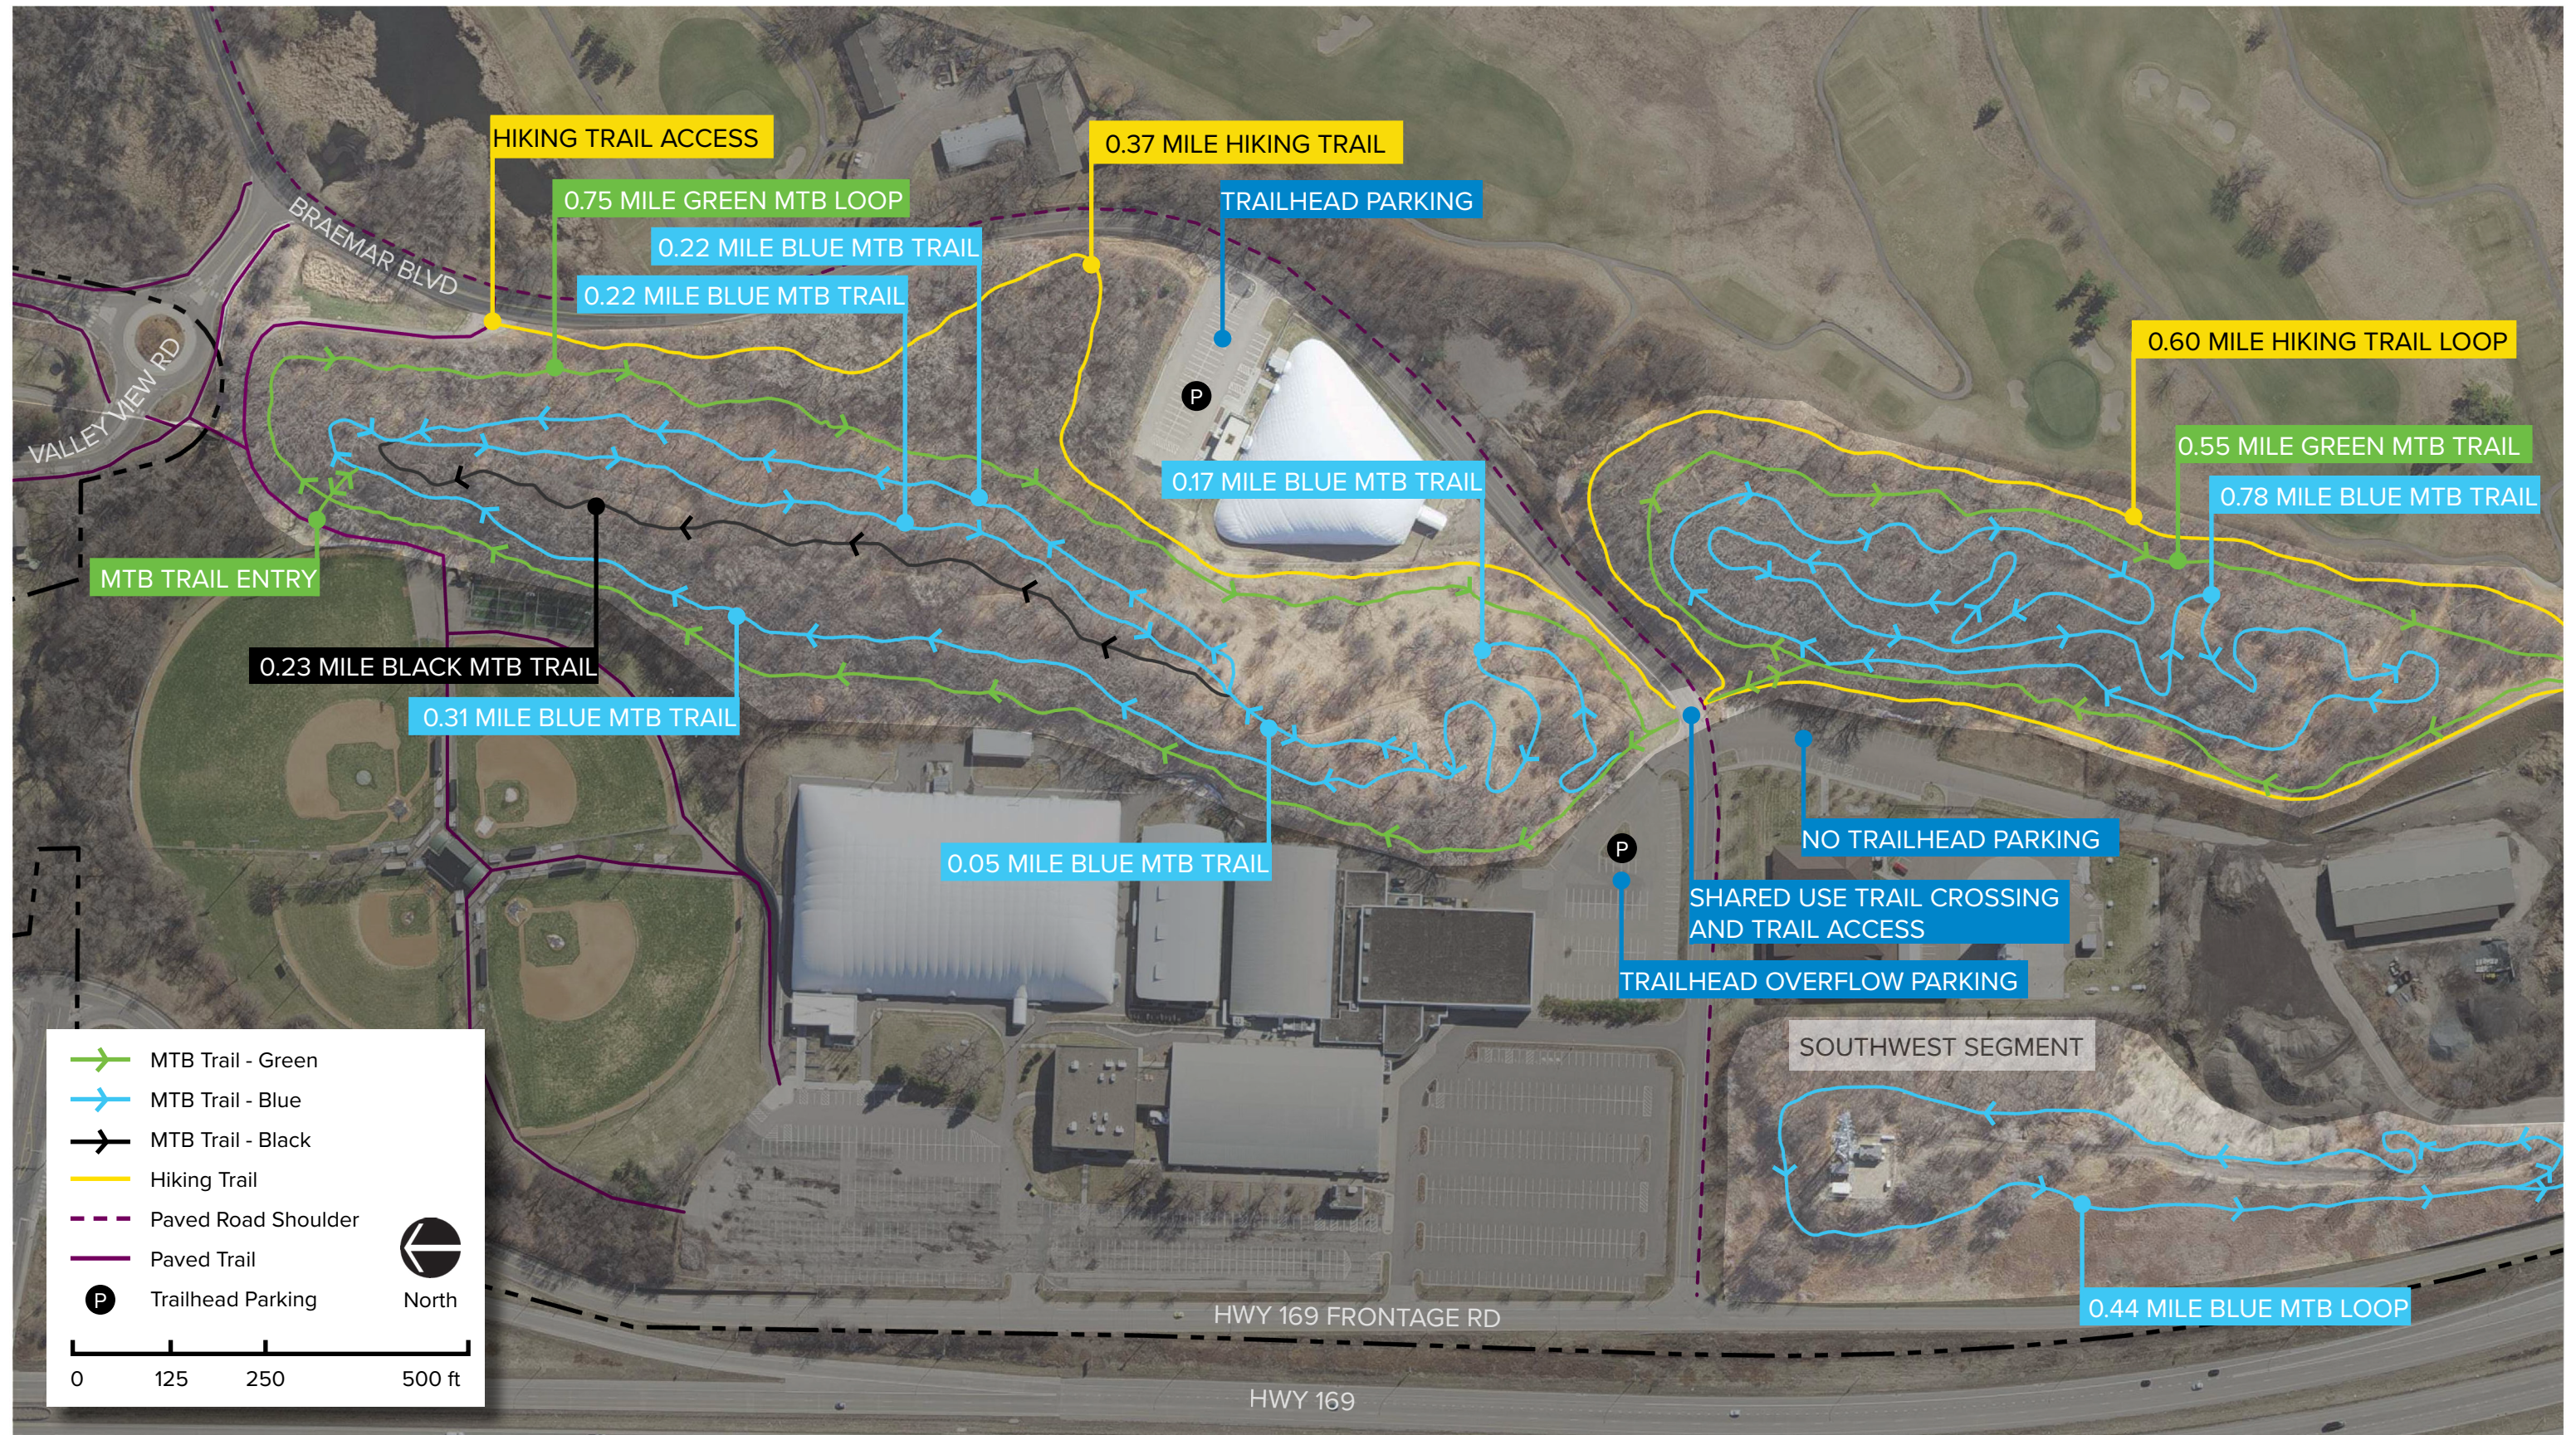



Braemar Park Southwest Segment Trails

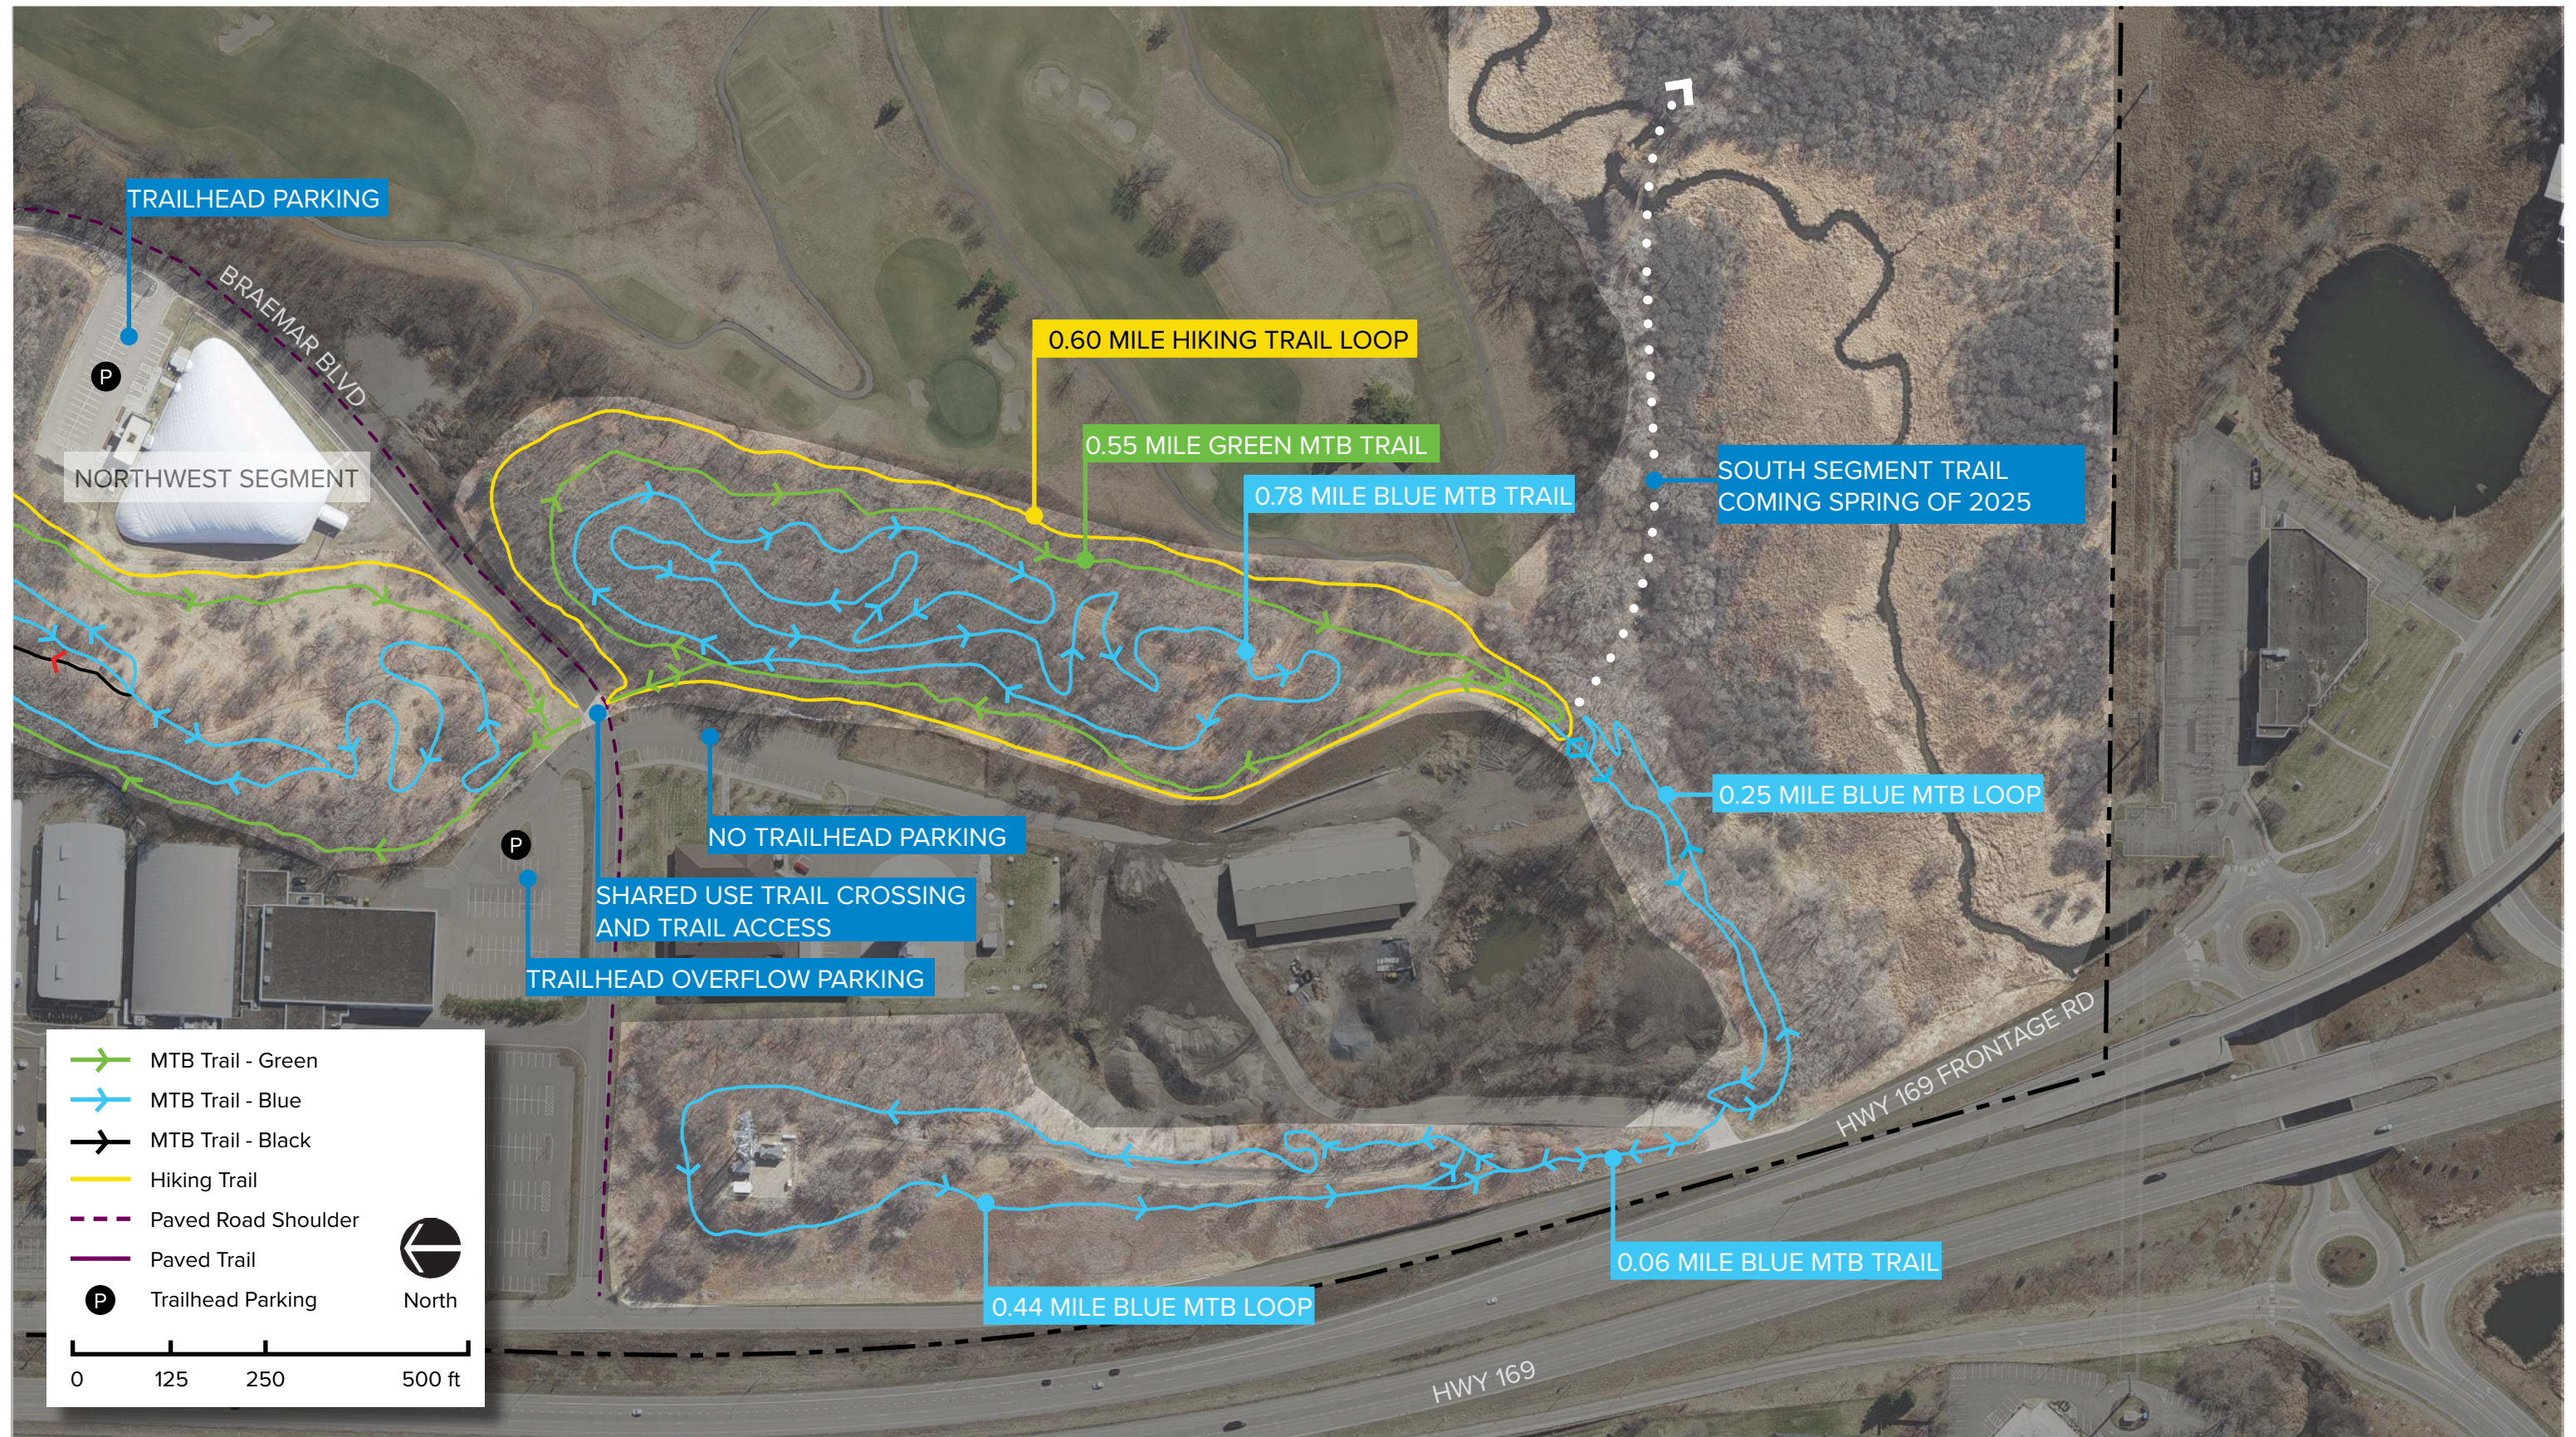



Braemar Park East Segment Trails

