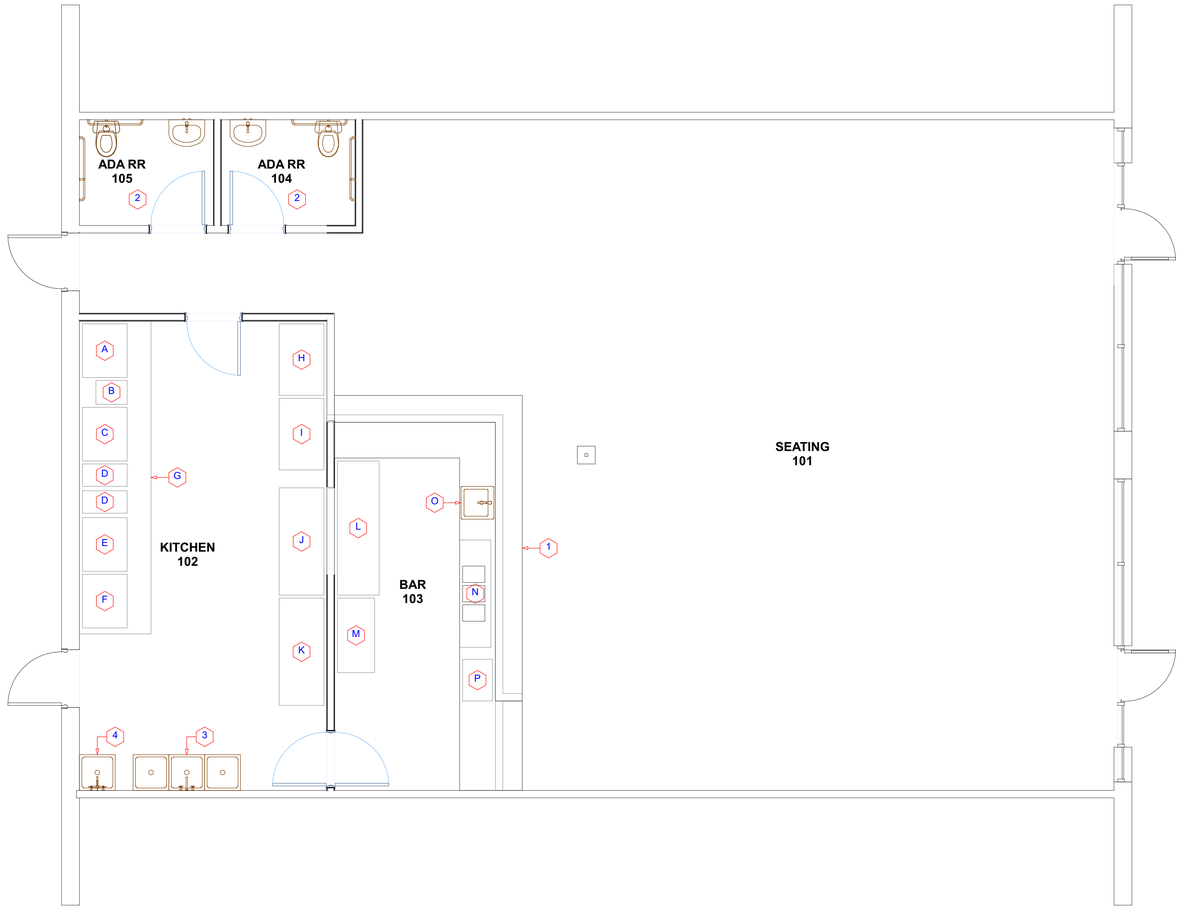

DRAWN BY:

CHECKED BY:

REVISIONS:

No.	DESCRIPTION	DATE

ISSUE RECORD:

No.	DESCRIPTION	DATE

SCALE:

SHEET CONTENTS:

PROJECT NO.:

DATE:

DRAWING NO.: