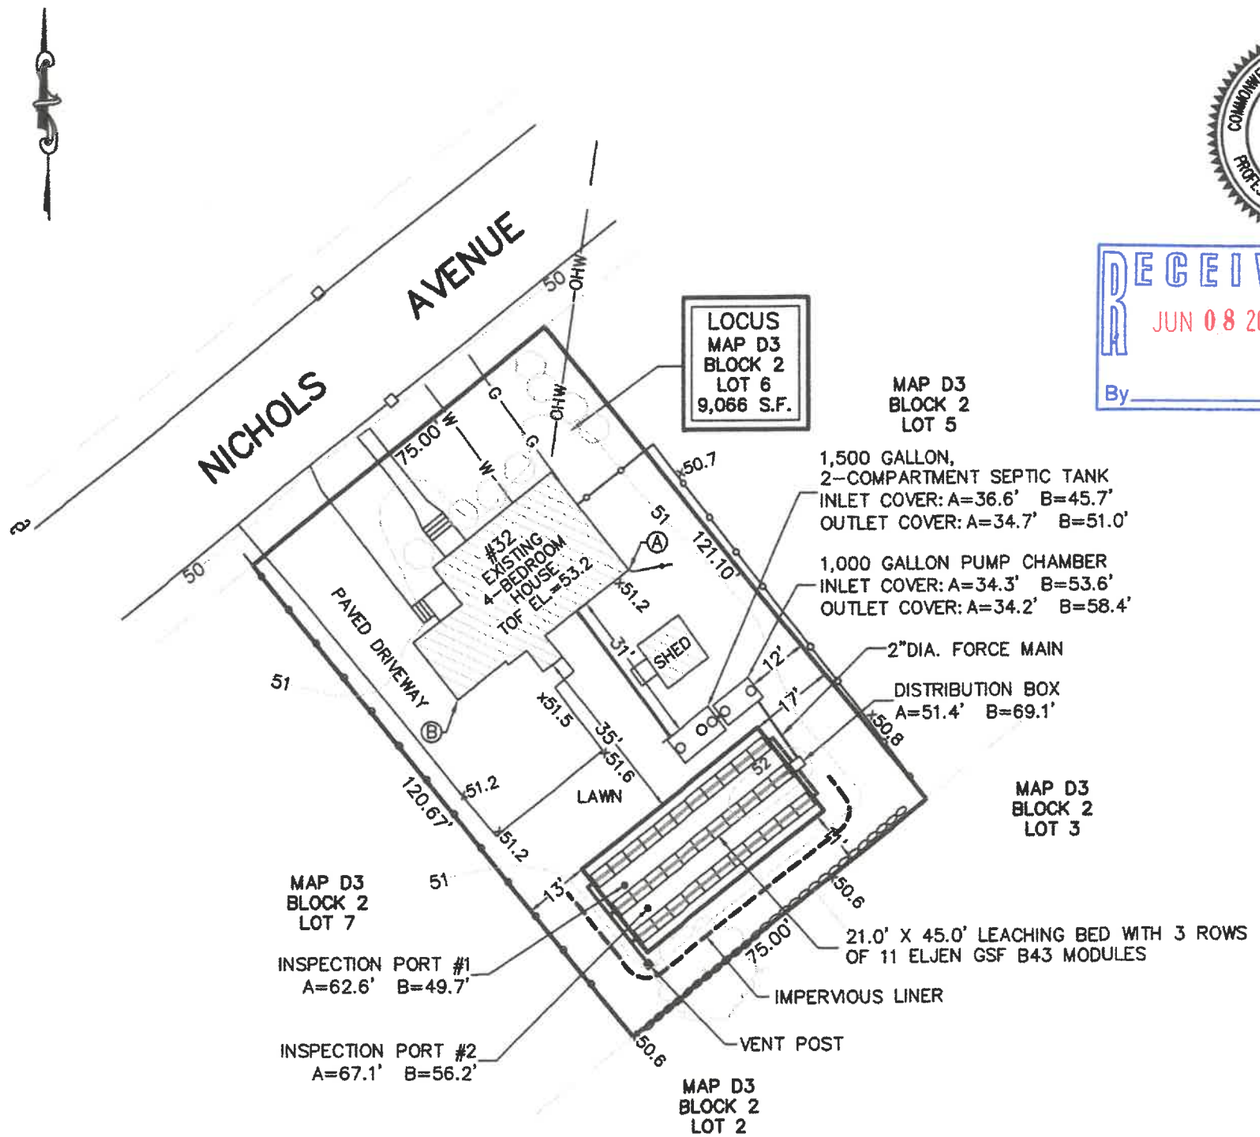


COMMONWEALTH OF MASSACHUSETTS
GEORGE R. COLLINS
CIVIL
NO. 41631
REGISTERED
PROFESSIONAL ENGINEER

RECEIVED
JUN 08 2026
By

I, GEORGE R. COLLINS, P.E. OF COLLINS ENGINEERING GROUP HEREBY CERTIFY THAT THE SUBSURFACE DISPOSAL SYSTEM HAS BEEN CONSTRUCTED IN COMPLIANCE WITH 310 CMR 15.000, THE APPROVED DESIGN PLANS AND ALL LOCAL REQUIREMENTS AND THAT ANY CHANGES TO THE DESIGN PLANS HAVE BEEN REFLECTED ON THE AS-BUILT WHICH IS HEREBY BEING SUBMITTED TO THE BOARD OF HEALTH.

6-2-26

GEORGE R. COLLINS, P.E. *DATE*

ELEVATION SCHEDULE:

DESCRIPTION	DESIGN	AS-BUILT
4" INV. AT HOUSE	49.7	49.9
4" INV. AT SEPTIC TANK (IN)	48.80	49.07
4" INV. AT SEPTIC TANK (OUT)	48.55	48.82
4" INV. AT PUMP CHAMBER (IN)	48.50	48.70
2" INV. AT PUMP CHAMBER (OUT)	48.75	48.46
2" INV. AT DIST. BOX (IN)	50.80	50.84
4" INV. AT DIST. BOX (OUT)	50.63	50.66
4" INV. AT BEGINNING OF SAS	50.58	50.61
4" INV. AT END OF SAS	50.00	50.02
ELEVATION AT BOTTOM OF SAS	49.50	49.5
GROUNDWATER ELEVATION	47.42	

REVISED: 6-2-26
PROJECT NO. 26-045-4366

DRAWING TITLE: AS-BUILT PLAN
SUBSURFACE SEWAGE DISPOSAL SYSTEM UPGRADE

PROJECT: 32 NICHOLS AVENUE
AVON, MA

CLIENT: ANNE DRINKWATER
215 GLEN CHARLIE ROAD, WAREHAM, MA 02538

COLLINS CIVIL ENGINEERING GROUP, INC.
CIVIL ENGINEERING - LAND SURVEY - L.S.P. SERVICES
225 SOUTH MAIN STREET, WEST BRIDGEWATER, MA 02379
TEL:508-580-2332 MOBILE: 617-347-1363 E-MAIL:GRCPE@AOL.COM

SCALE: 1" = 30'
DATE: 5-29-26
DRAWN BY: RJB
DESIGNED BY: SWR
CHECKED BY: GRC
APPROVED BY: GRC