47b0261374

IREDELL COUNTY HEALTH DEPARTMENT

STATE[illegible]-878-5305 MOORESVILLE 704-664-5281

IMPROVEMENT PERMIT / CERTIFICATE OF COMPLETION / [illegible]ERATION PERMIT / EXISTING SYSTEM INSPECTION

PROPERTY DESCRIPTION NO. 17198 DATE 11/22/93 TAX MAP NO. 4G-A-14B Watershed: ☑ Yes ☐ No

OWNER OR CONTRACTOR THOMAS + SHARON TRAYLOR PHONE: Business _____ Home 528-9826

ADDRESS Rt 1 Box 446-A TROUTMAN, NC.

LOCATION WEATHERS CRK, 1.5 MILE ON ® FROM STATESVILLE RD. TO END DRIVEWAY

SUBDIVISION N/A BLOCK / SECTION N/A LOT N/A LOT AREA ~ 2 AC SITE CLASS. P DESIGN FLOW 360 L.T.A.R. .25 - .3

Septic Tank: 1000 Gallons; STB _____ Date _____

Pump Tank: _____ Gallons; PT _____ Date _____

Pump Make: _____ Model _____ Serial No. _____

Nitrification Field: No Fields 1 Square Feet 1200 Linear Feet 400

No Lines 3 X Trench Width 3' Max Trench Bottom Depth 36" Gravel Depth 12"

☑ New System ☐ Repair System Type: I (II) III, IV, V, VI

System Description: CONV. - DIST. BOX

Repair System Description: _____

Maintenance Agreement Required: ☐ Yes ☐ No

☑ House/Mod. Home No. Bedrooms 3

☐ Mobile Home No. Bathrooms 2

☐ Business No. Employees _____

☐ Other _____

☐ Slab ☐ Crawl Space ☐ Basement w/plumbing ☐ Basement wo/plumbing

Water Supply: ☑ Individual ☐ Community ☐ Public

Comments:

Comments:

INITIAL SITE SKETCH

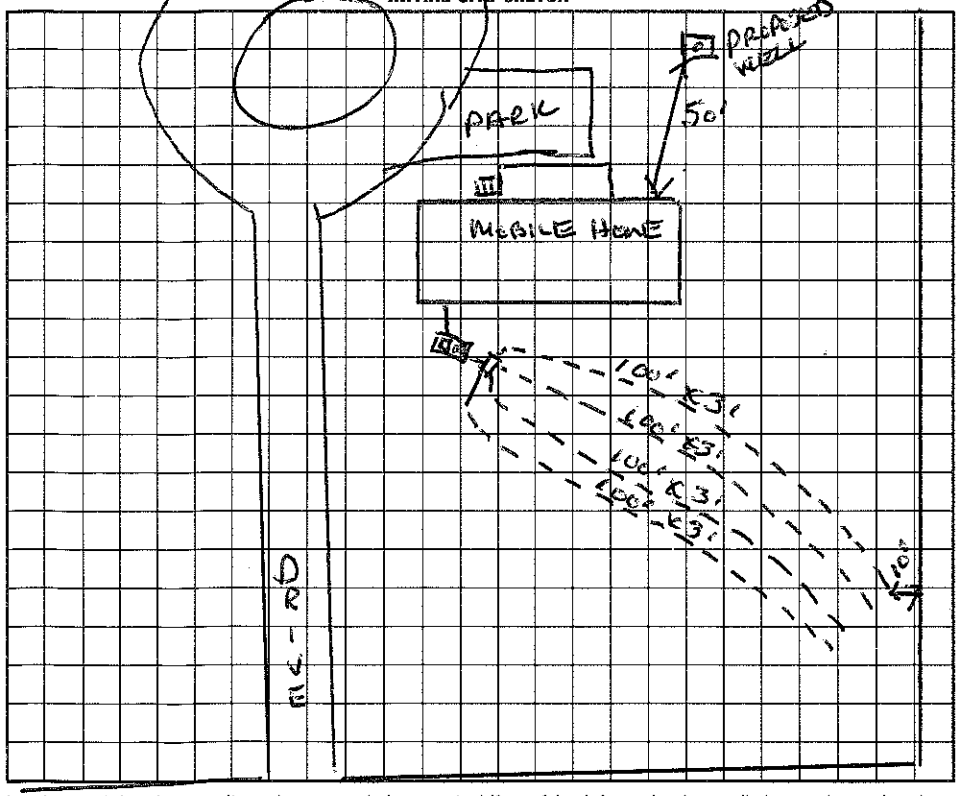

AS BUILT SKETCH

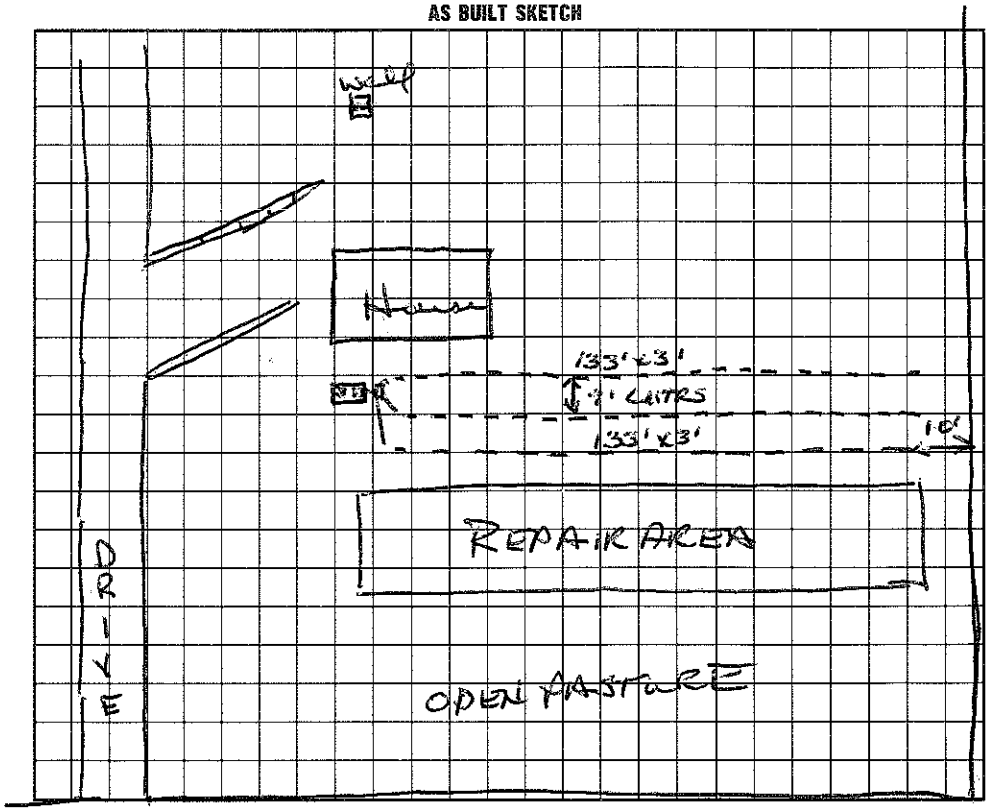

I understand that this permit can be suspended or revoked if any false information is supplied toward securing the permit/any unauthorized changes are made to the site/any unauthorized changes are made in the installation of the system. Improvement Permit is valid for 60 months from date of issuance. WEATHERS CRK RD. WEATHERS CRK RD.

Signed: Sharon J. Traylor

Improvement Permit by: Wesley Sparks RS. date 11/22/93

Existing System Inspection by: _____ date _____

Installed by: Dennis Gallihar

Certificate of Completion by: Wesley Sparks RS. date 12/14/93

Operation Permit by: _____ date _____

HEALTH DEPT. COPY: WHITE INSPECTION COPY (FINAL): GREEN OWNER COPY (FINAL): YELLOW INSPECTION COPY (INITIAL): PINK OWNER COPY (INITIAL): GOLD